




SECS. 1 & 2 TWP 29S R. 6W, W.M.

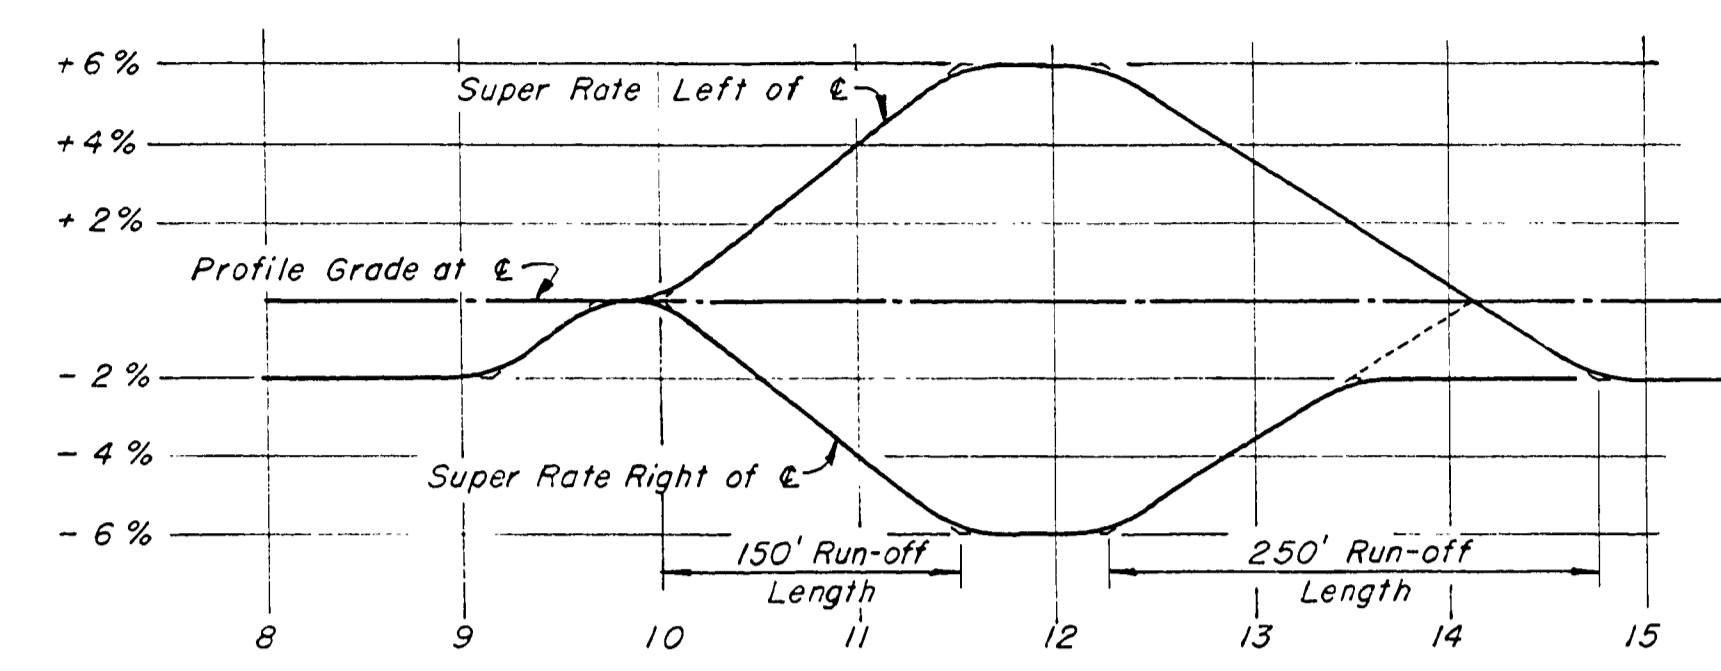

**SUPER RUN-OFF DIAGRAM**  
10° C.R.  
P.C. STA. 8+15.36

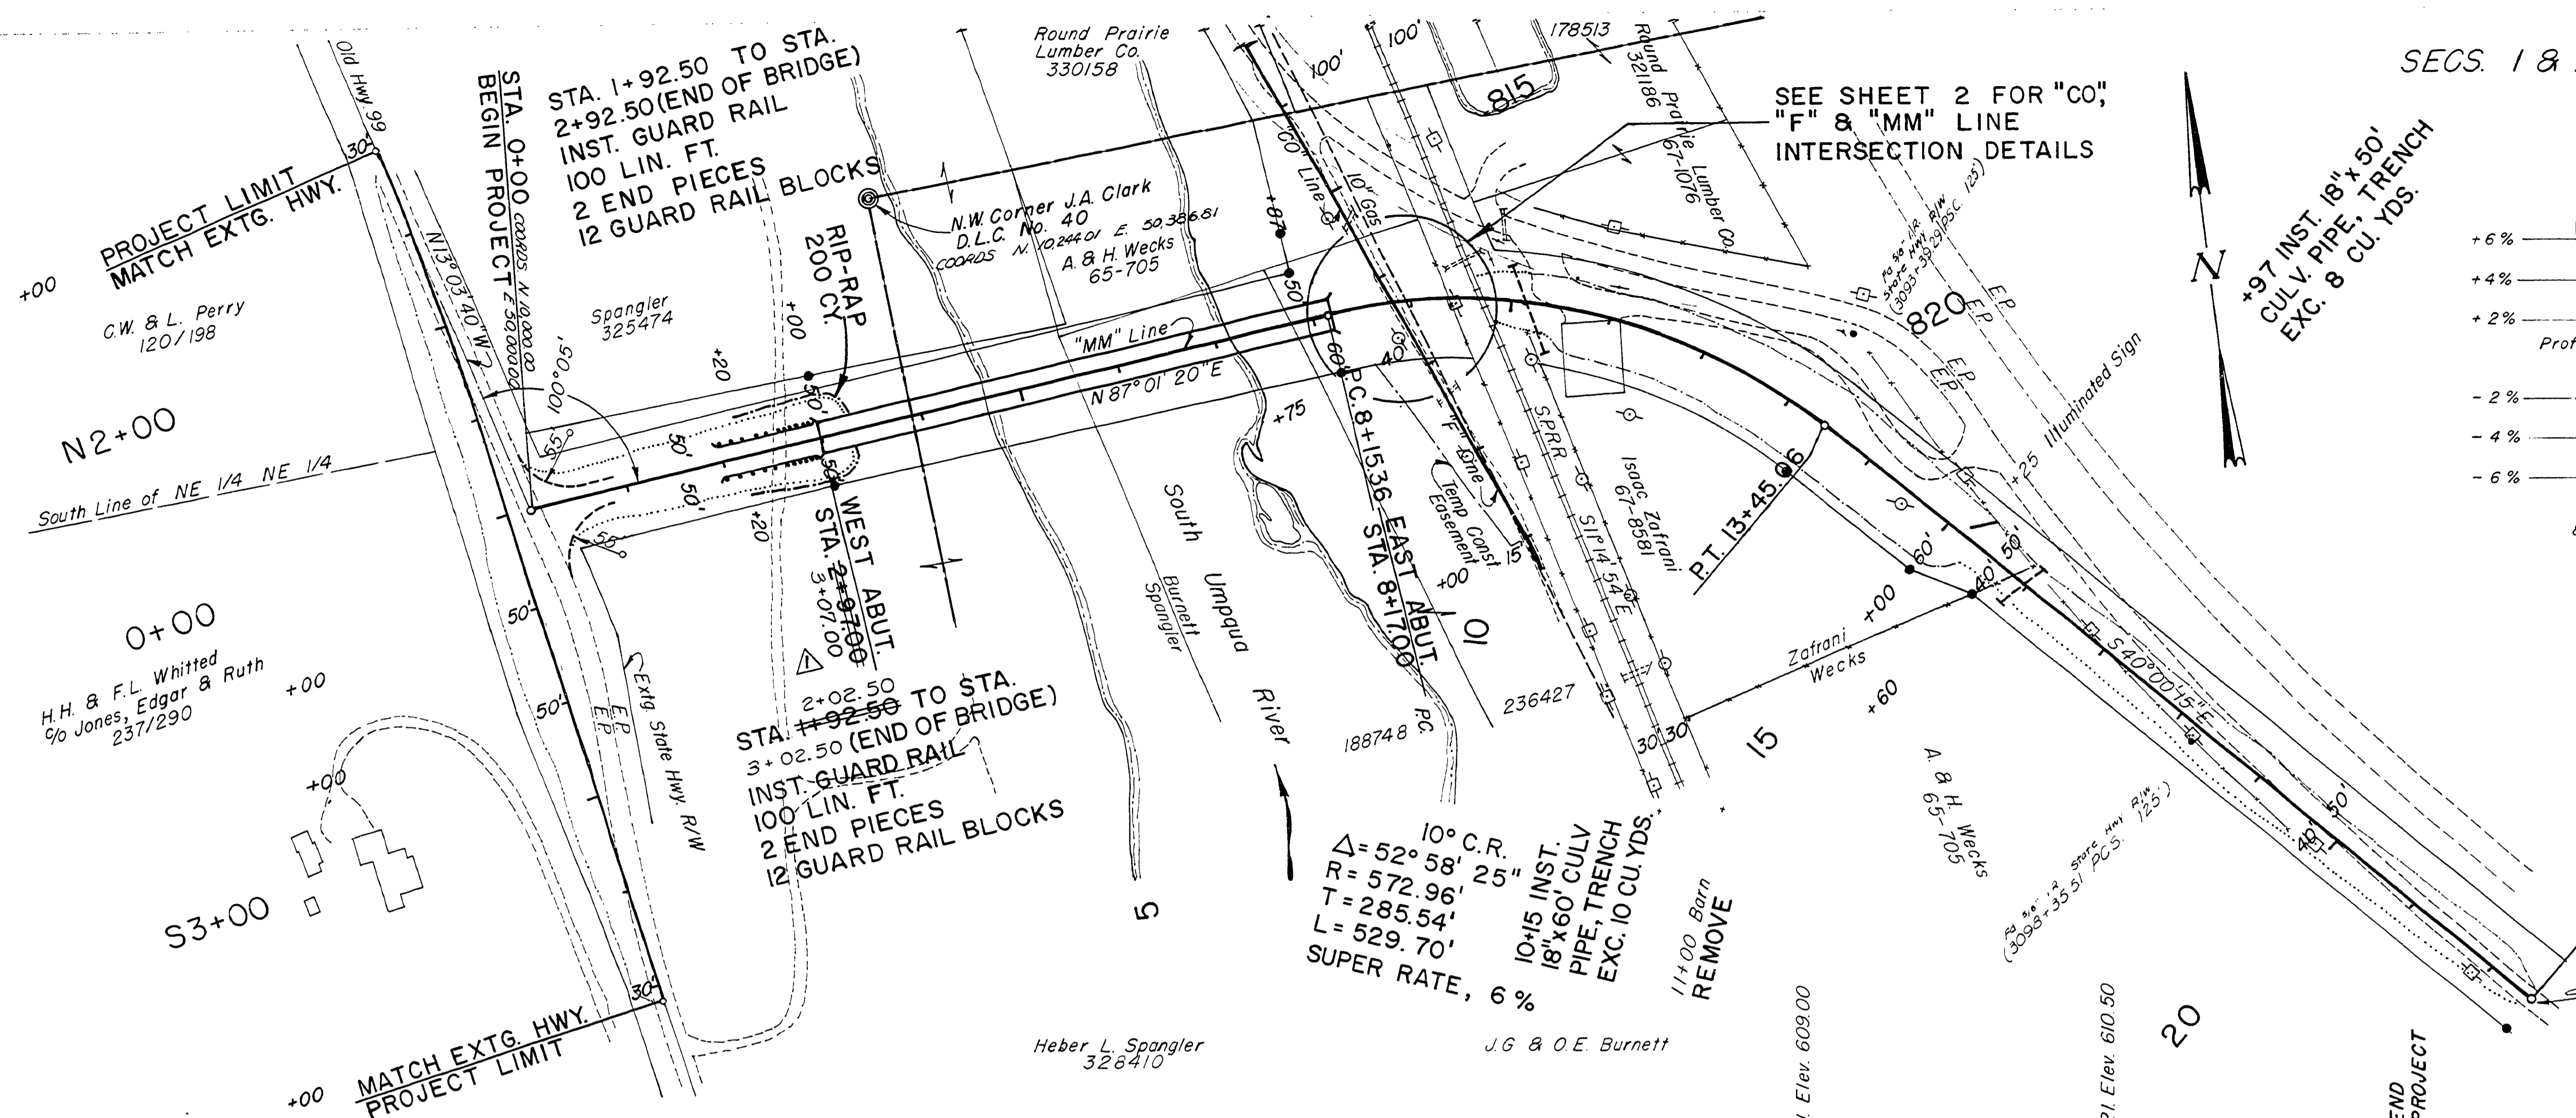

Rev. Change Stations 6-27-69

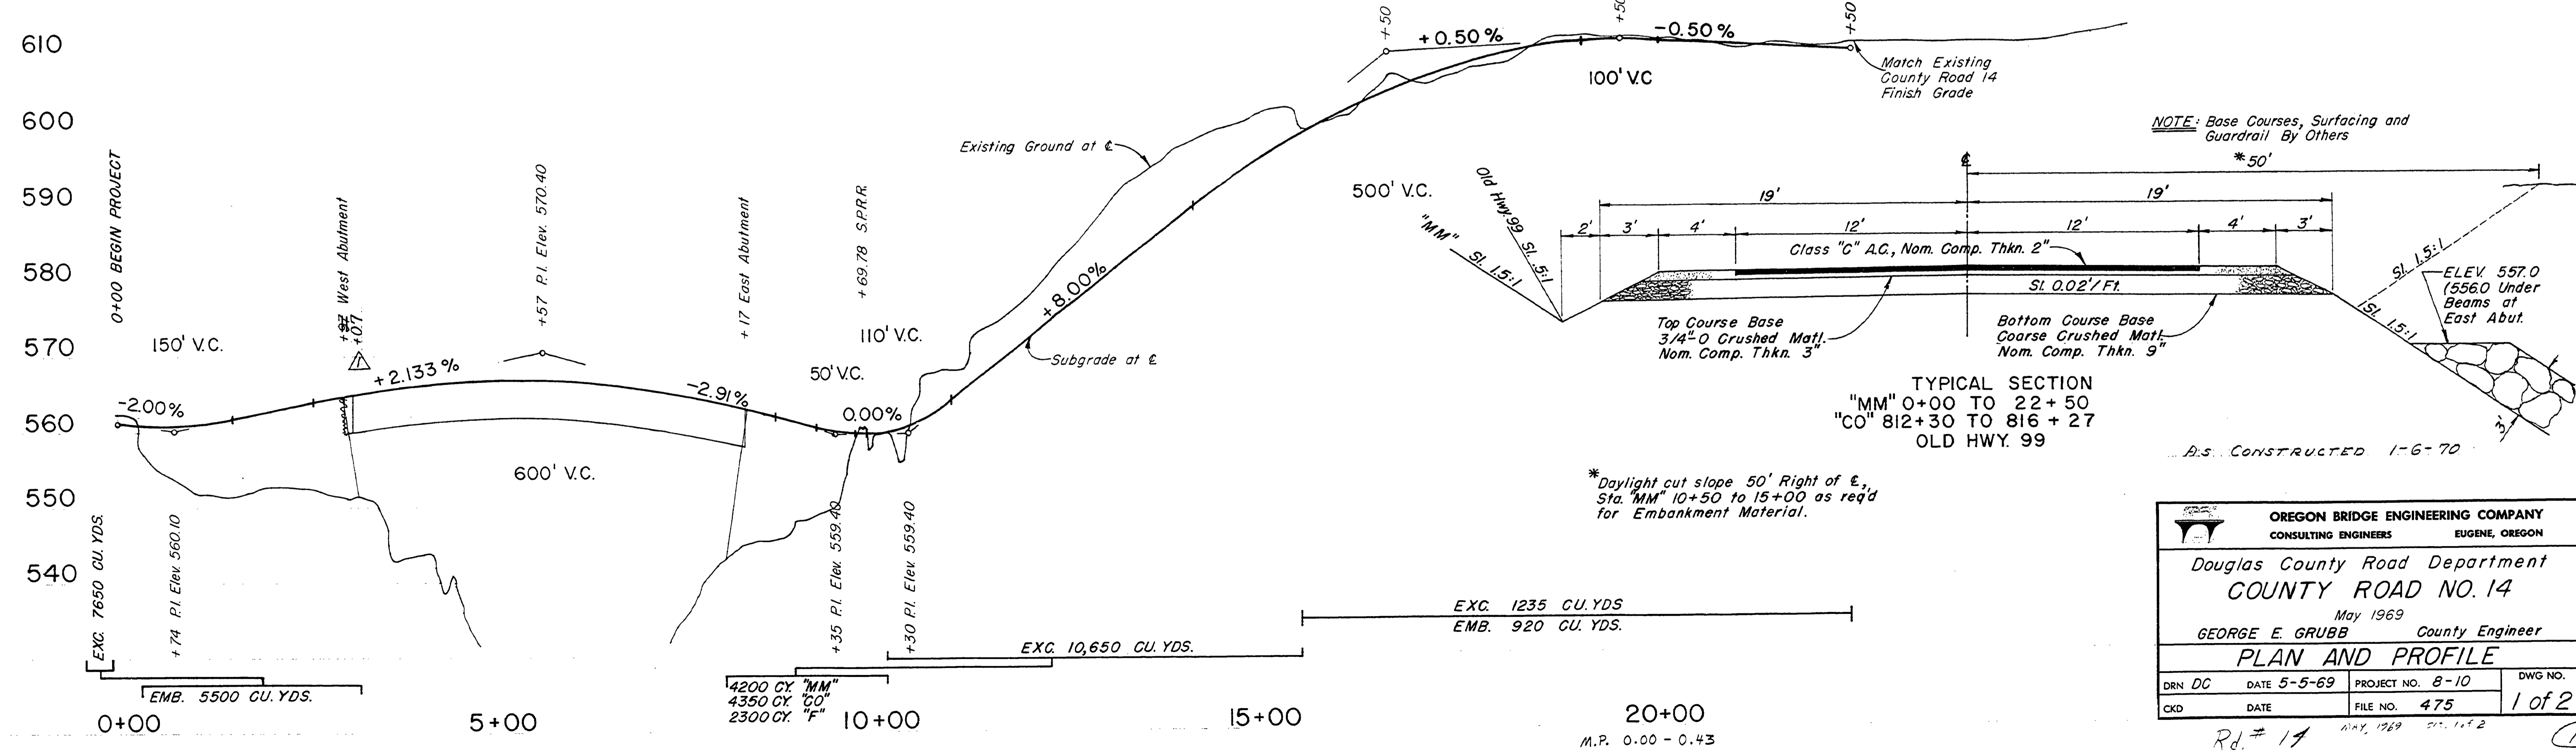

<b>OREGON BRIDGE ENGINEERING COMPANY</b> CONSULTING ENGINEERS EUGENE, OREGON			
Douglas County Road Department <b>COUNTY ROAD NO. 14</b>			
May 1969 GEORGE E. GRUBB County Engineer			
<b>PLAN AND PROFILE</b>			
DRN DC	DATE 5-5-69	PROJECT NO. 8-10	DWG NO.
CKD	DATE	FILE NO. 475	1 of 2

00000043

Rd. # 14 May 1969 51.1x2.2 (15)