
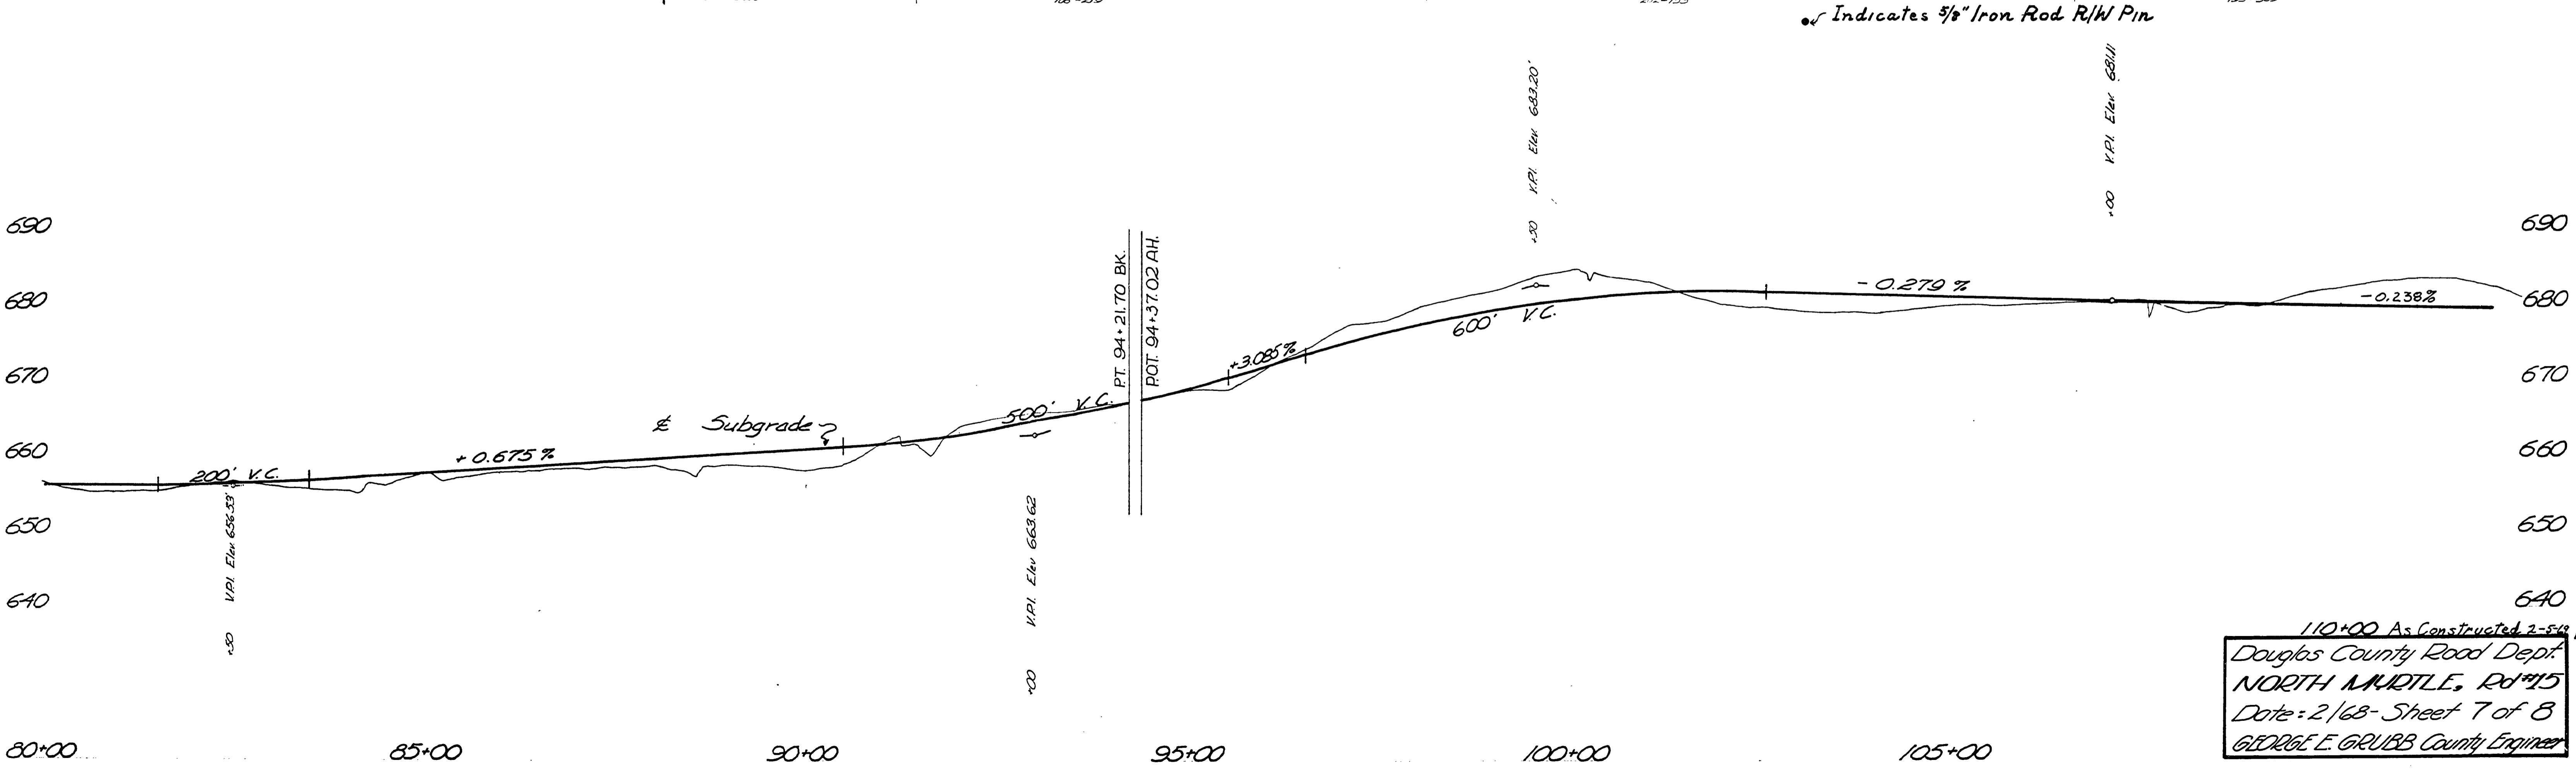


SECS. 14 & 23 T29S R5W W1M

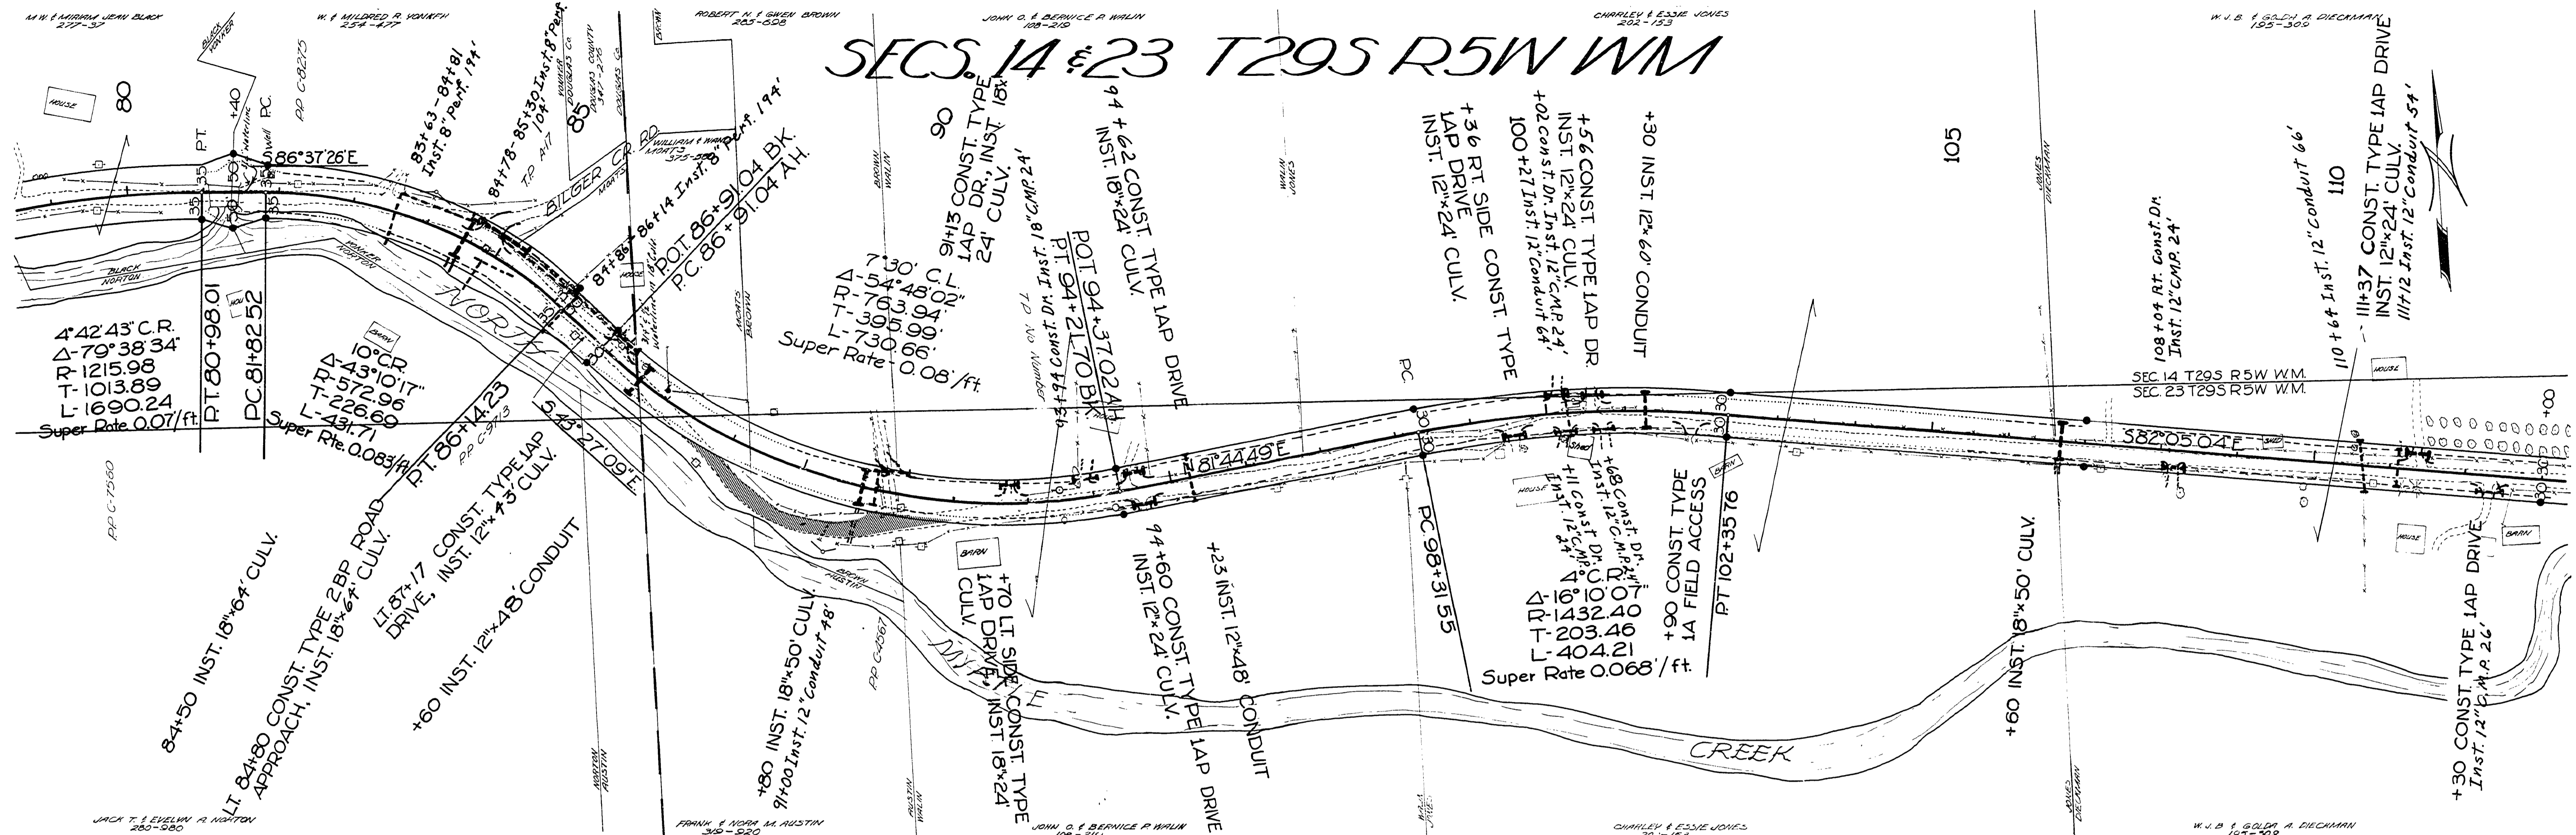

110+00 As Constructed 2-5-68
 Douglas County Road Dept.
 NORTH MIDDLE, Rd #15
 Date: 2/68 - Sheet 7 of 8
 GEORGE E. GRUBB County Engineer

01550214