


SE1/4 SEC.14, T.29S., R.5W., W.M.
 NE1/4 SEC.23, T.29S., R.5W., W.M.

FILED
 Date: 12-10-2025 By: DJ
 This survey consist of:
 Map: Co. Rd. #15 6 pages
 Narrative:
 Corner Rpt:
 DOUGLAS COUNTY
 SURVEYOR

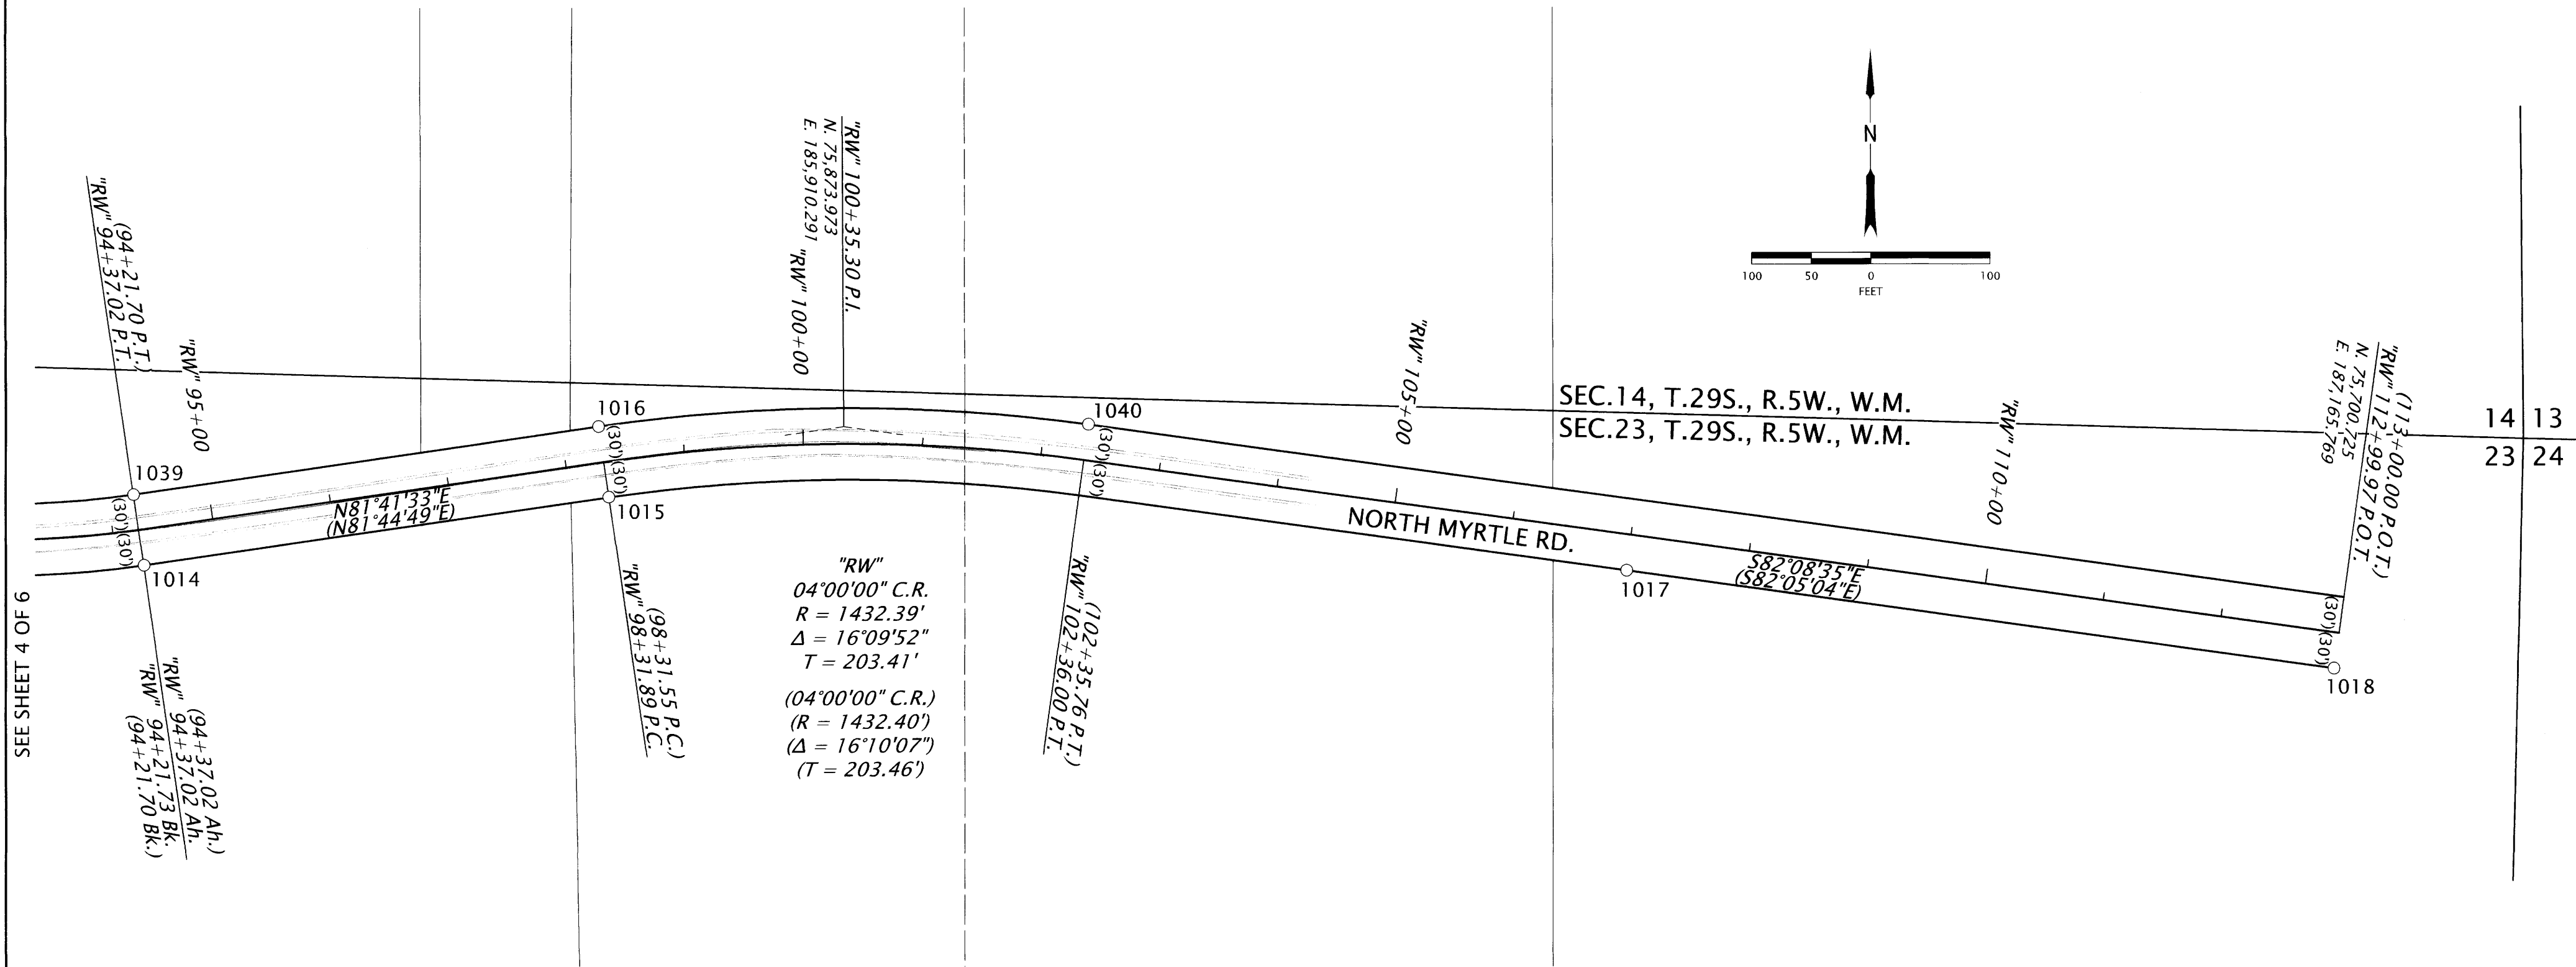


SEE SHEET 4 OF 6

LEGEND	
▲	SET NETWORK POINT - AS NOTED IN TABLE ON SHEET 6
○	FOUND MONUMENT - AS NOTED IN TABLE ON SHEET 6
SEE SHEET 6 FOR LINE LEGEND, CONTROL & MONUMENT TABLE	

RECORD DATA
() 1968 DOUGLAS COUNTY ROAD NO.15 MAP NOS: 00460104; 01040155 & 01550214
SEE SHEET 6 FOR LINE LEGEND, CONTROL & MONUMENT TABLE

REGISTERED
 PROFESSIONAL
 LAND SURVEYOR
Eric B. Hibbs
 OREGON
 NOVEMBER 13, 2018
 ERIC BENJAMIN HIBBS
 90437PLS
 RENEWS: 06/30/2027

OREGON DEPARTMENT OF TRANSPORTATION
 HORIZONTAL CONTROL, RECOVERY AND RETRACEMENT MAP
 BILGER CREEK, COUNTY RD. 15, BRIDGE PROJECT
 NORTH MYRTLE RD.
 DOUGLAS COUNTY



ODOT REGION 3 TECH CENTER
 3500 NW STEWART PKWY.
 ROSEBURG, OR 97471 KEY NO. K23160

DECEMBER 2, 2025
 SCALE: 1" = 100'
 SHEET 5 OF 6

01800214