


⊙ Indicates 5/8" Iron Rod R/W Pin

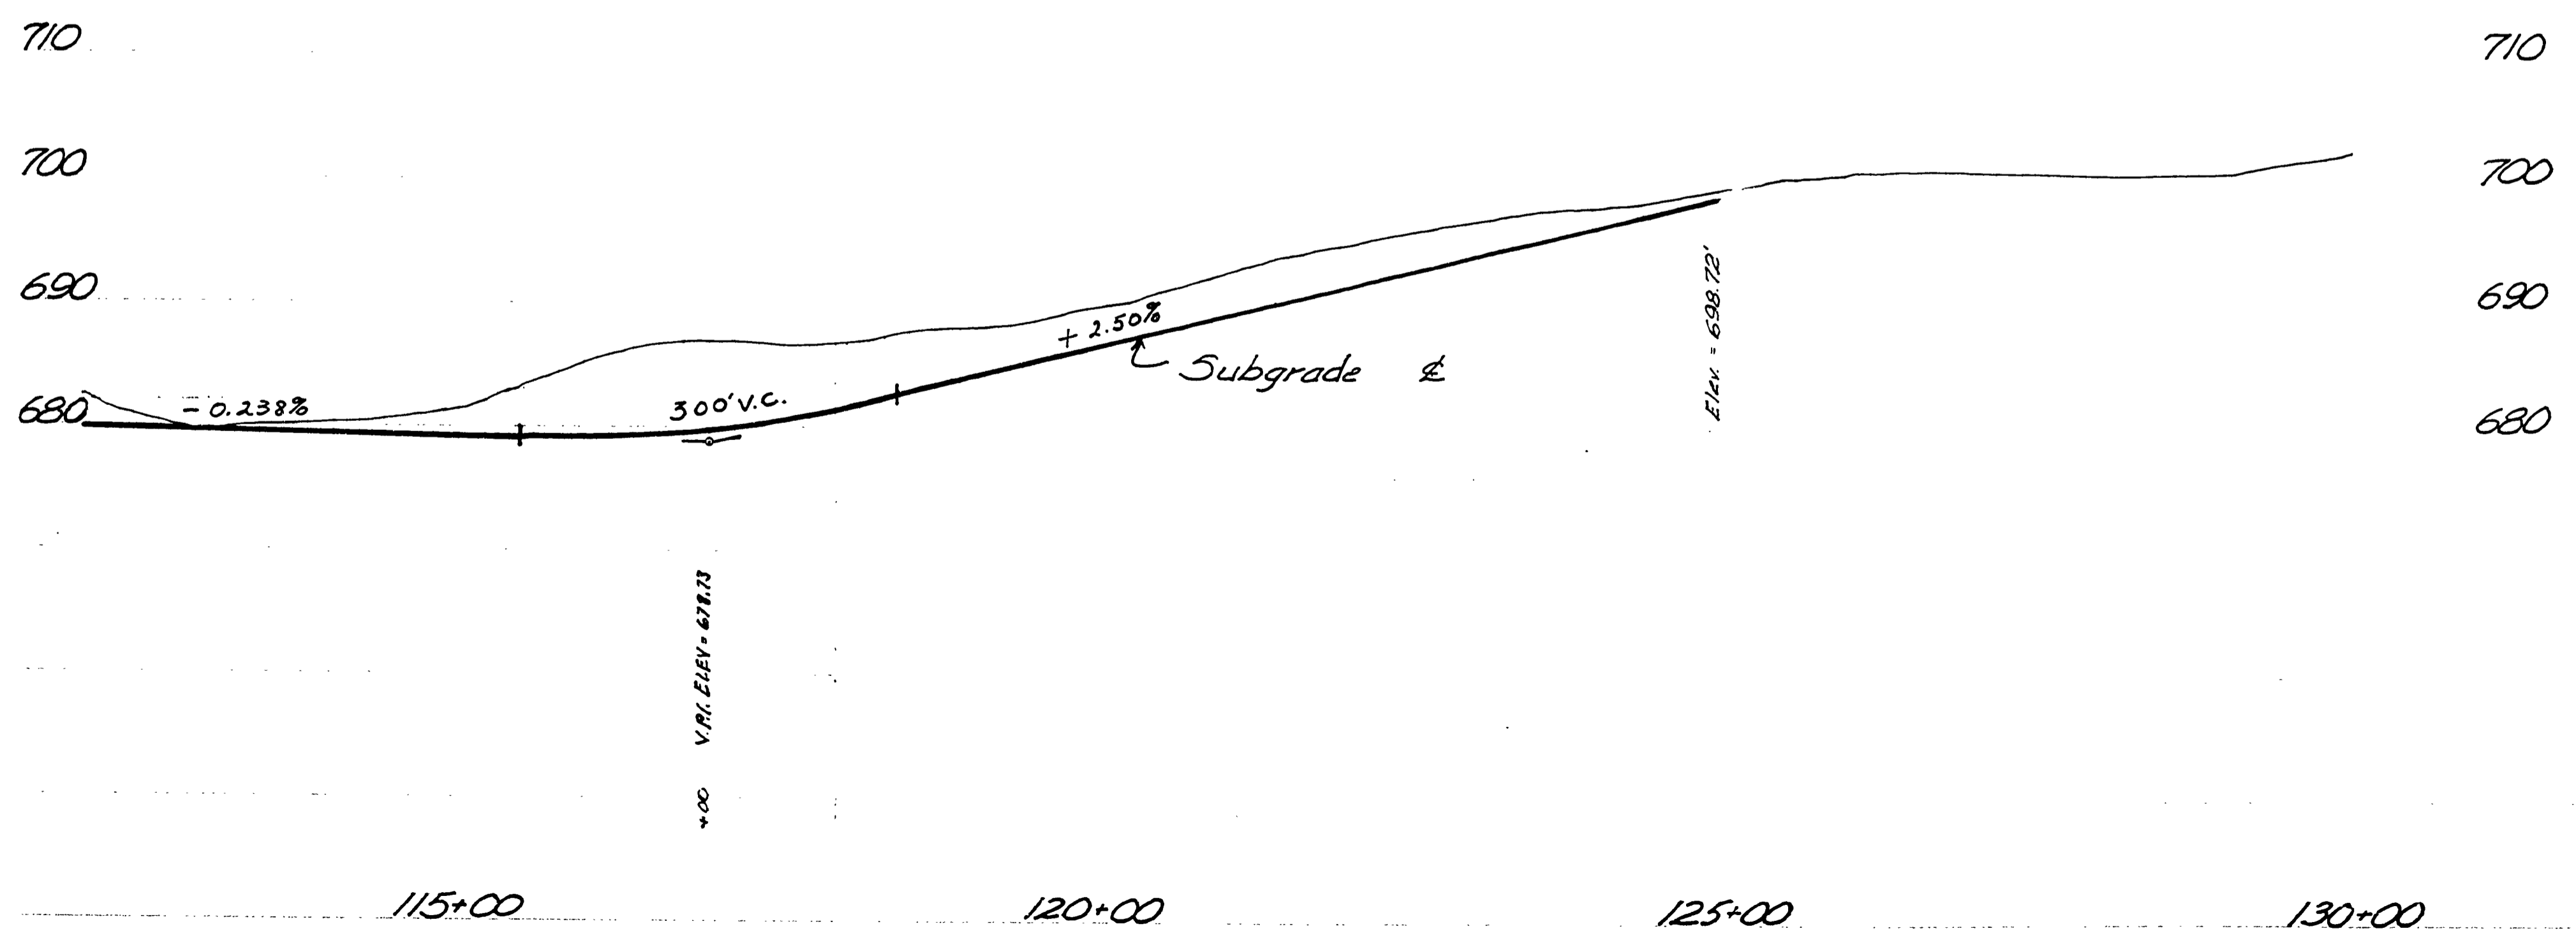

As Constructed, 2-7-69  
 Douglas County Road Dept.  
 NORTH MIDDLE, Rd. #15  
 Date: 2/68 - Sheet 8 of 8  
 GEORGE E. GRUBB County Engineer

0214024

M.P. 2.14 - 2.41

Rd #15 FEB 1968 25

