


•Indicates 3/8" or 1/2" Iron Rod R/W Pin

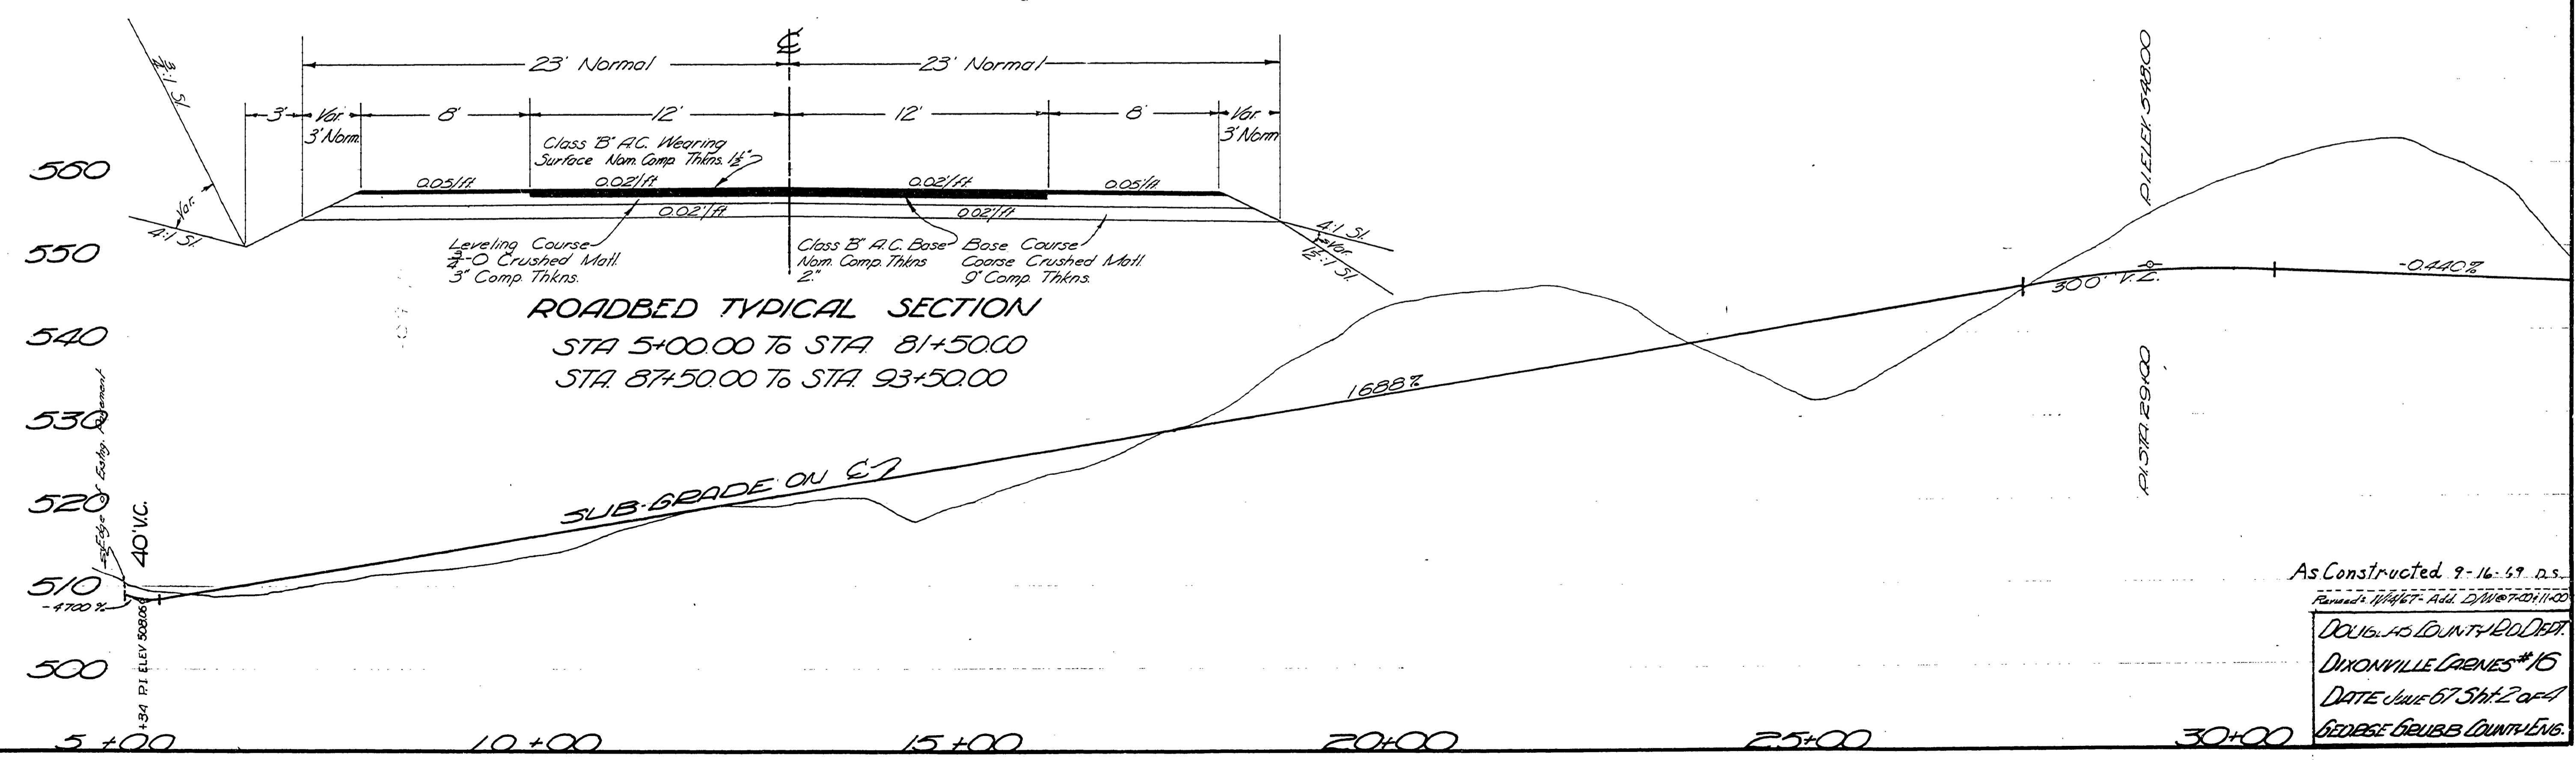

ROADBED TYPICAL SECTION
 STA. 5+00.00 TO STA. 81+50.00
 STA. 87+50.00 TO STA. 93+50.00

As Constructed 7-16-67 D.S.
 Revised W/let - Add. D/W/let 11-20
 DOUGLAS COUNTY ROAD DIST.
 DIXONVILLE LAWNES #15
 DATE June 67 Sht. 2 of 4
 GEORGE GRUBBS COUNTY ENG.