
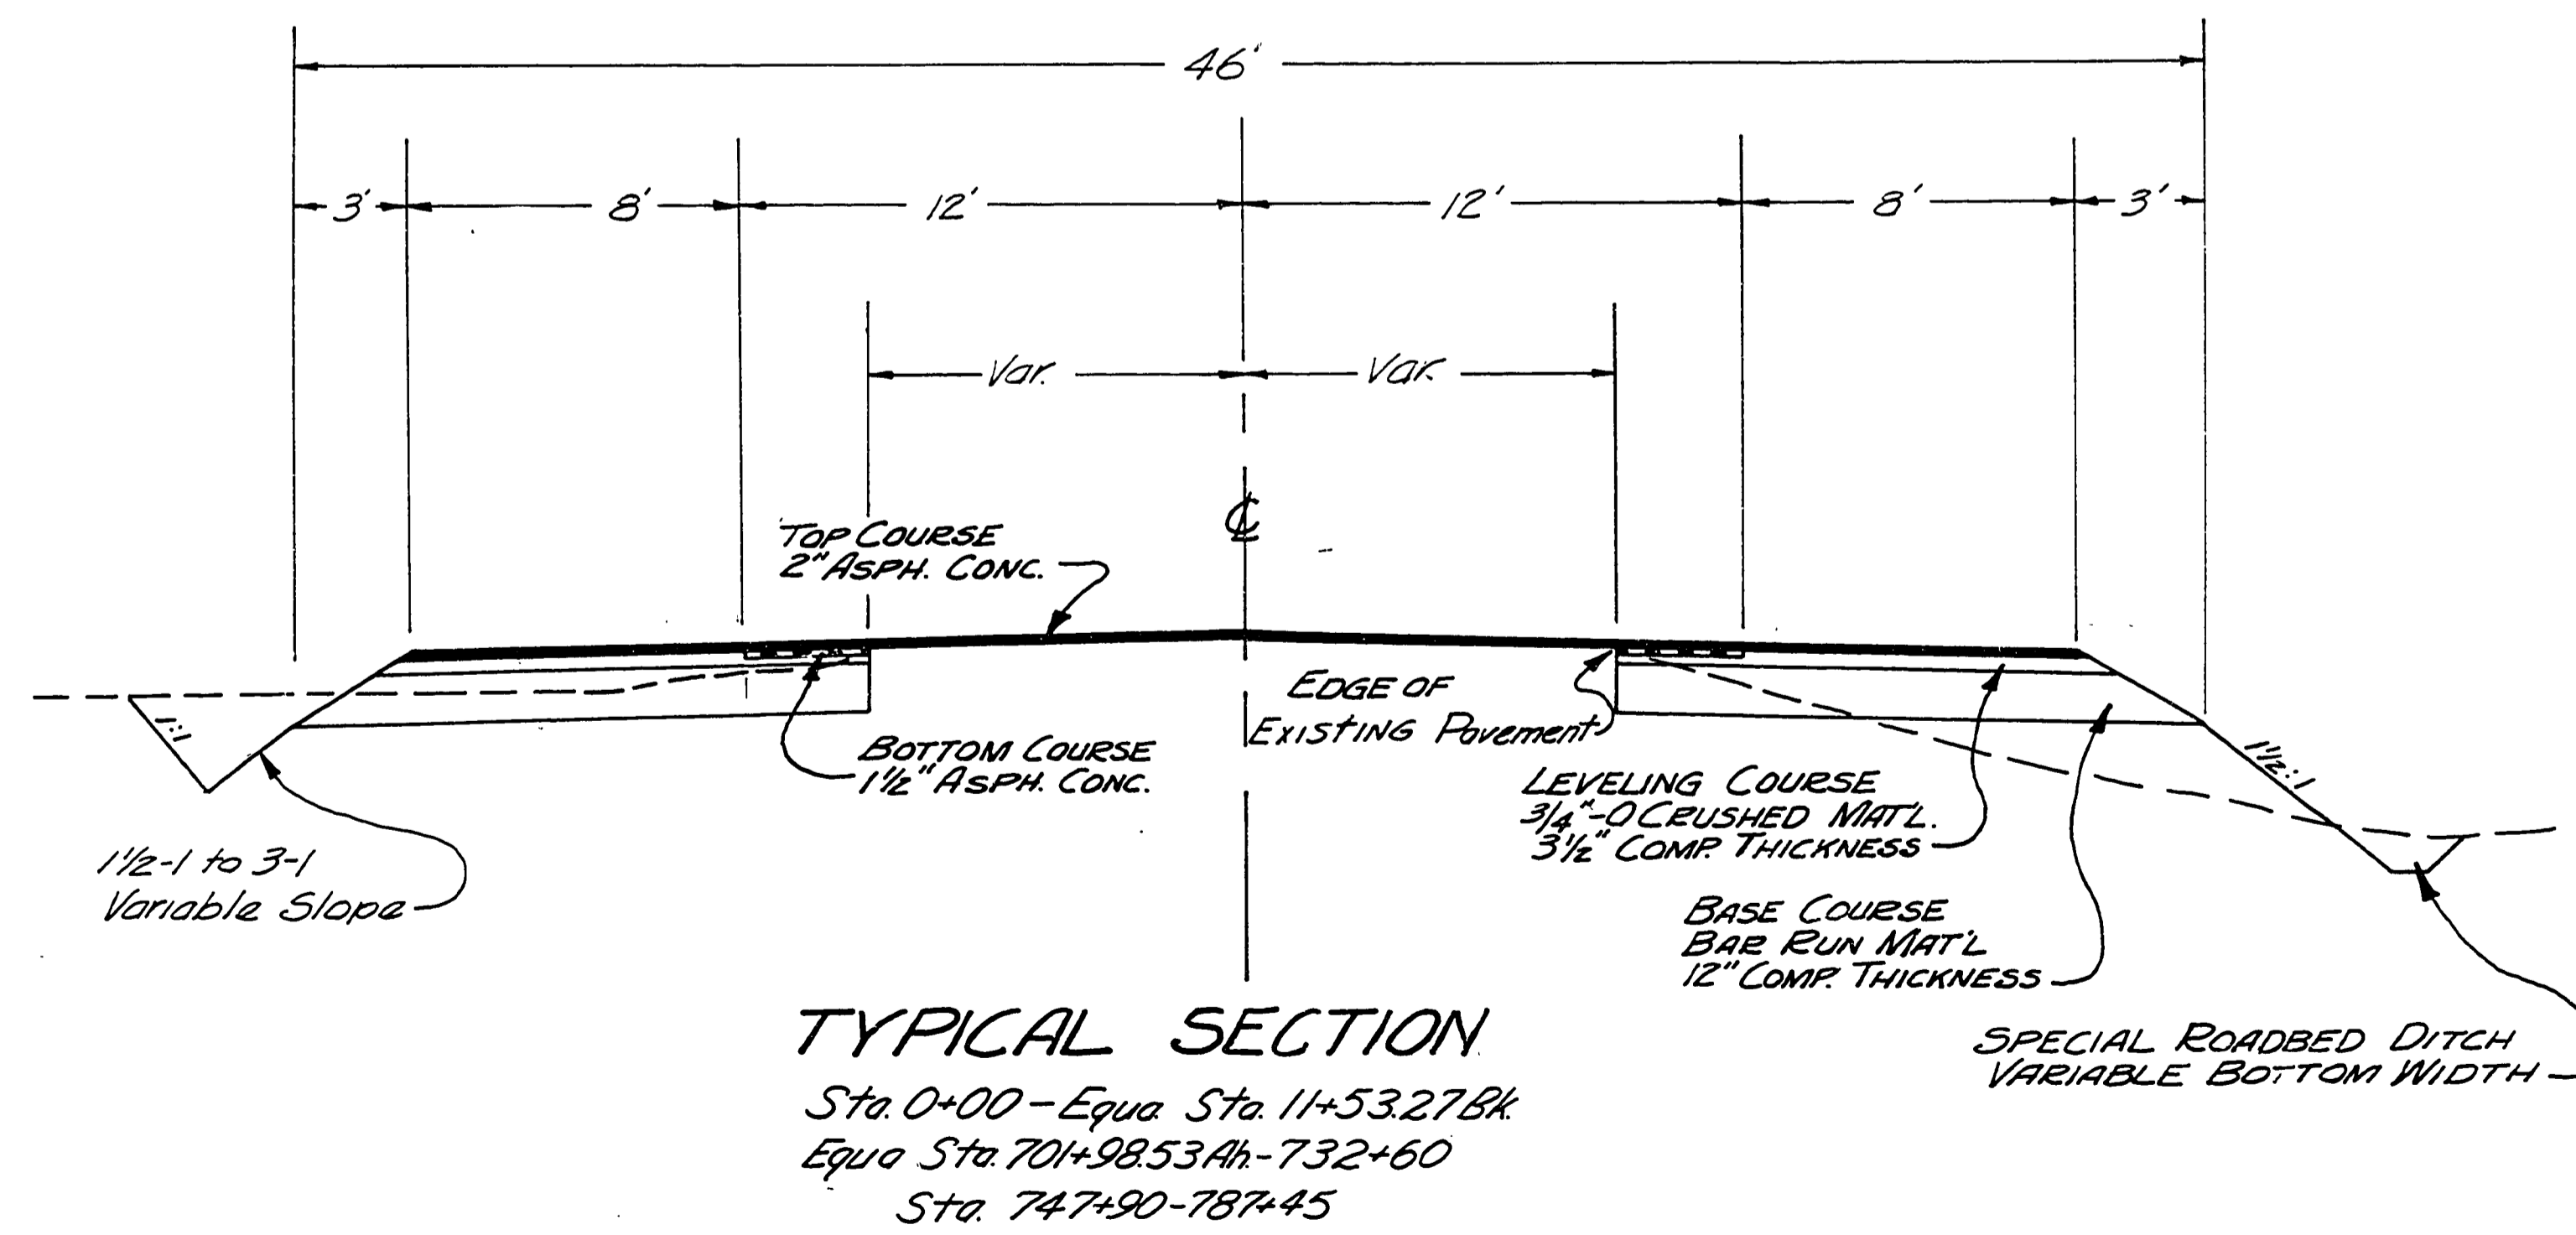


DOUGLAS COUNTY OREGON

As Constructed


GRADING & SURFACING DIXONVILLE - CARNES RD. No. 16

April 1964

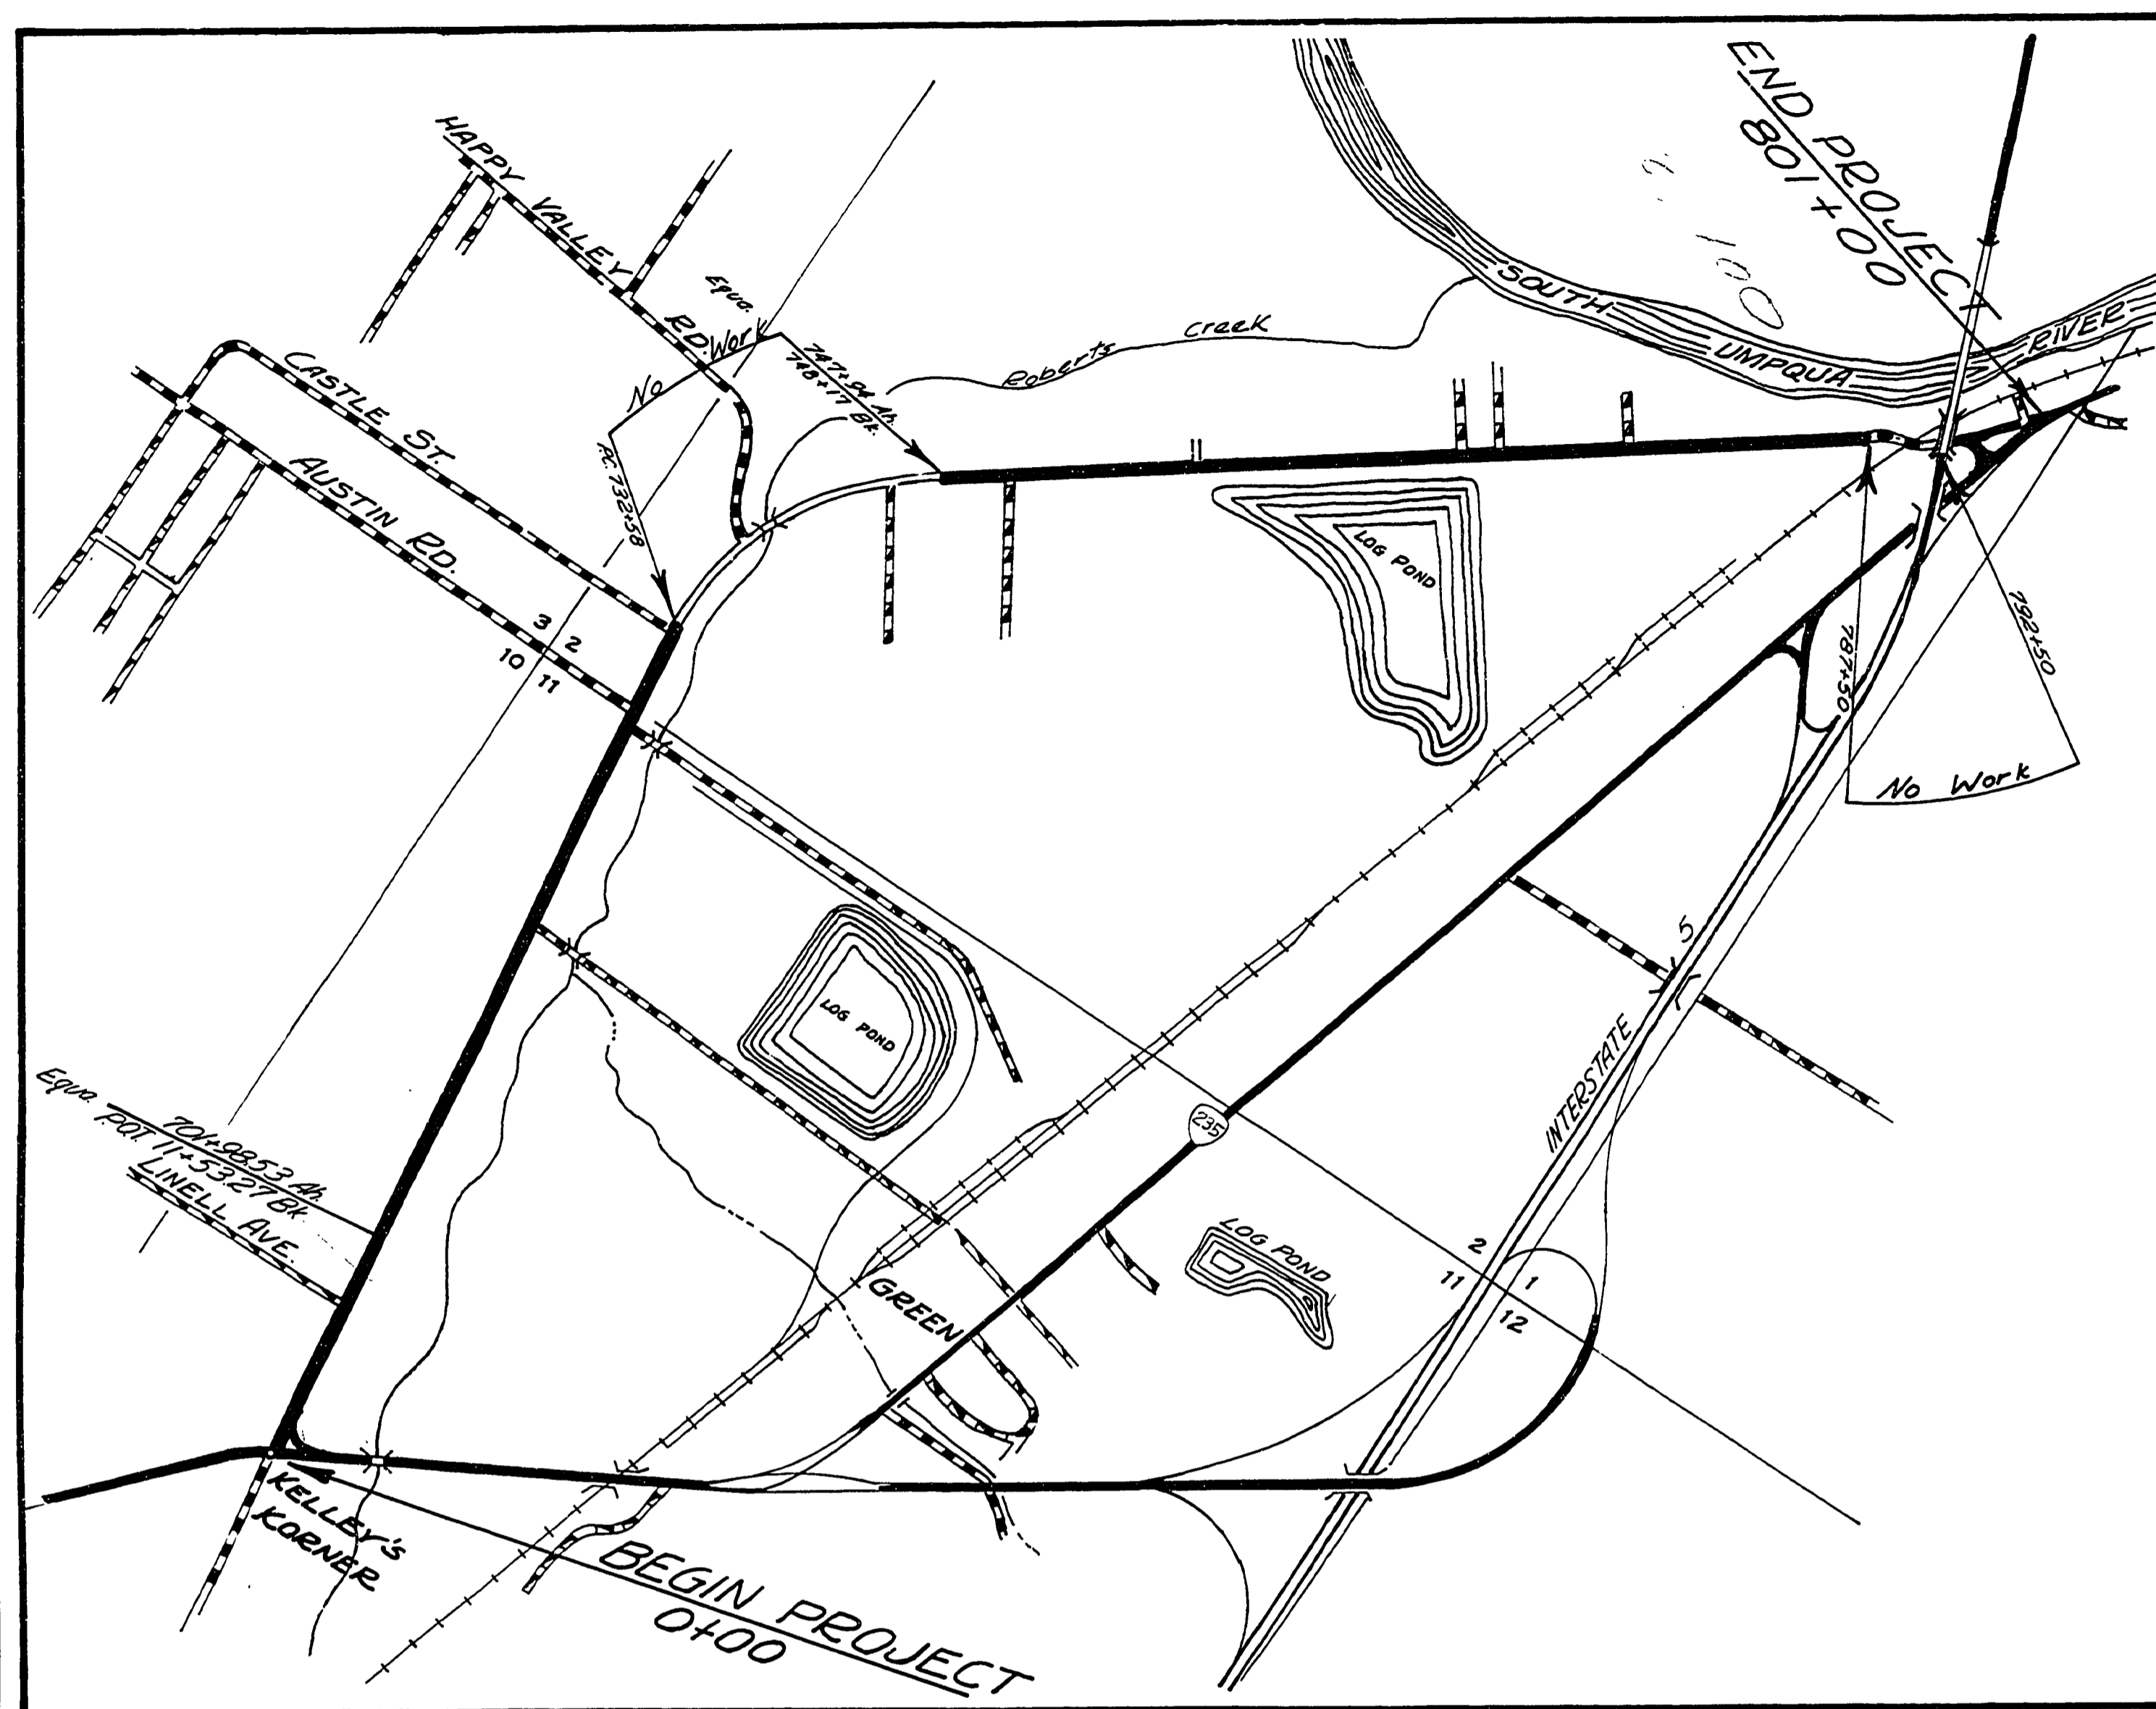

Adopted by Resolution of the County Court, this 7th day of March 1964.

JUDGE
E. H. ...
COMM.
Ray C. ...
COMM.

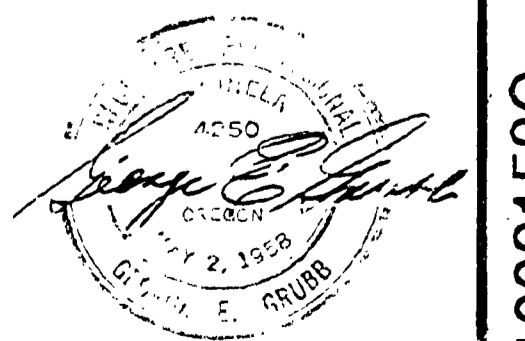

1332153C

Rd. #16 APRIL 1964 201087