



SPORTSVILLE

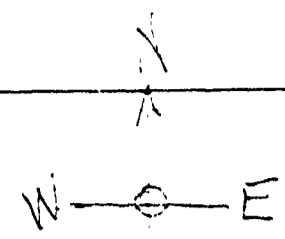

T. 27-2

1" = 100'

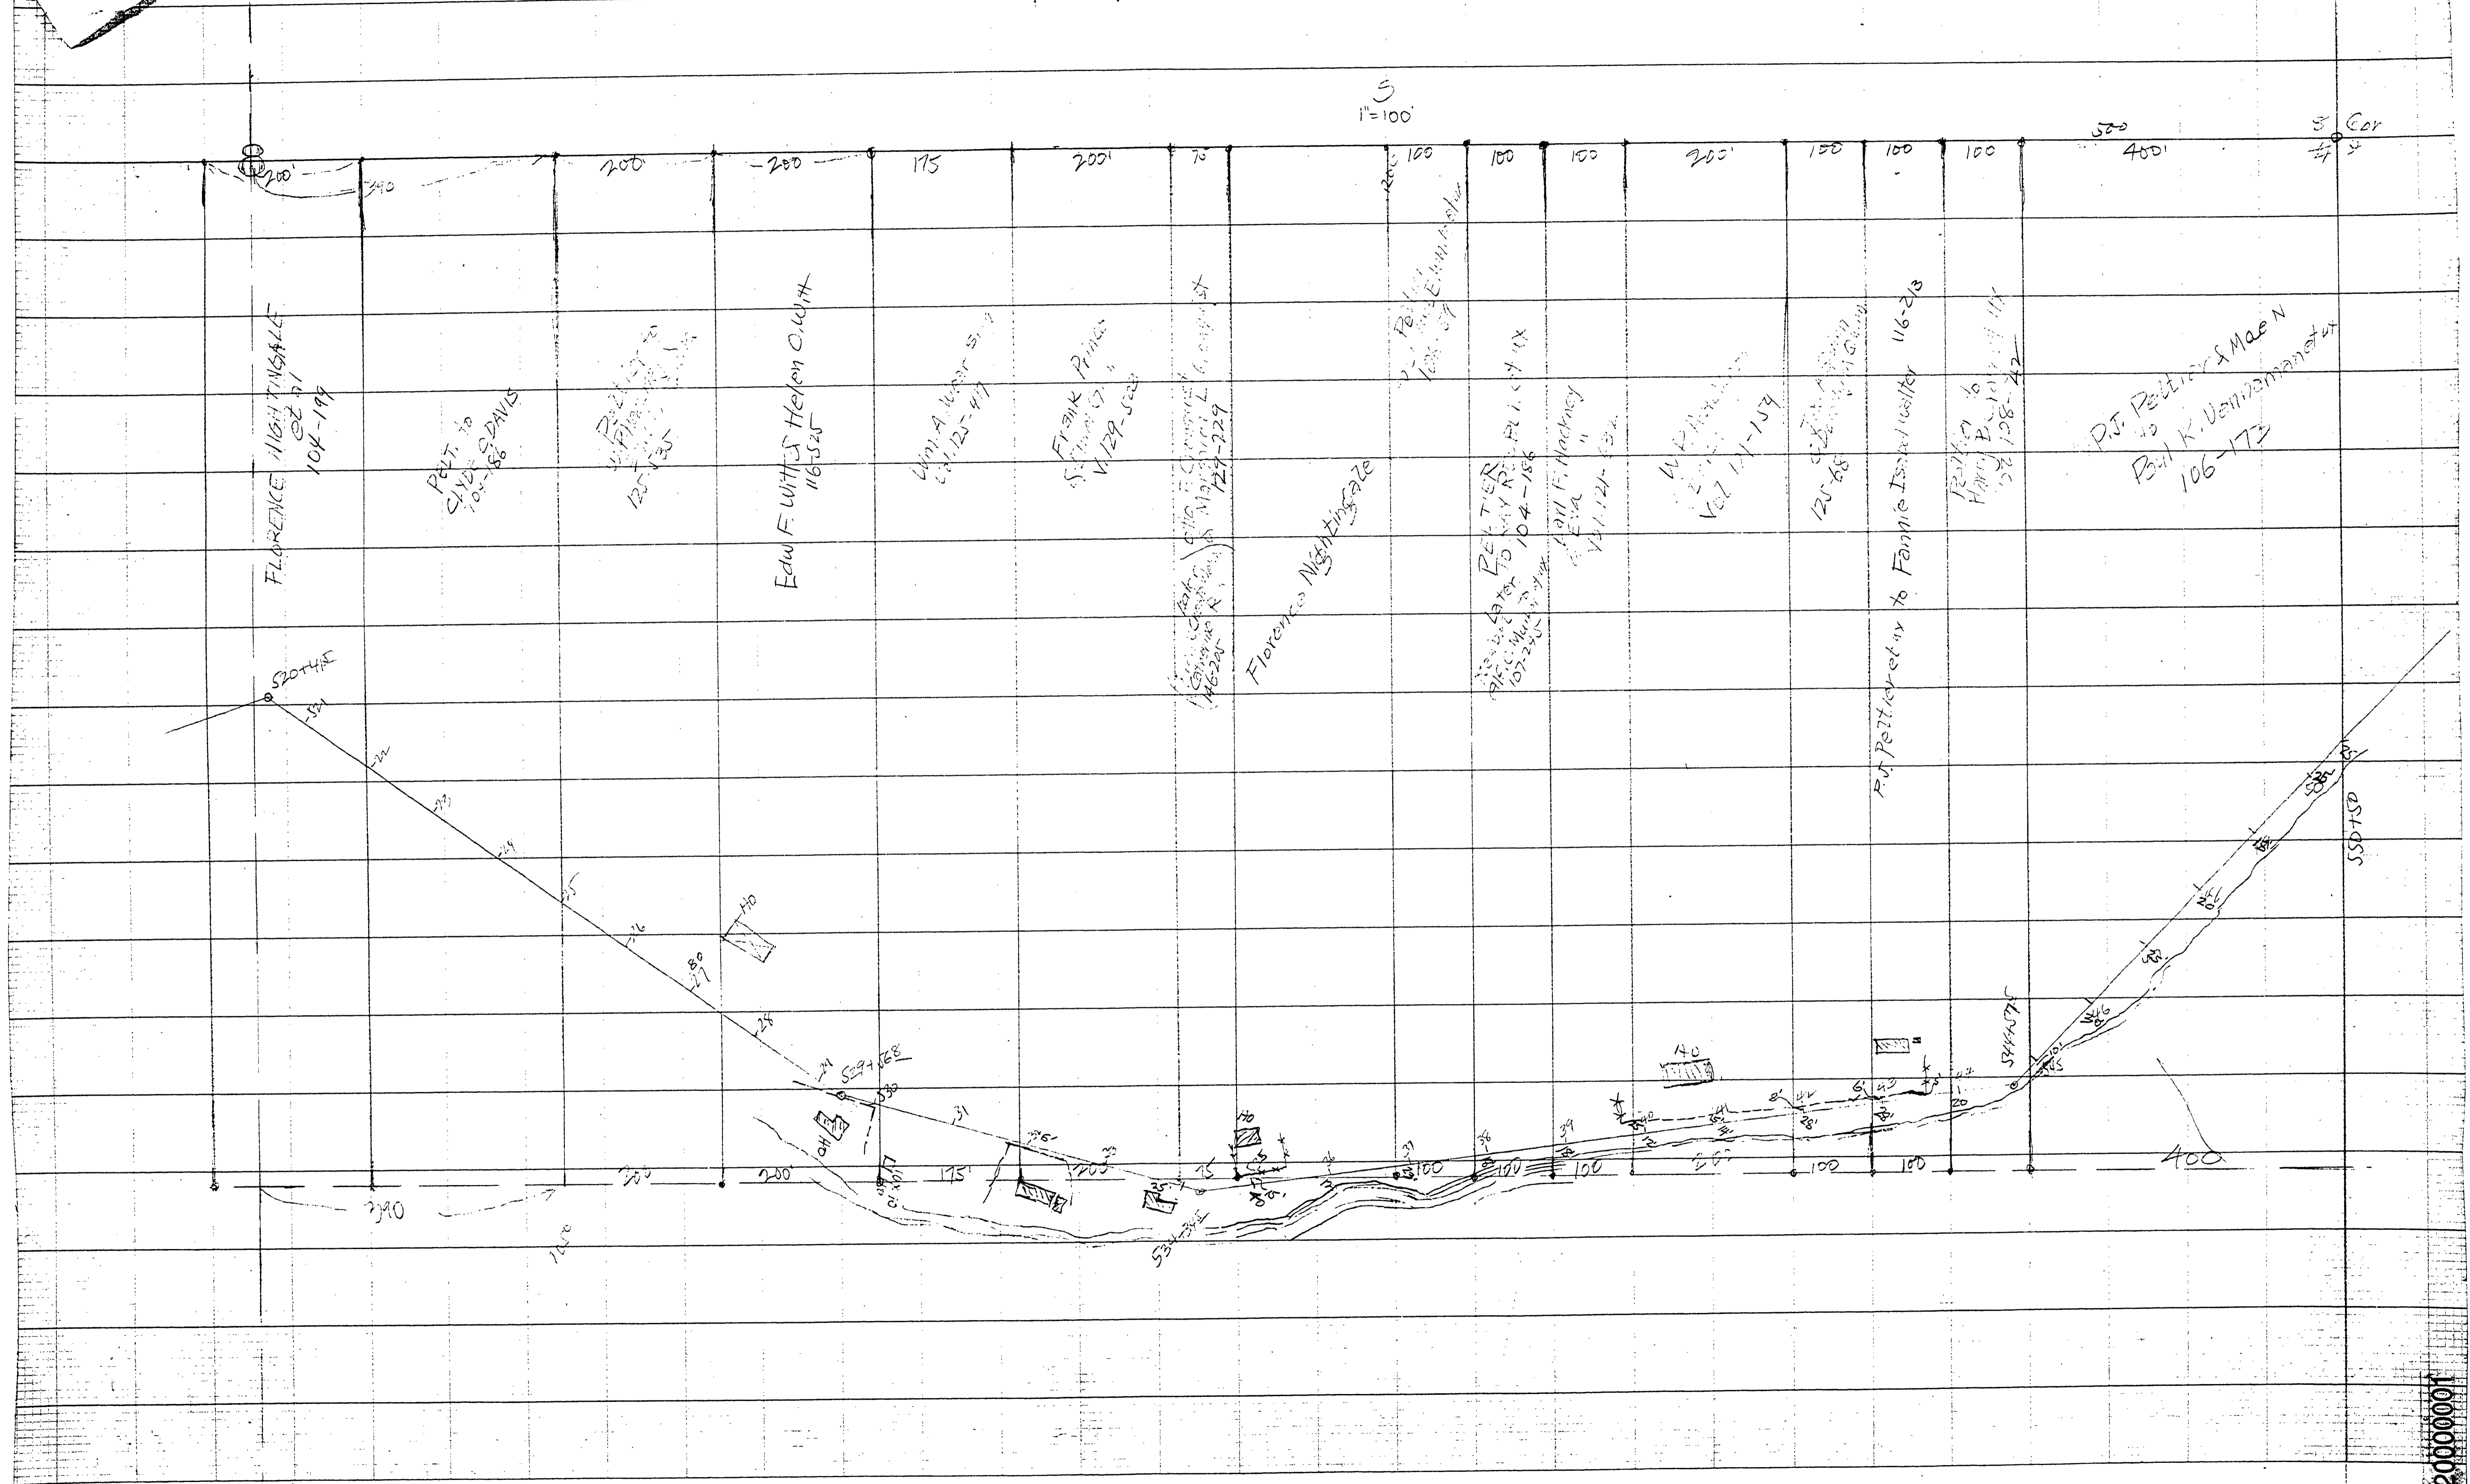

"PERFECT" CROSS SECTION  
10 X 10 ONE INCH  
EUGENE DIETZGEN CO.

PRINTED IN U.S.A.  
ON 100% RAG PAPER MADE IN U.S.A.

"PERFECT" CROSS SECTION  
10 X 10 ONE INCH  
EUGENE DIETZGEN CO.

~ M.P. 20.00  
T. 27-2 S. 8 N. O. DATE

RD # 17  
2000000'