



DOUGLAS COUNTY - OREGON
 PLANS FOR PROPOSED PROJECT
 AS CONSTRUCTED
 SOUTH MYRTLE CREEK ROAD
 COUNTY ROAD NO. 18
 MAY 1960

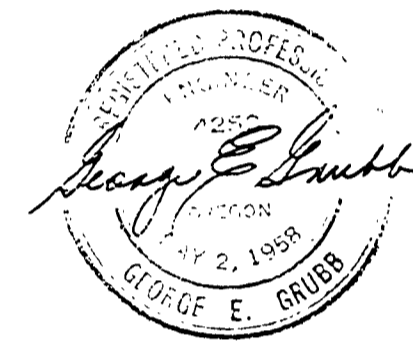

TYPICAL SECTIONS

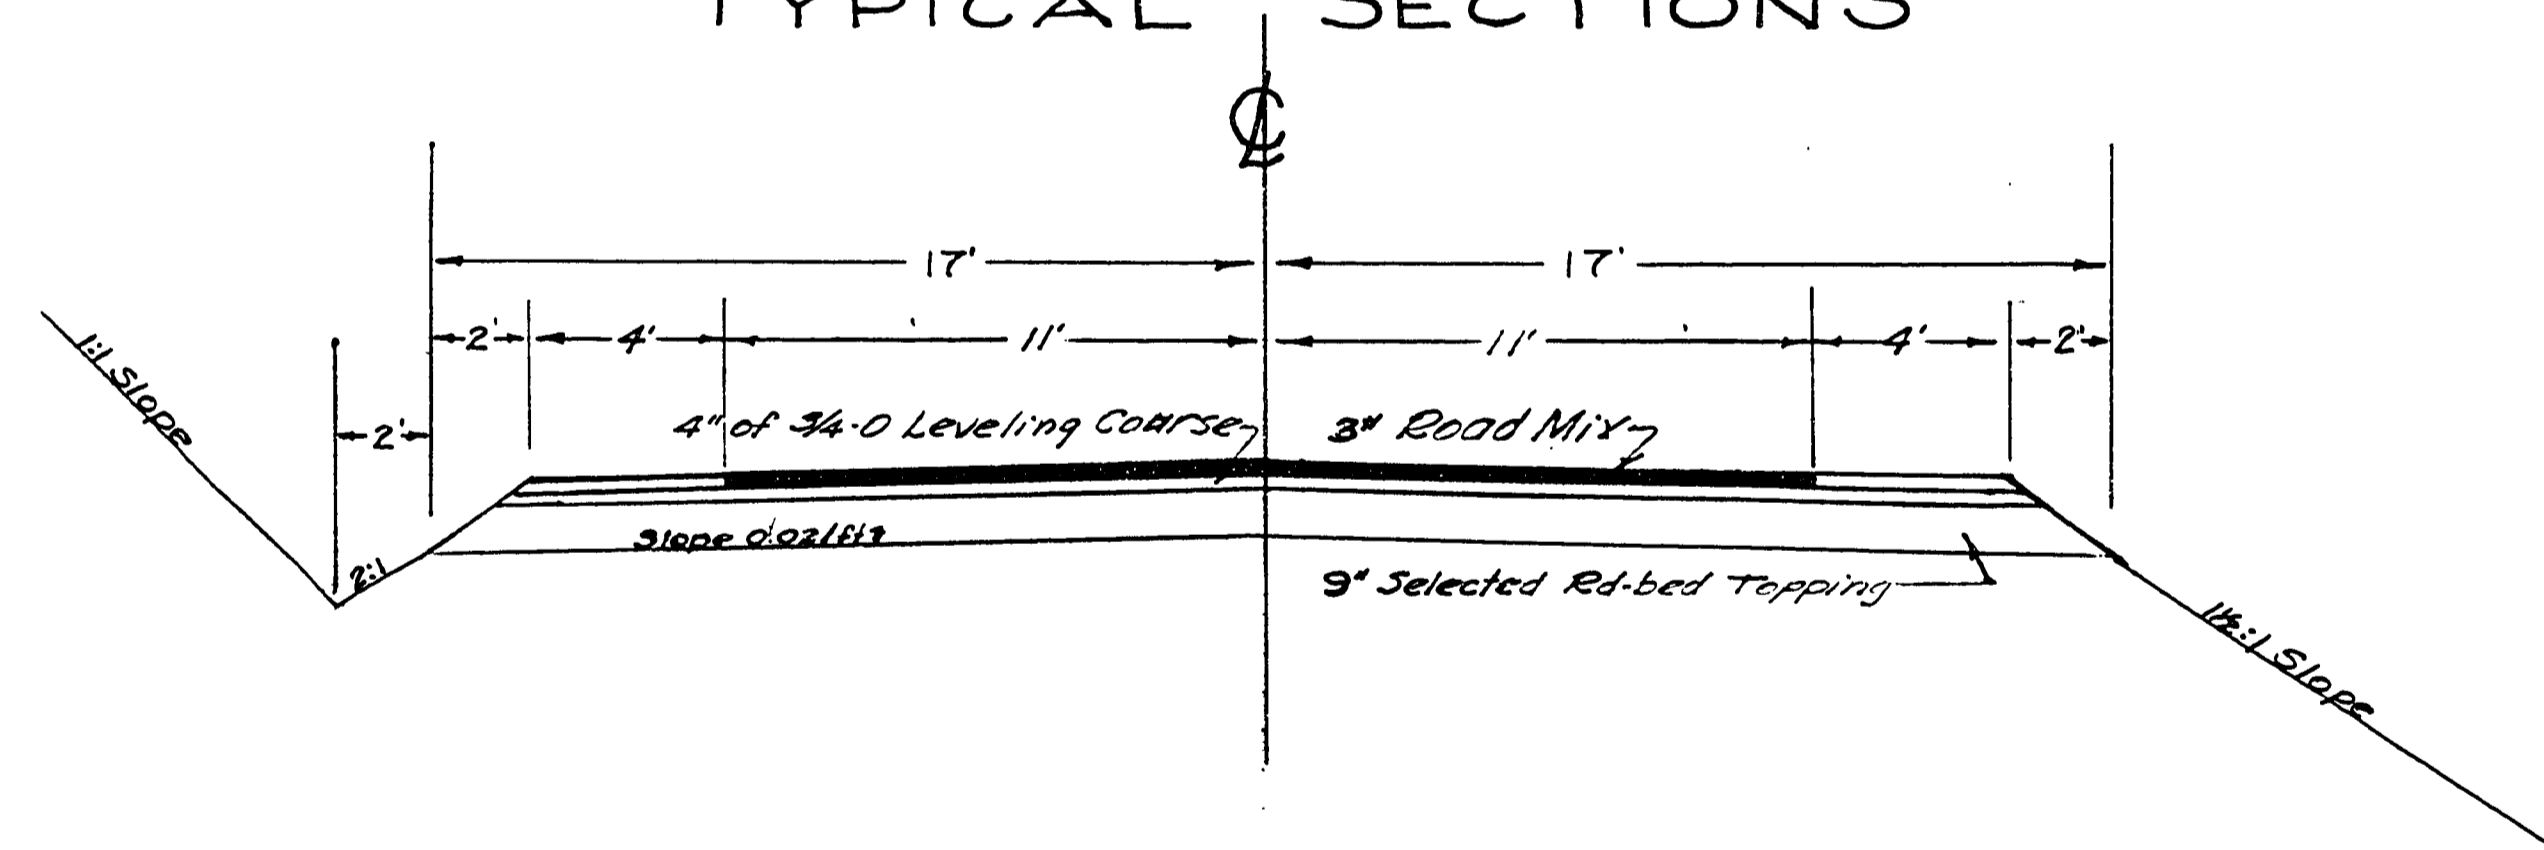

RIP-RAP DETAIL

