


MP1

4°15' CL.
 Δ-36°27'43"
 R-1348.14
 T-444.05
 L-857.93
 CROWN SECTION

6° CR
 Δ-37°26'00"
 R-954.93
 T-323.54
 L-623.89
 CROWN SECTION

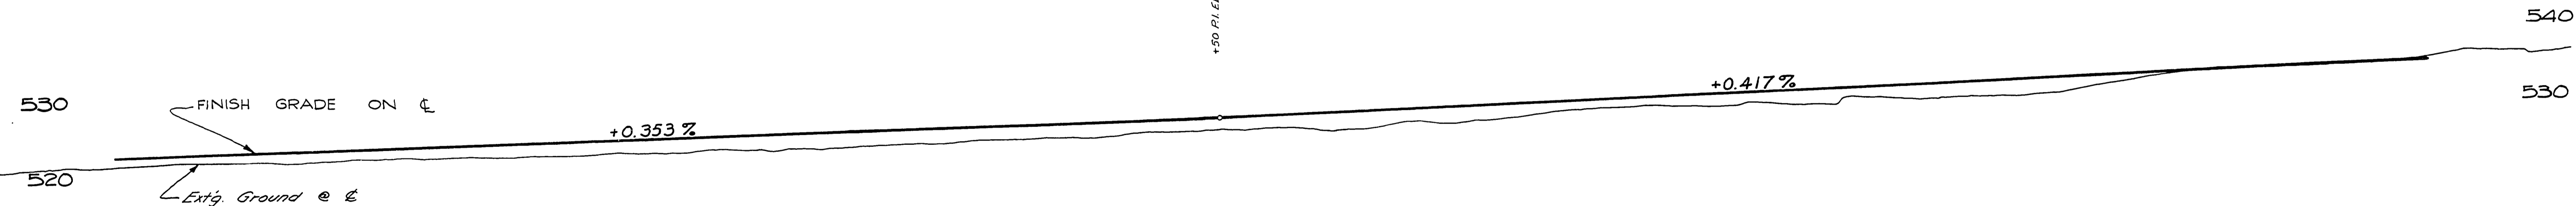

35+00

40+00

45+00

50+00

55+00

60+00

65+00
 REVISED AS BUILT 9-20-25-74
 Douglas County Road Dept.
 SUTHERLIN PLAT "K" SEC. RD #19
 Date: 1973 Sheet 9 of 13
 GEORGE E. GRUBB County Engineer

00590116

FD # 19 1973 212 9 of 13

M.P. C-59-1.16

