



DOUGLAS COUNTY, OREGON
 PLANS FOR PROPOSED PROJECT
 GRADING & SURFACING
SUTHERLIN-NONPARIEL ROAD NO. 19

MILE POINT 1.31 TO MILE POINT 4.42

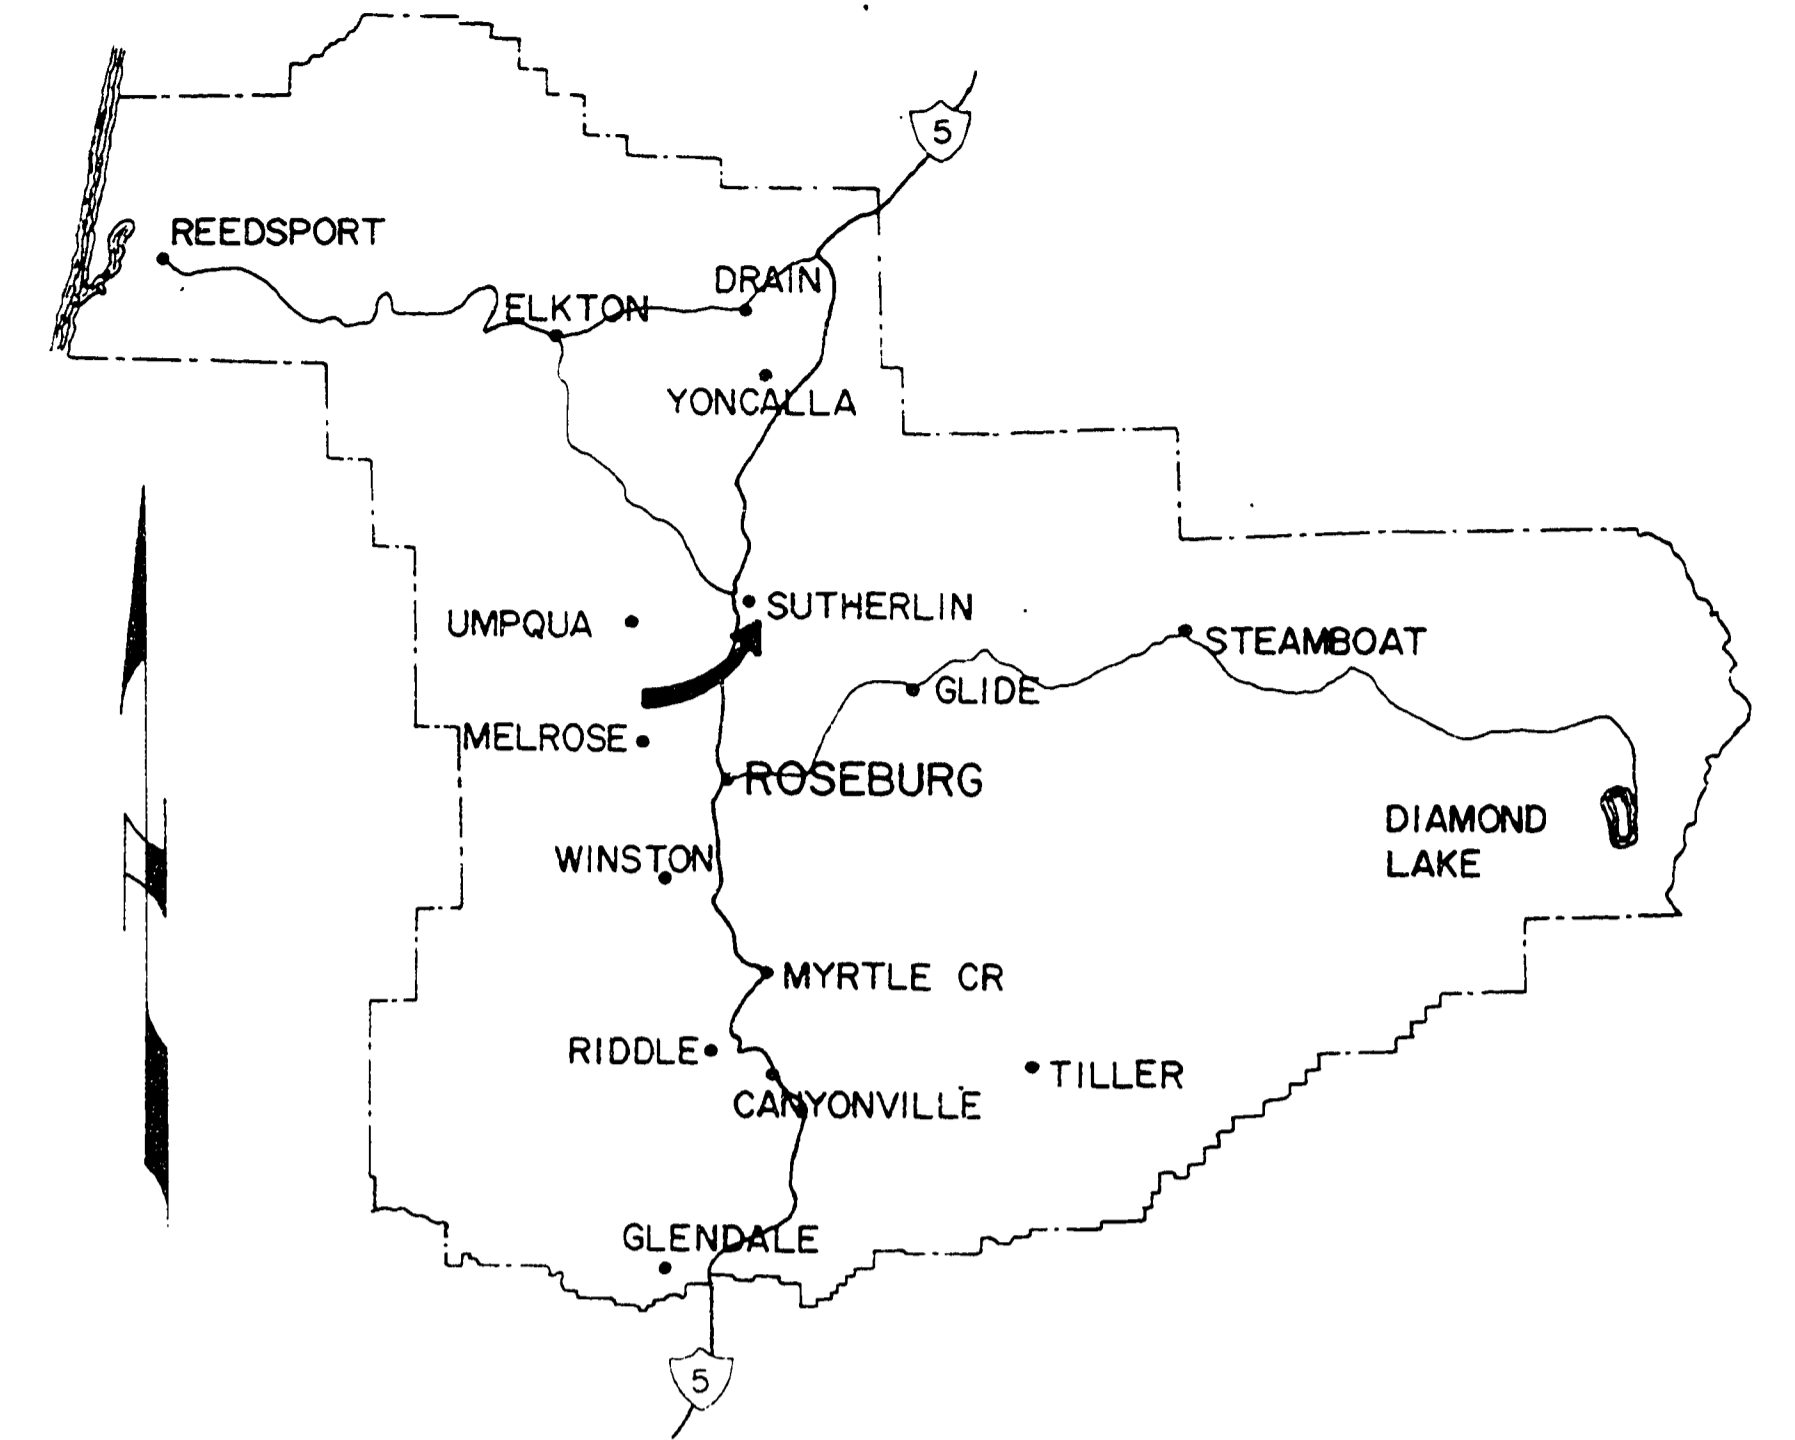

THIS SET OF PLANS CONSISTS OF THE FOLLOWING
 12 SHEETS OF ROAD PLANS
 2 PIPE LISTS, STD DWNG NO.1
 1 STANDARD SYMBOLS, STD DWNG NO.9
 TOTAL 15 SHEETS

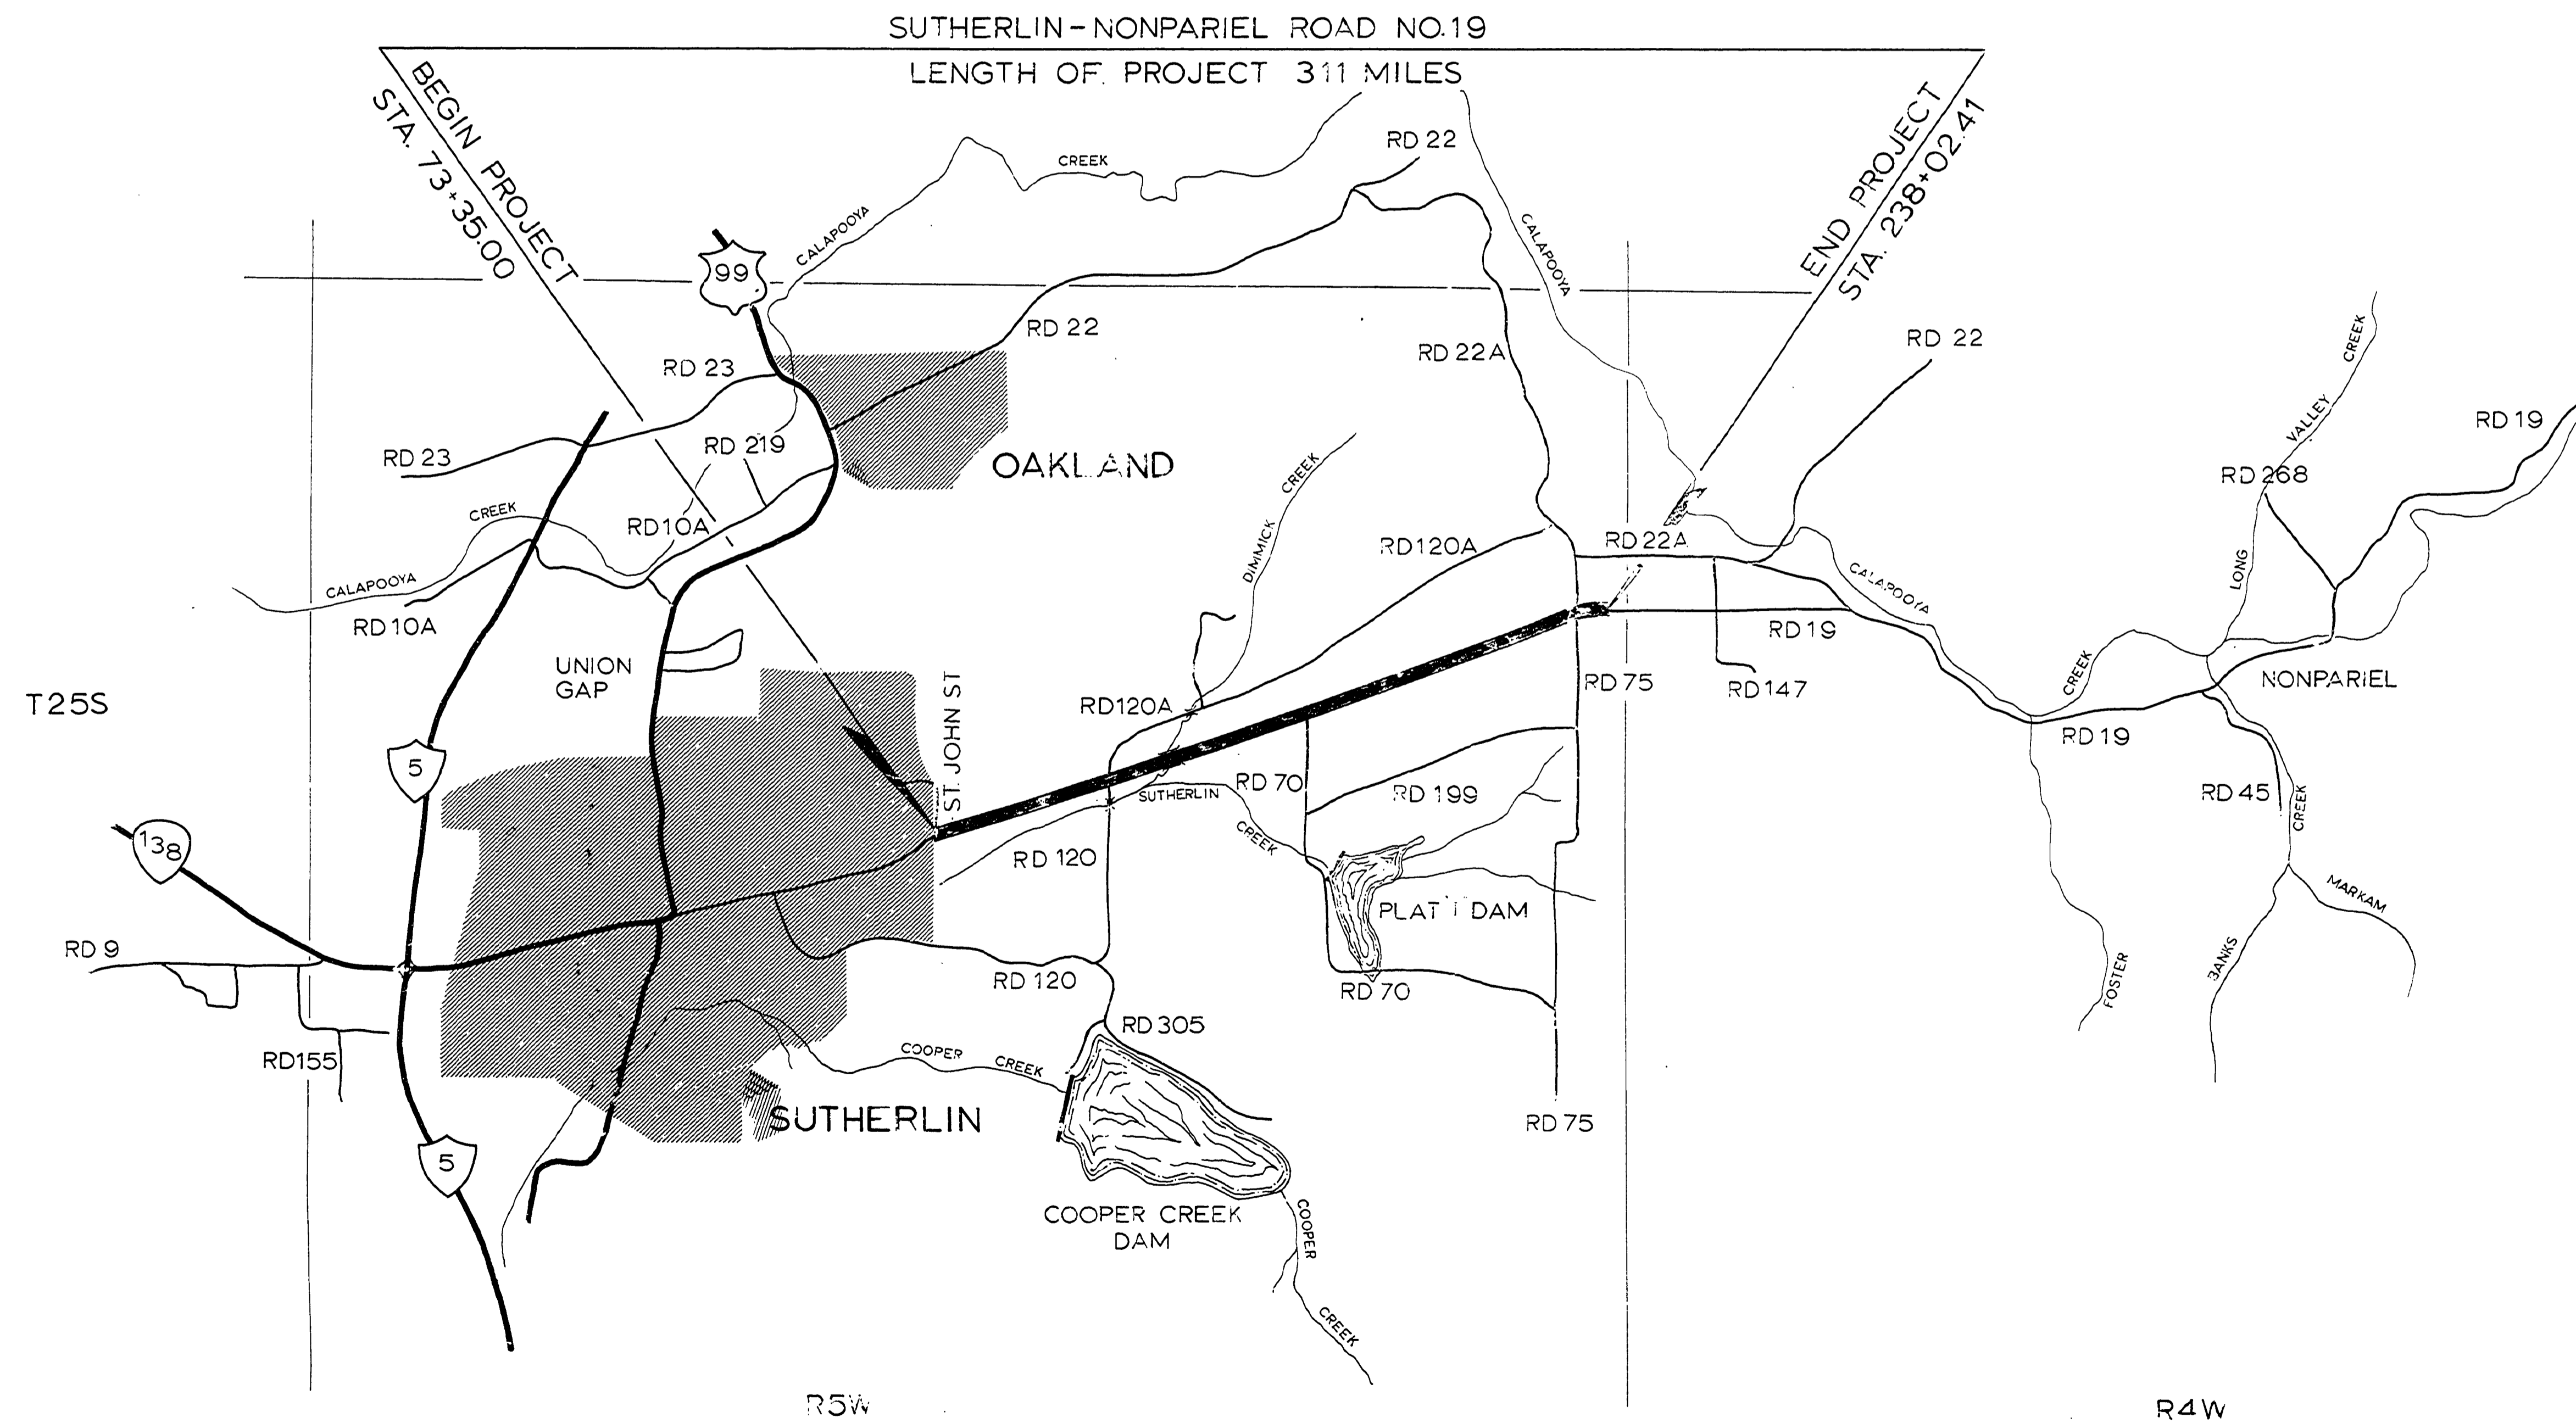

8-29-74
 REVISED AS BUILT P.H.
 DOUGLAS COUNTY ROAD DEPT.
SUTHERLIN-NONPARIEL RD.19
 MAY 1971 SHEET 1 OF 12
 GEORGE E. GRUBB, CO. ENGINEER

0131044C