
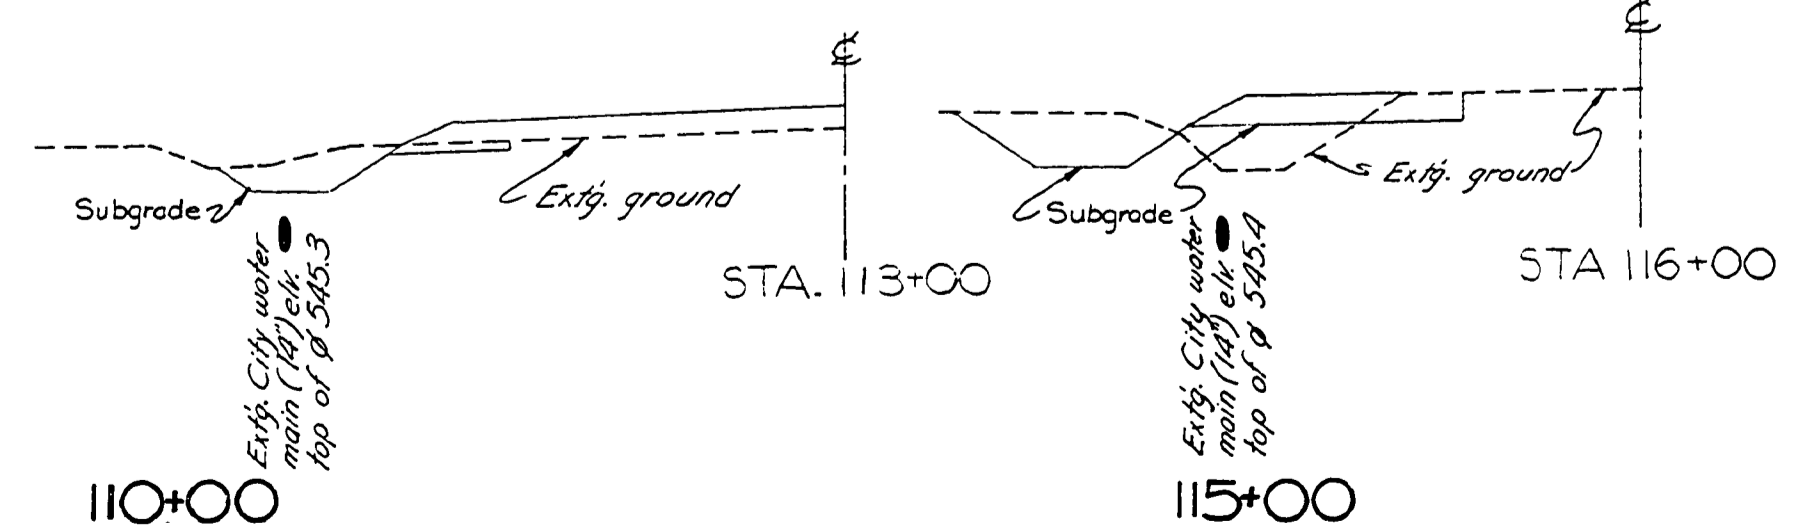
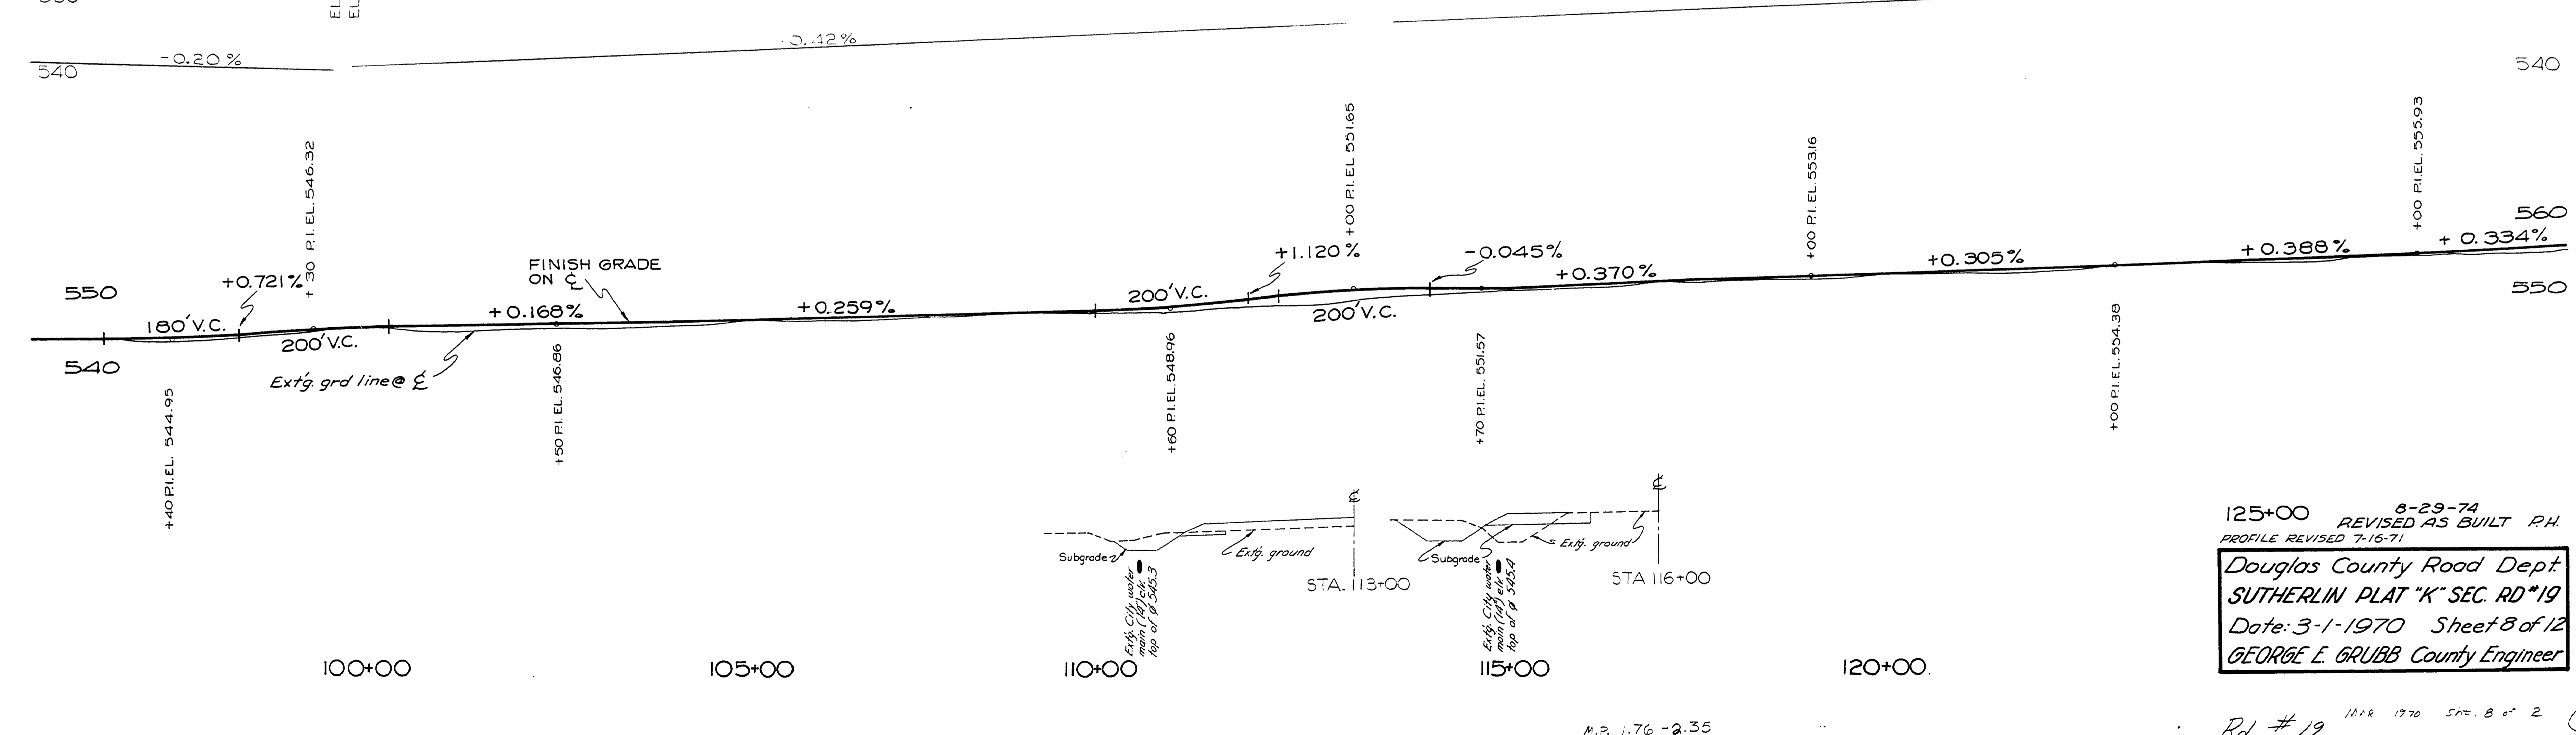


MP 2
Sec. 15 T.25S. R.5W. W.M.

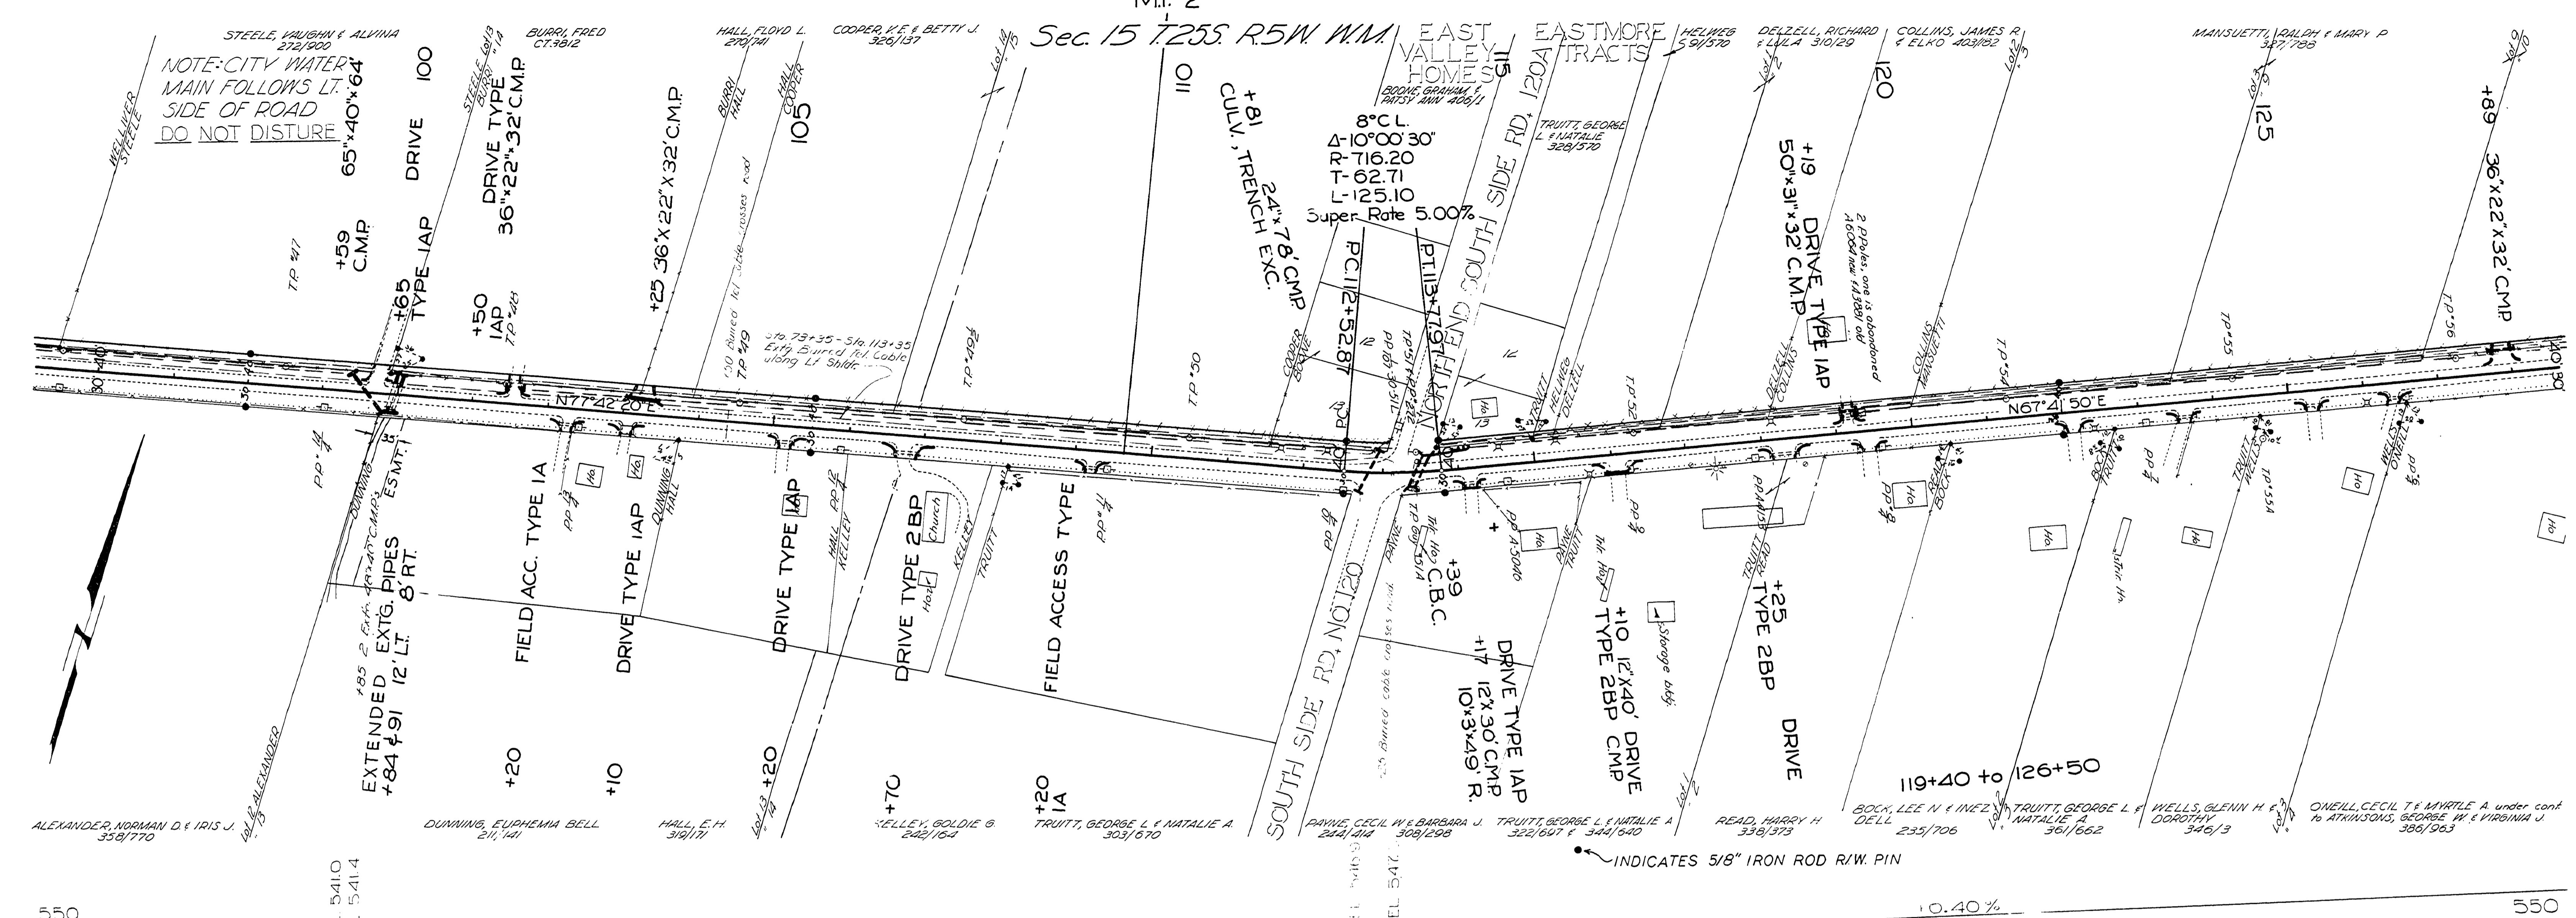

125+00 8-29-74
REVISED AS BUILT P.H.
PROFILE REVISED 7-16-71
Douglas County Road Dept.
SUTHERLIN PLAT "K" SEC. RD #19
Date: 3-1-1970 Sheet 8 of 12
GEORGE E. GRUBB County Engineer

01760235

Rd. # 19 MAR 1970 SHEET 8 OF 12 (40)

M.P. 1.76-2.35