

# DOUGLAS COUNTY OREGON




## PLANS FOR PROPOSED PROJECT

### GRADING & SURFACING

# SUTHERLIN NONPAREIL

## COUNTY ROAD NO.19

### JUNE 1968

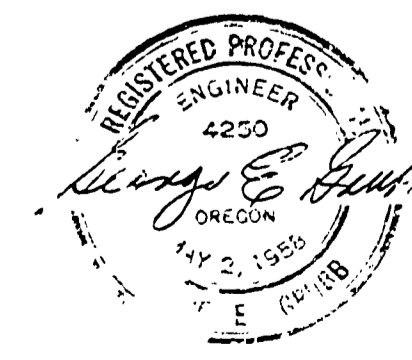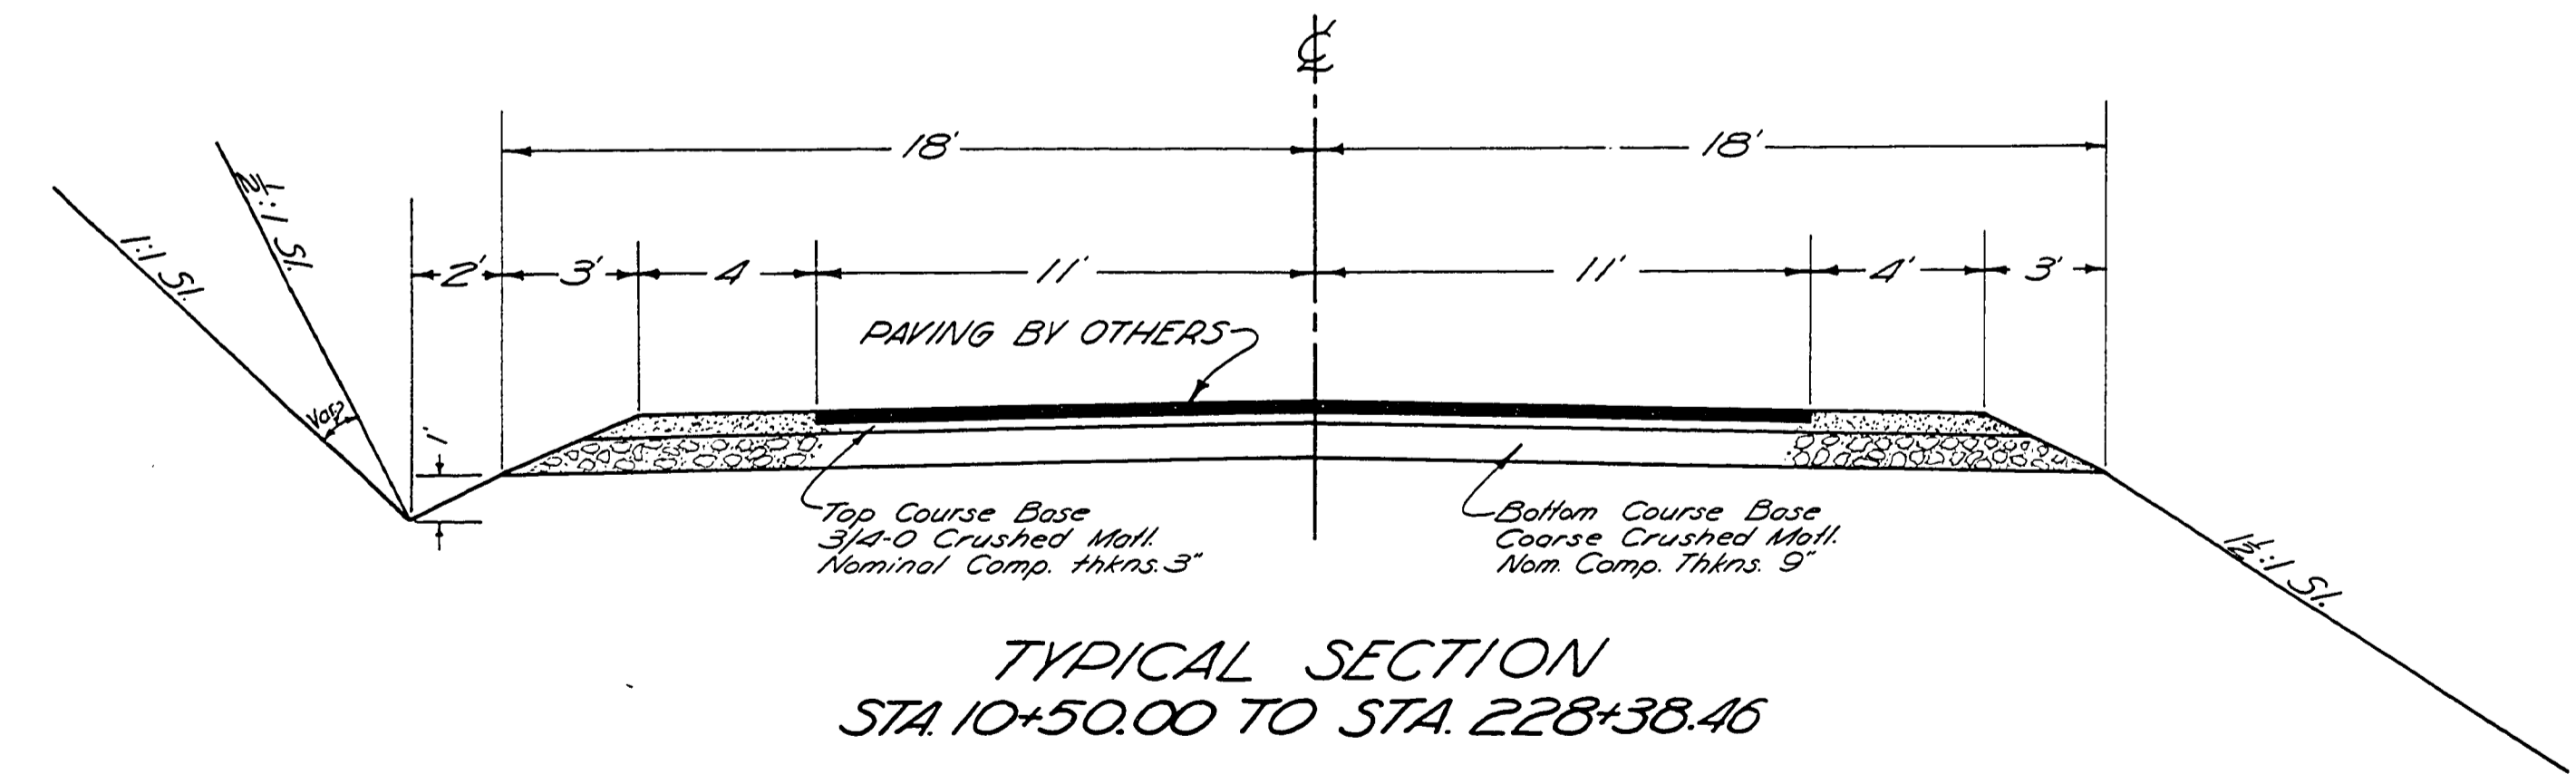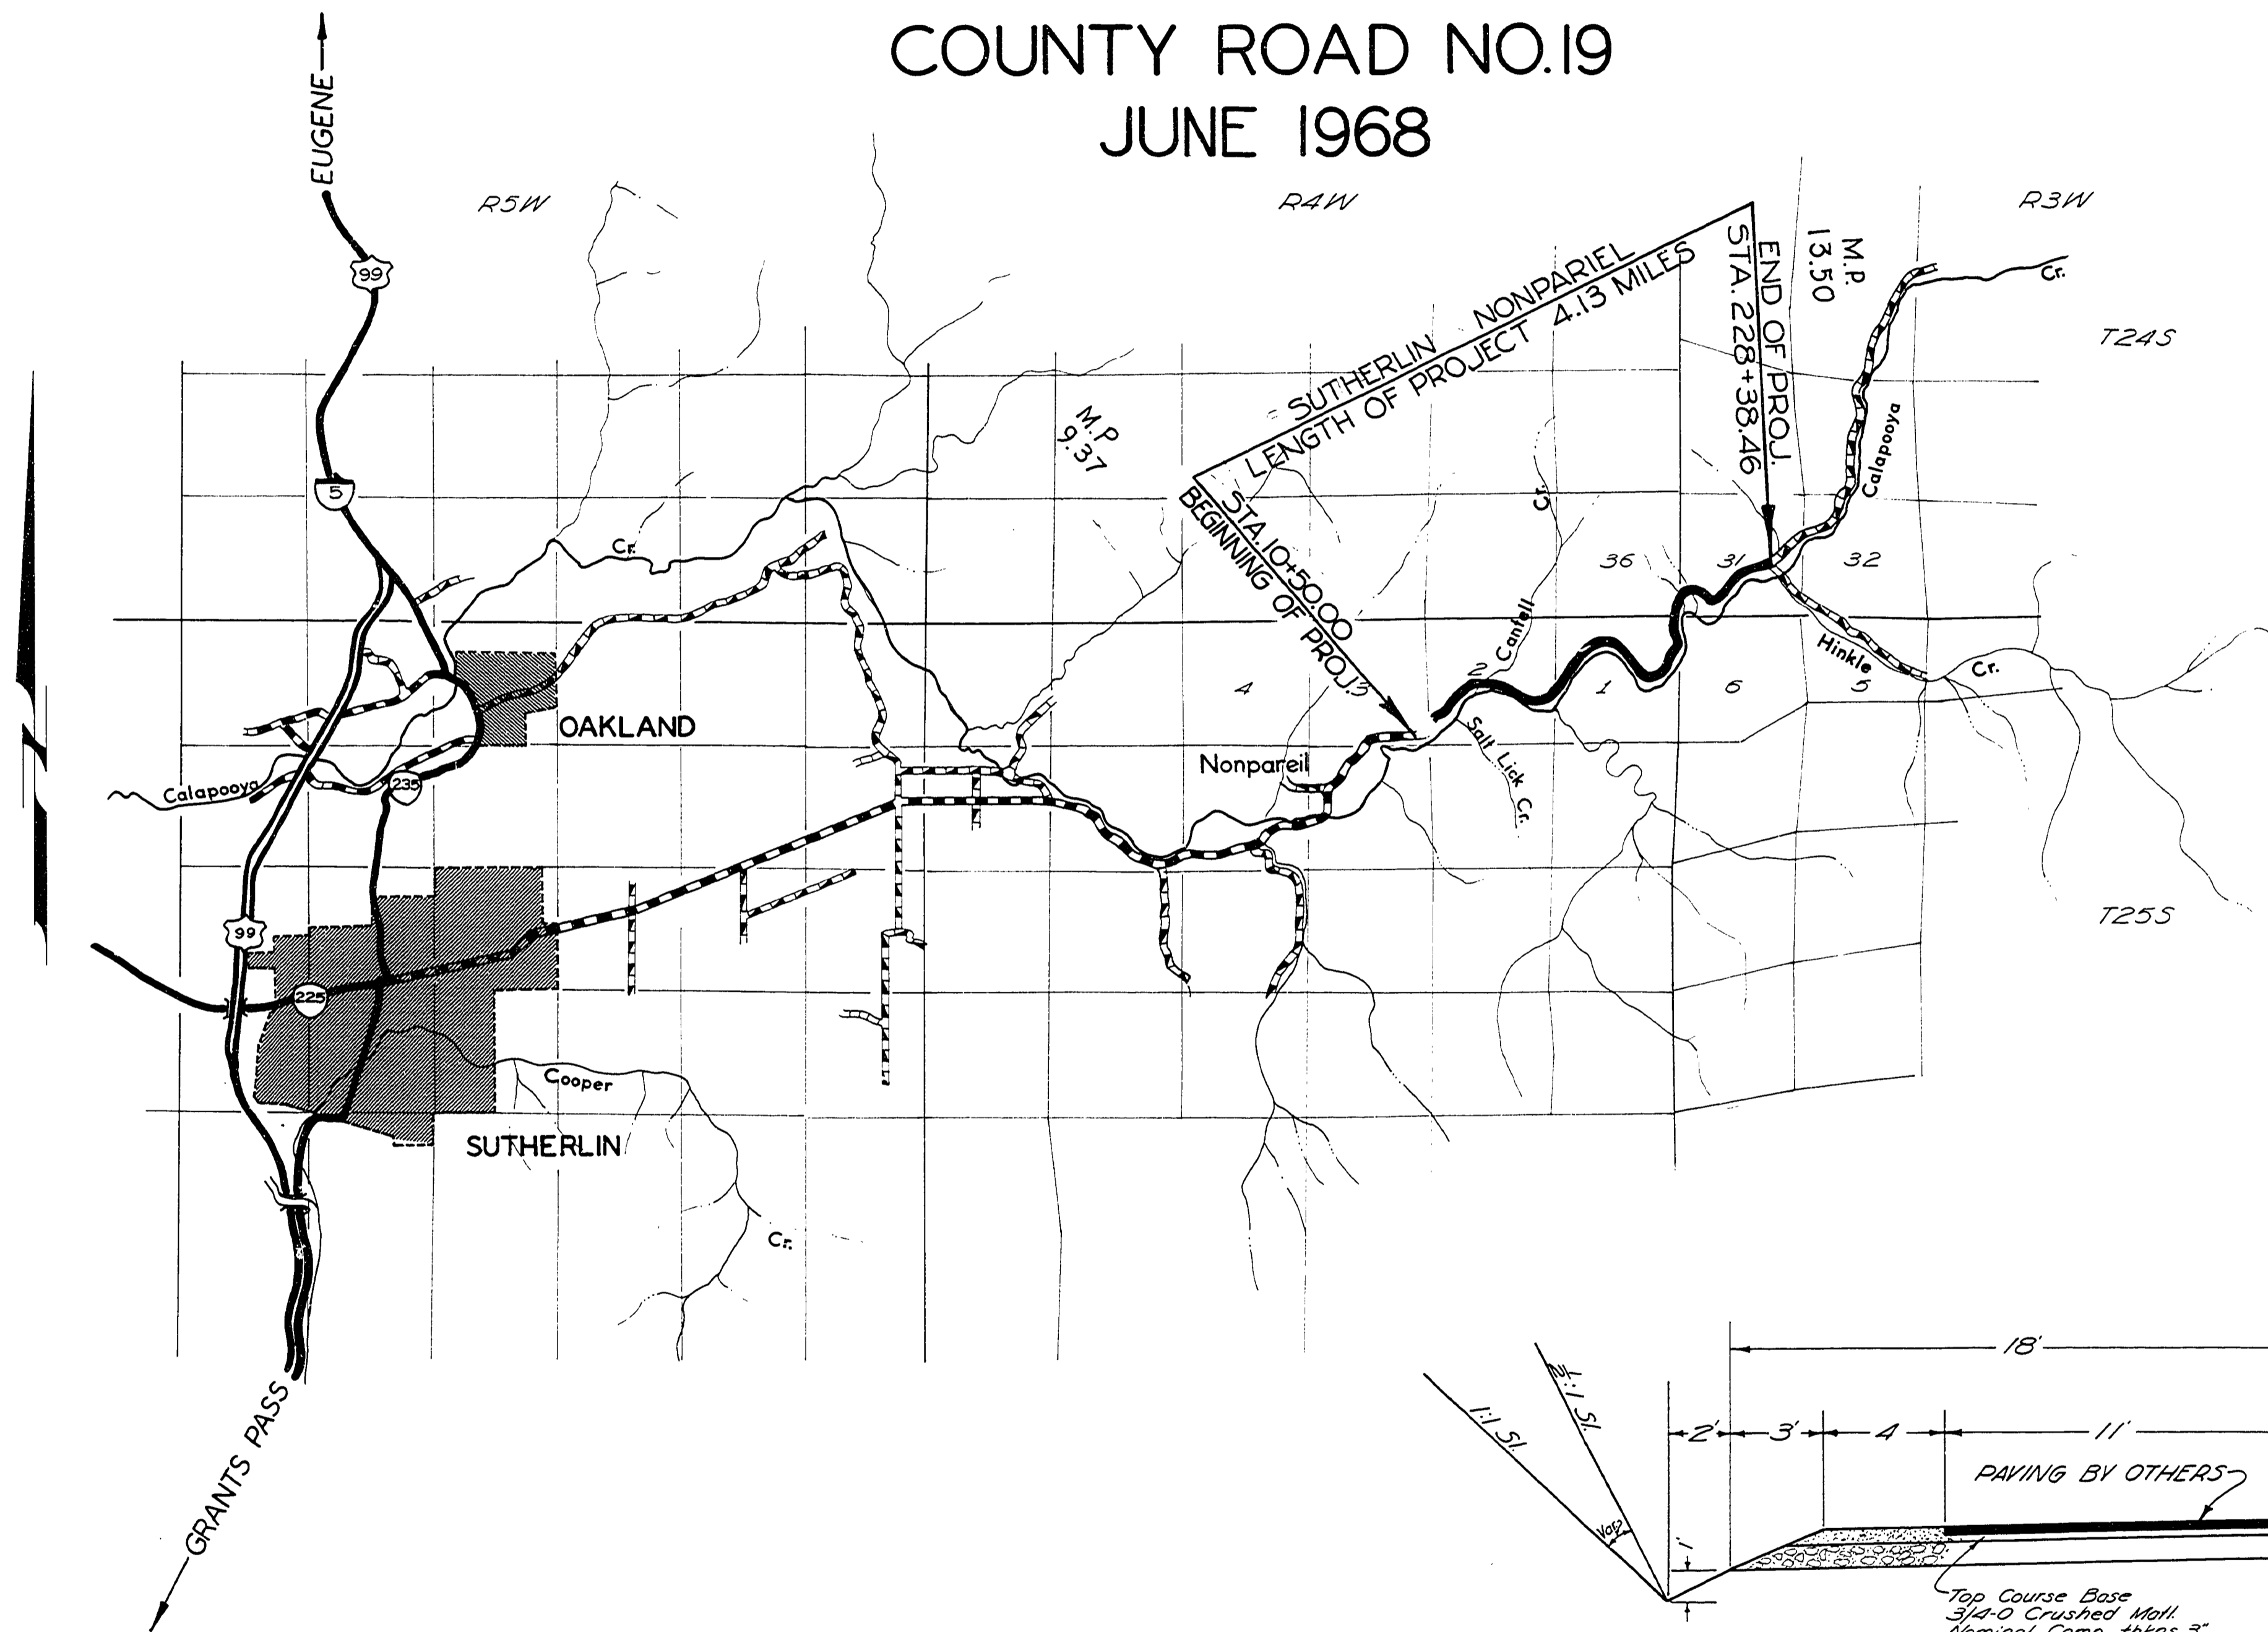

1ST REVISION AS Constructed

Douglas County Road Dept.  
**SUTHERLIN-NONPAREIL #19**  
 DATE: JUNE 1968 SHEET 1 OF 9  
 GEORGE E. GRUBB County Engineer

0937137C