

51-244

INDEX OF SHEETS	
SHEET NO.	DESCRIPTION
1	Title Sheet
2	Summary and Typical Section
3-4	Plan and Profile

DRG. NO.
12151-12154 }
11917 } Structural Plans
S-226 }
S-83 }
2050- Miscellaneous Structures

STATE OF OREGON
STATE HIGHWAY DEPARTMENT
PLANS FOR PROPOSED PROJECT

BRIDGE, GRADING AND SURFACING


YOKUM BRIDGE SECTION
YOCUM ROAD
DOUGLAS COUNTY
SEPT., 1955

YOKUM BRIDGE SECTION YOCUM ROAD DOUGLAS COUNTY				SHEET No. 1
FED. ROAD Div. No.	STATE	PROJECT NUMBER	FISCAL YEAR	TOTAL SHEETS
8	OREGON	S-302(1)		See Index

REVISED AS CONSTRUCTED
5-57 CONTRACT 4937


- CONVENTIONAL SIGNS
- State Line
 - County Line
 - City or Town Limits
 - Township Line
 - Section Line
 - Donation Land Claim Line
 - Fence Line
 - Guard Rail
 - (Unfenced Property or Right of Way Line
 - Existing Roads
 - Trails
 - Base or Survey Line
 - Railroads
 - Retaining Wall
 - Culverts
 - Drop Inlet
 - Trolley Pole
 - Power Pole
 - Telephone or Telegraph Poles
 - Marsh
 - Irrigation Ditches
 - Bridges
 - Trees

FILED
RECEIVED
NOV 7 1957
COUNTY SURVEYOR
DOUGLAS COUNTY, ORE.

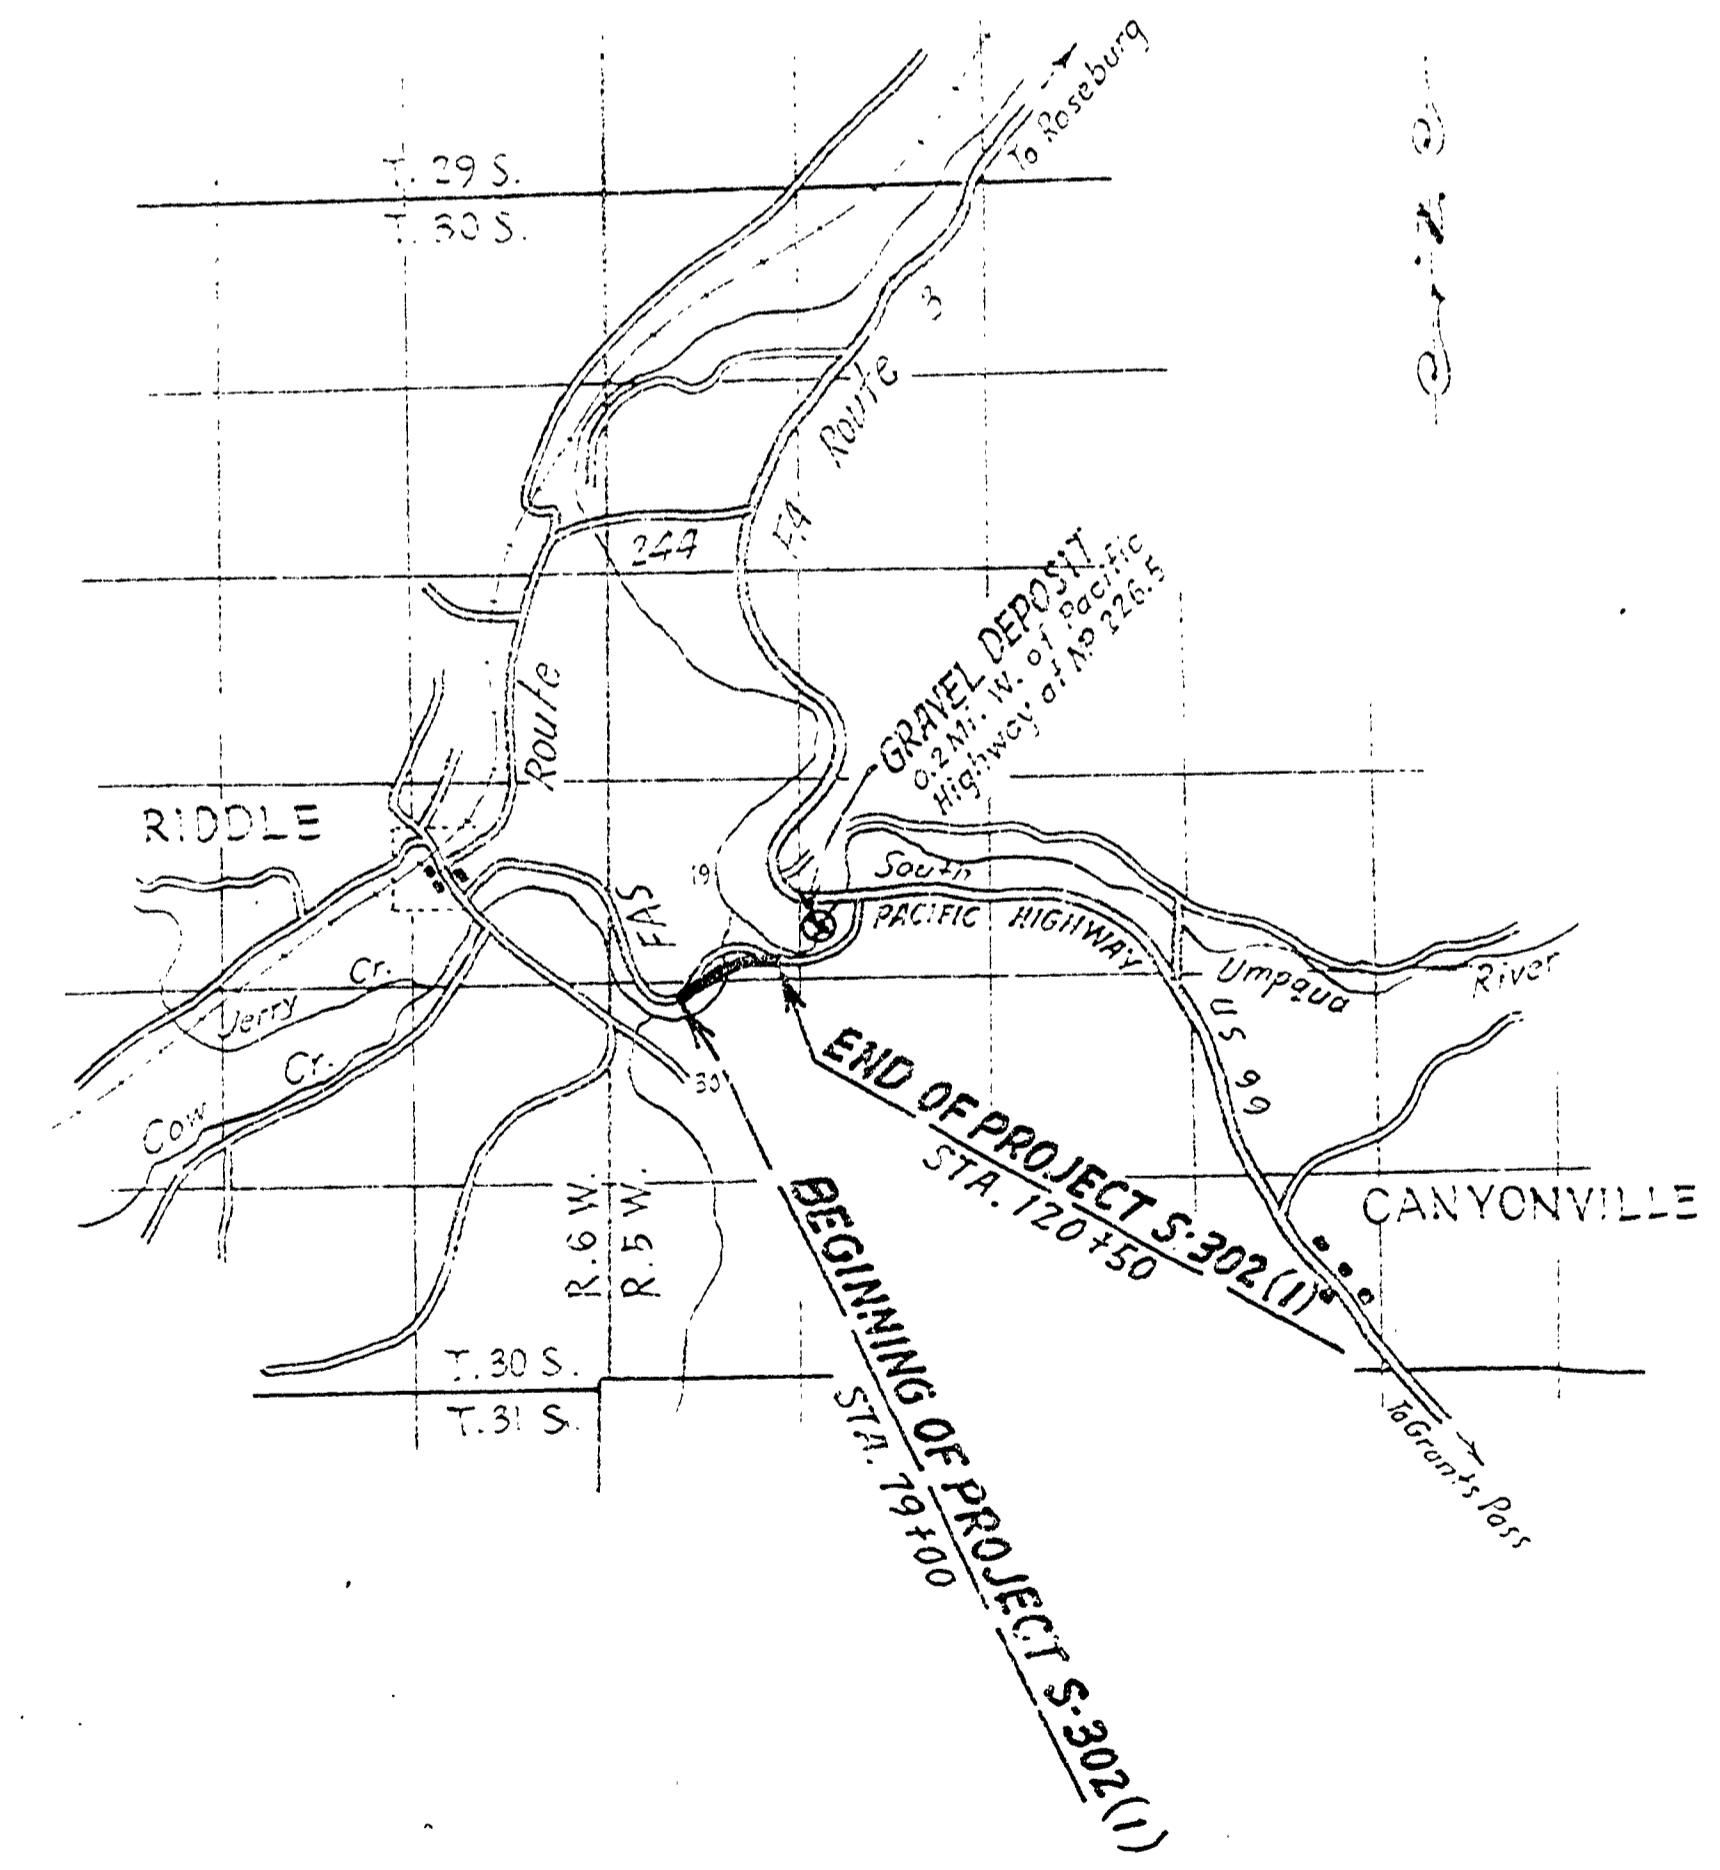

Sketch Map
Scale 0 1 2 Miles

W. D. ...

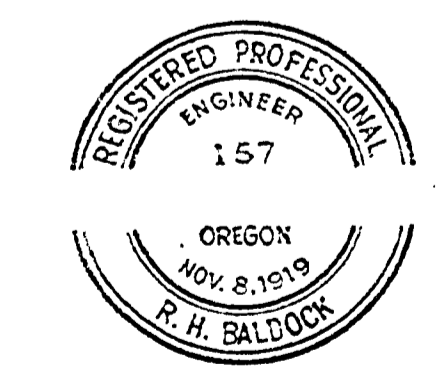

STATE HIGHWAY COMMISSION
Chairman
Commissioner
Commissioner

W. D. ...
STATE HIGHWAY ENGINEER

DEPARTMENT OF COMMERCE
BUREAU OF PUBLIC ROADS

APPROVED: _____
DISTRICT ENGINEER DATE: _____

01760260