
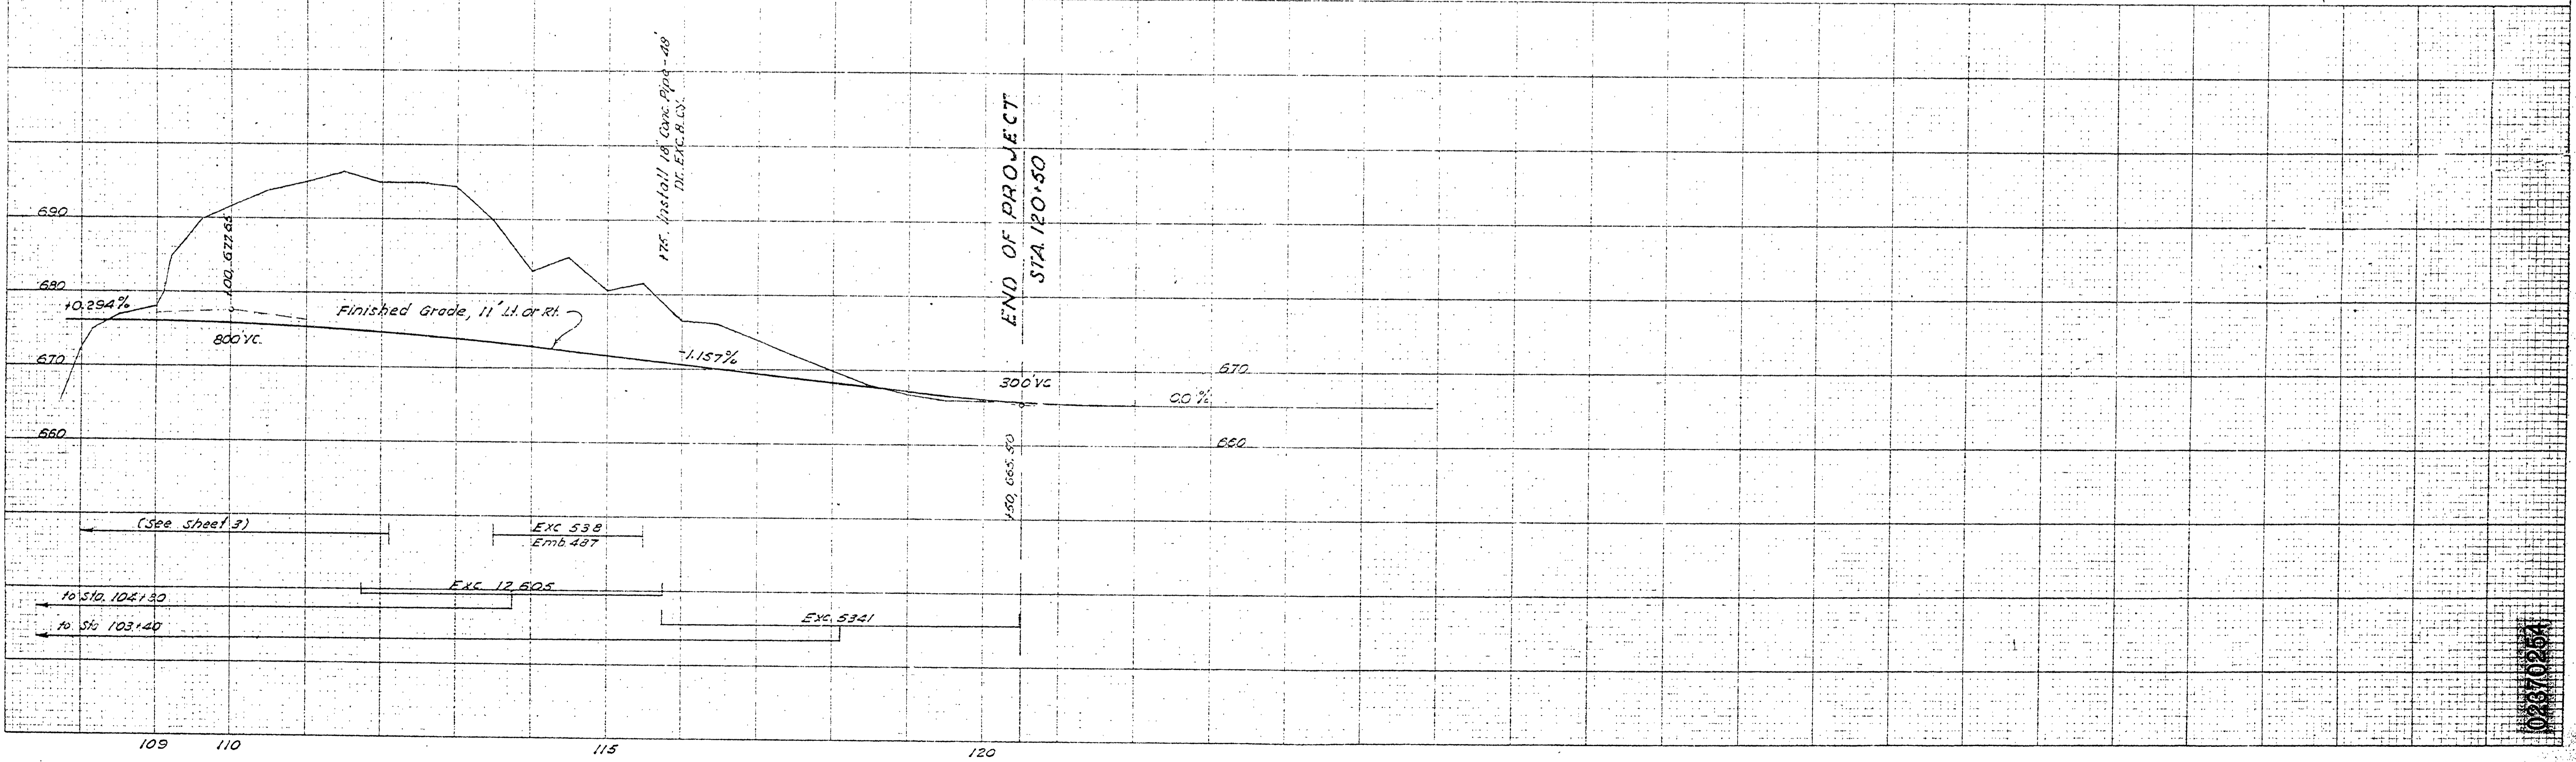


Sec. 19, T.30S., R.5W., W.M.

FILED  
RECEIVED  
NOV 7 1967  
COUNTY SURVEYOR  
DOUGLAS COUNTY, ORE

YOKUM BRIDGE SECTION				SHEET No. 4
YOKUM ROAD				TOTAL SHEETS
DOUGLAS COUNTY				See Index
FED. ROAD Div. No.	STATE	PROJECT NUMBER	FISCAL YEAR	
8	OREGON	S-302(1)		
REVISED AS CONSTRUCTED				
S-57 CONTRACT 2597				

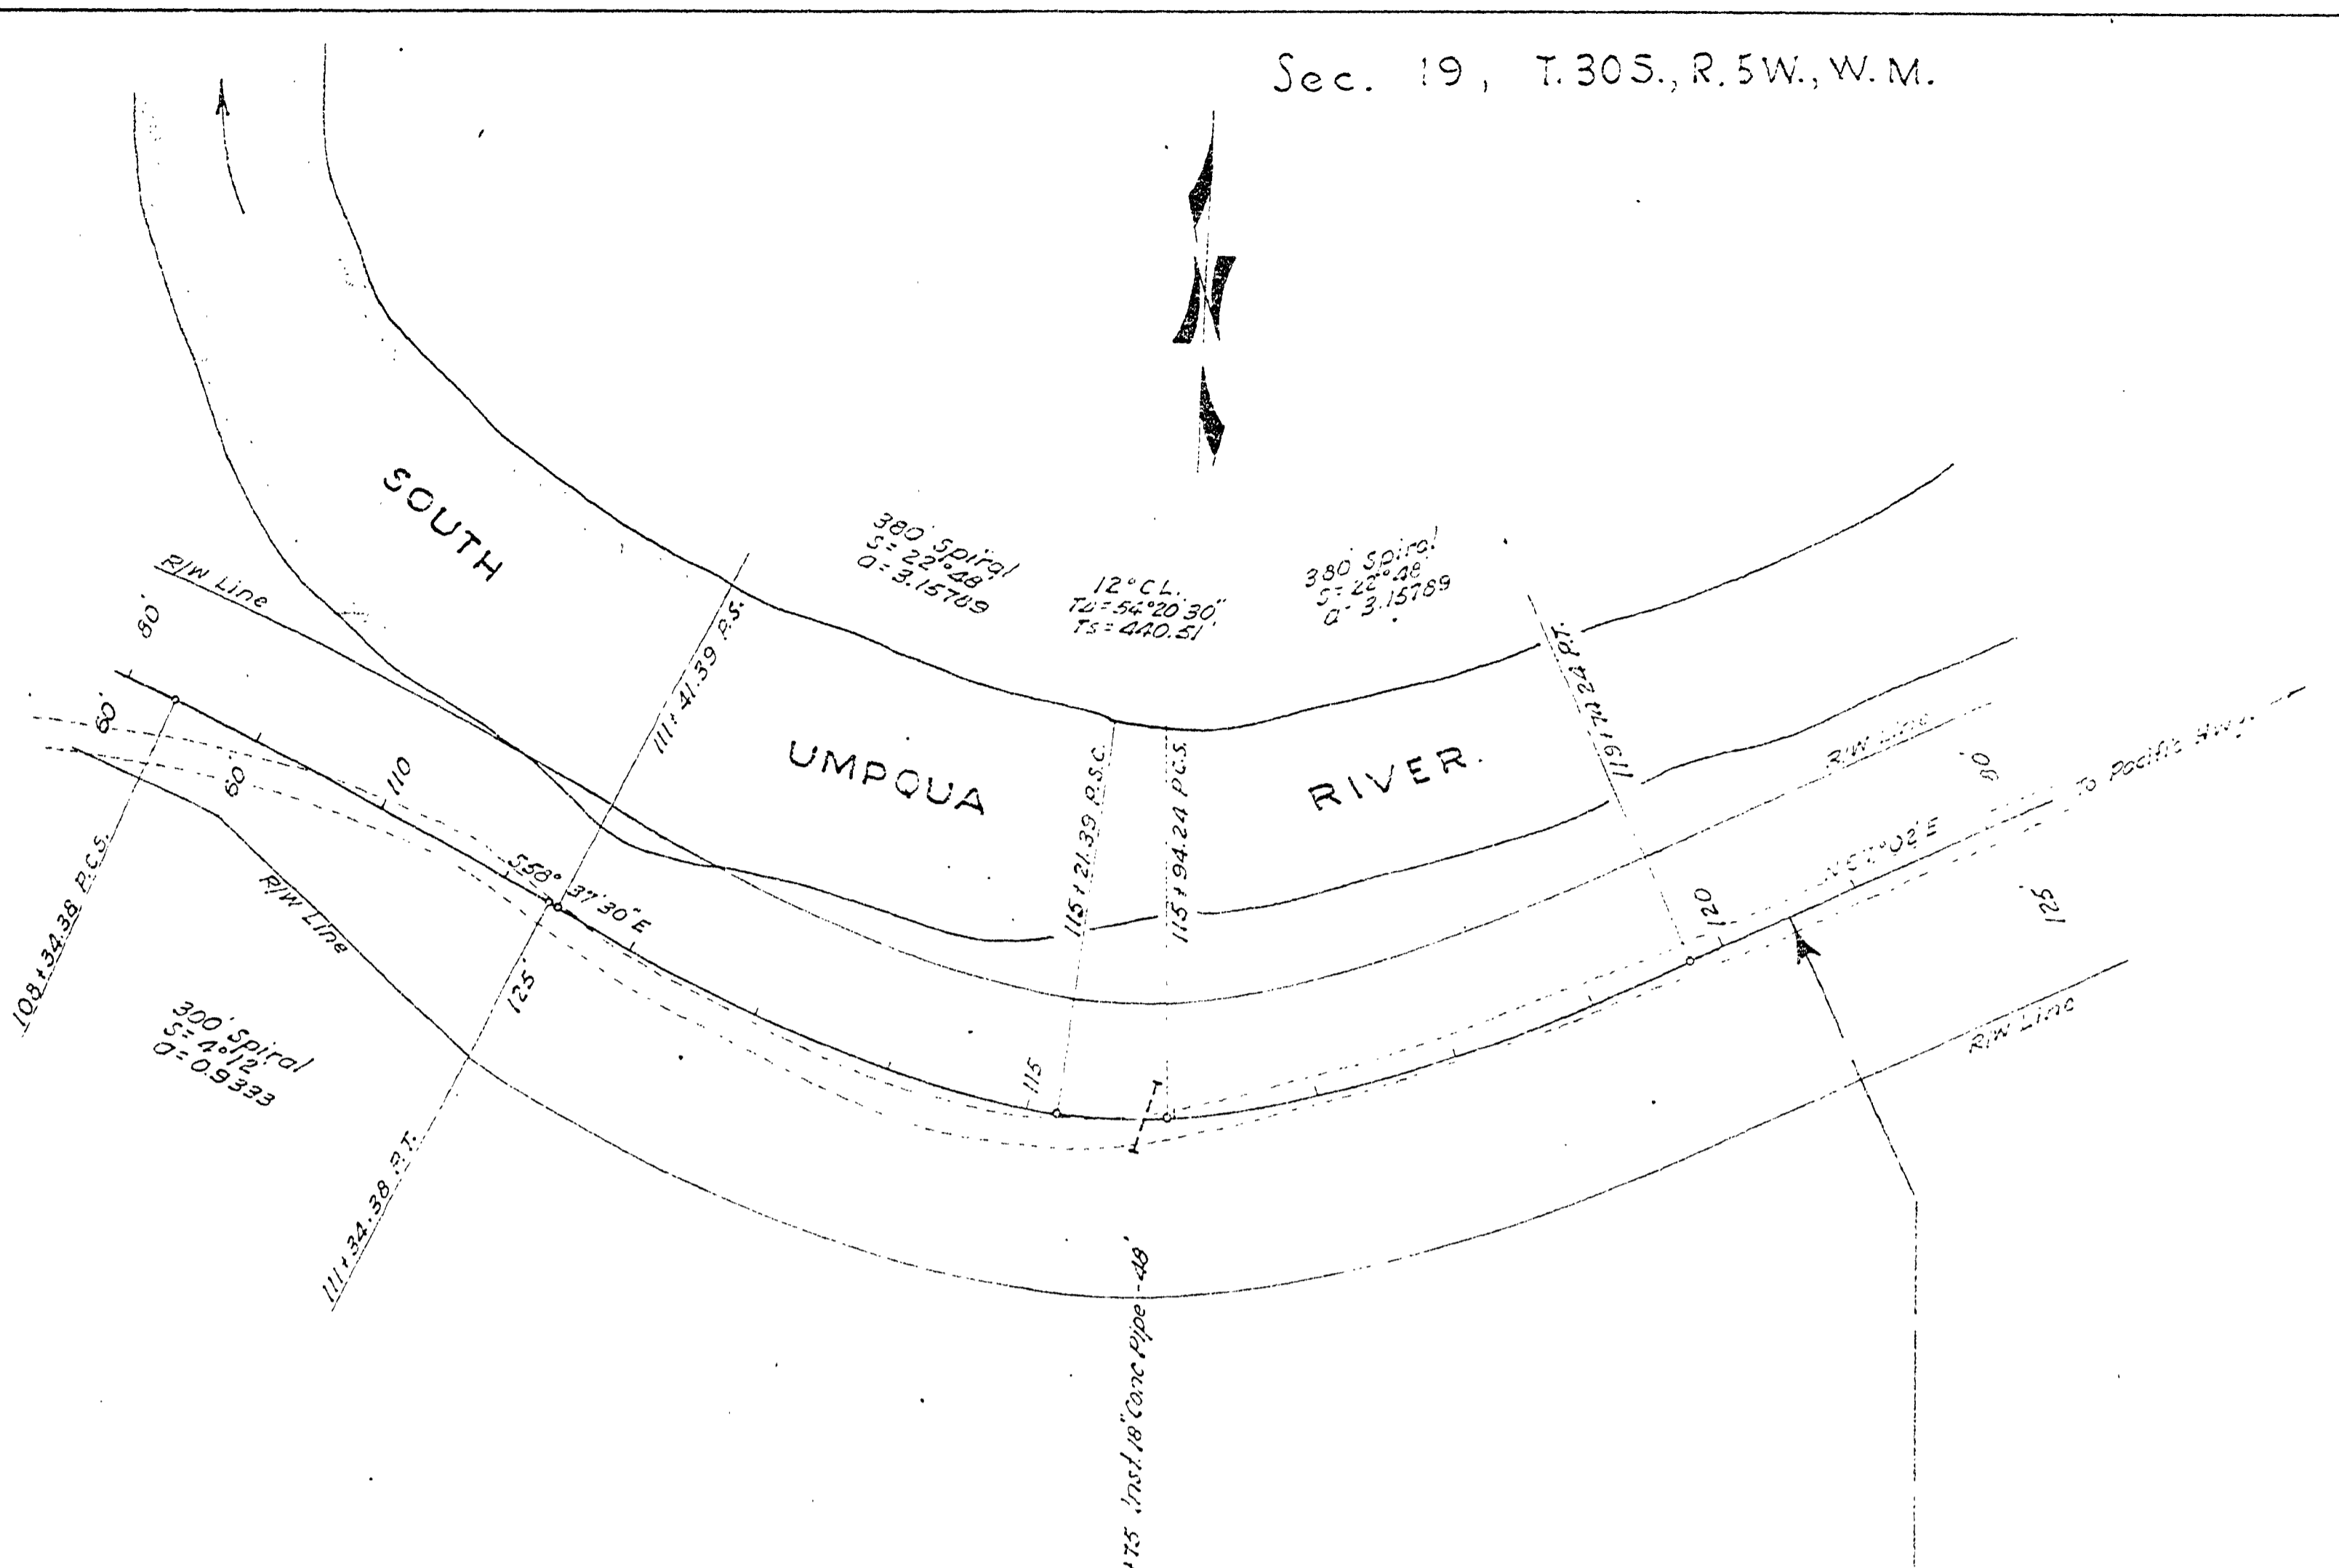

FINAL SURVEY NOTE BOOK NO.

ORIGINAL SURVEY NOTE BOOK NO.

02370254