



SEC. 30 T. 30 S. R. 5 W. W. M. 6

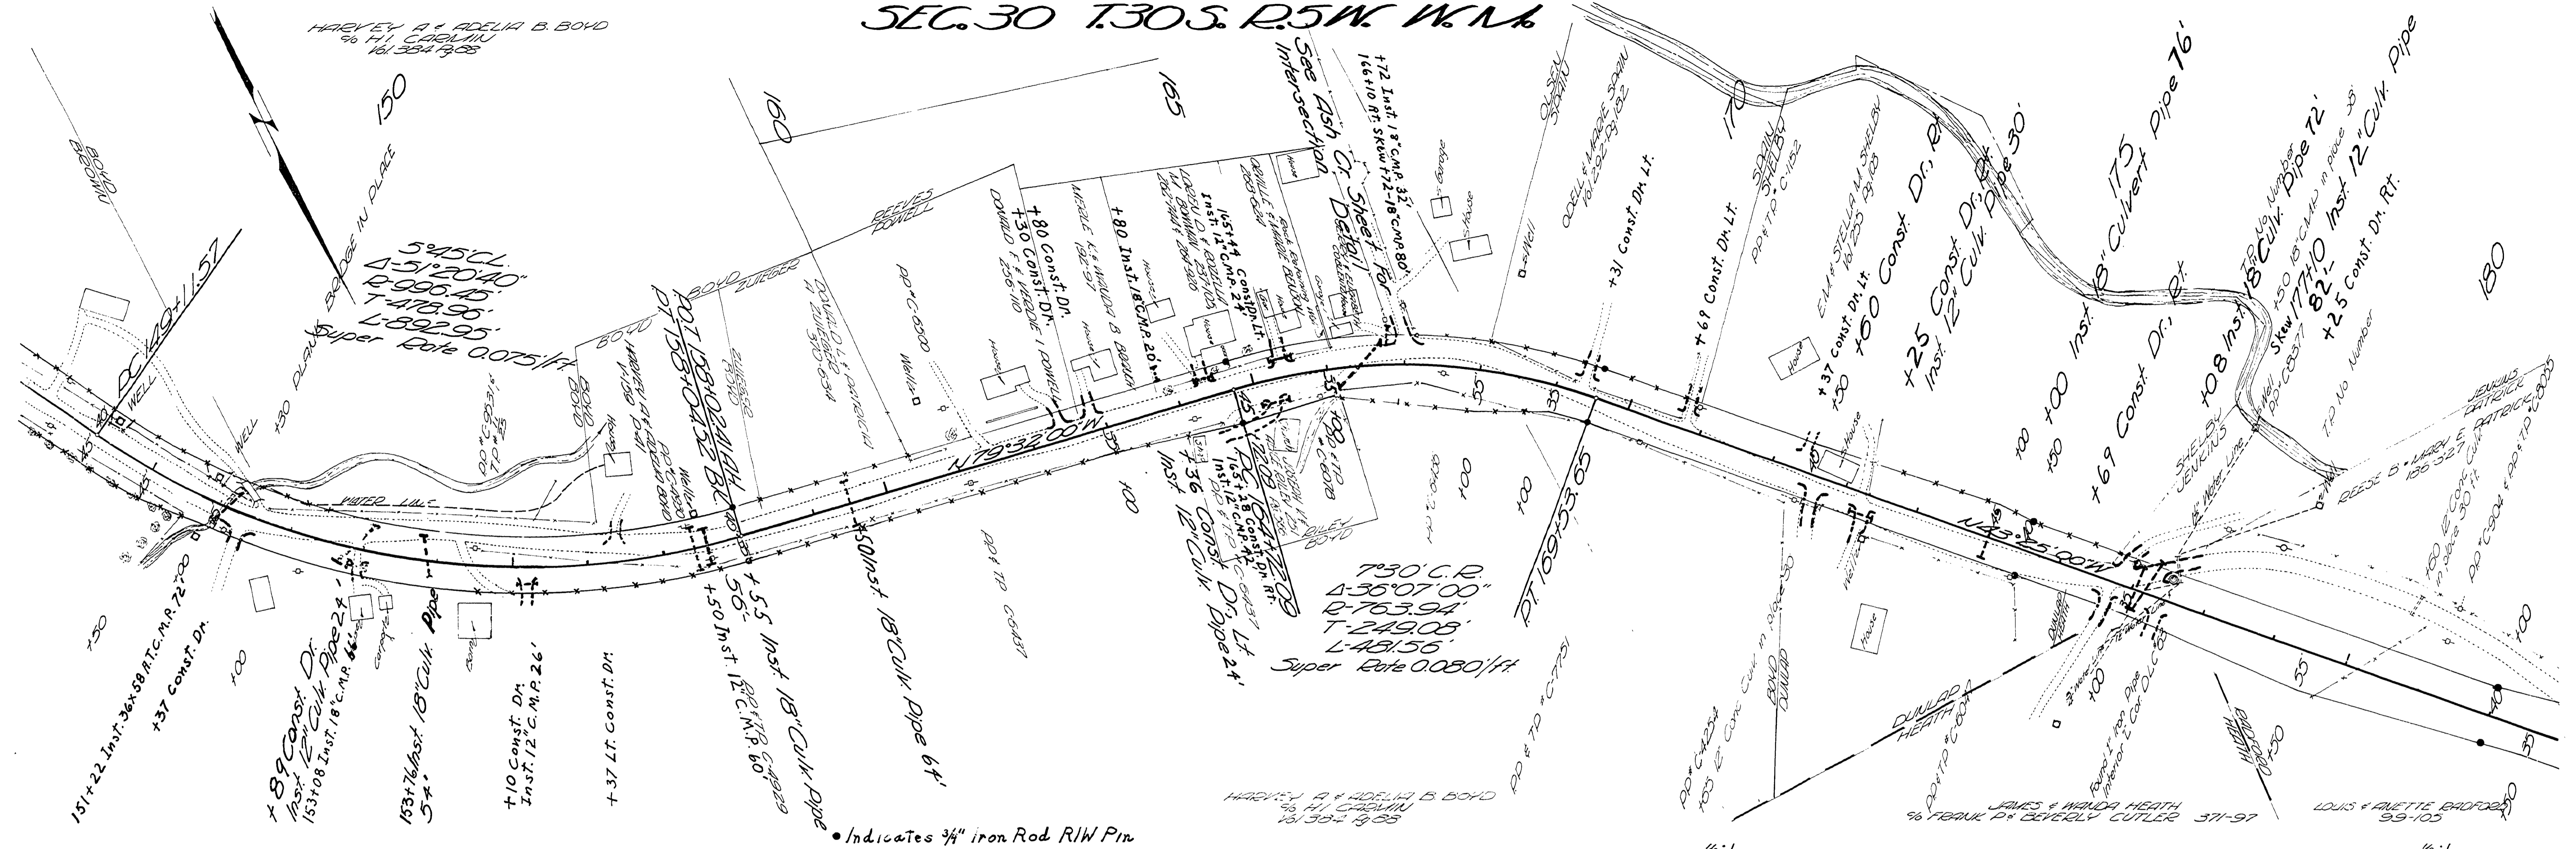

• Indicates 3/4" iron Rod R/W Pin

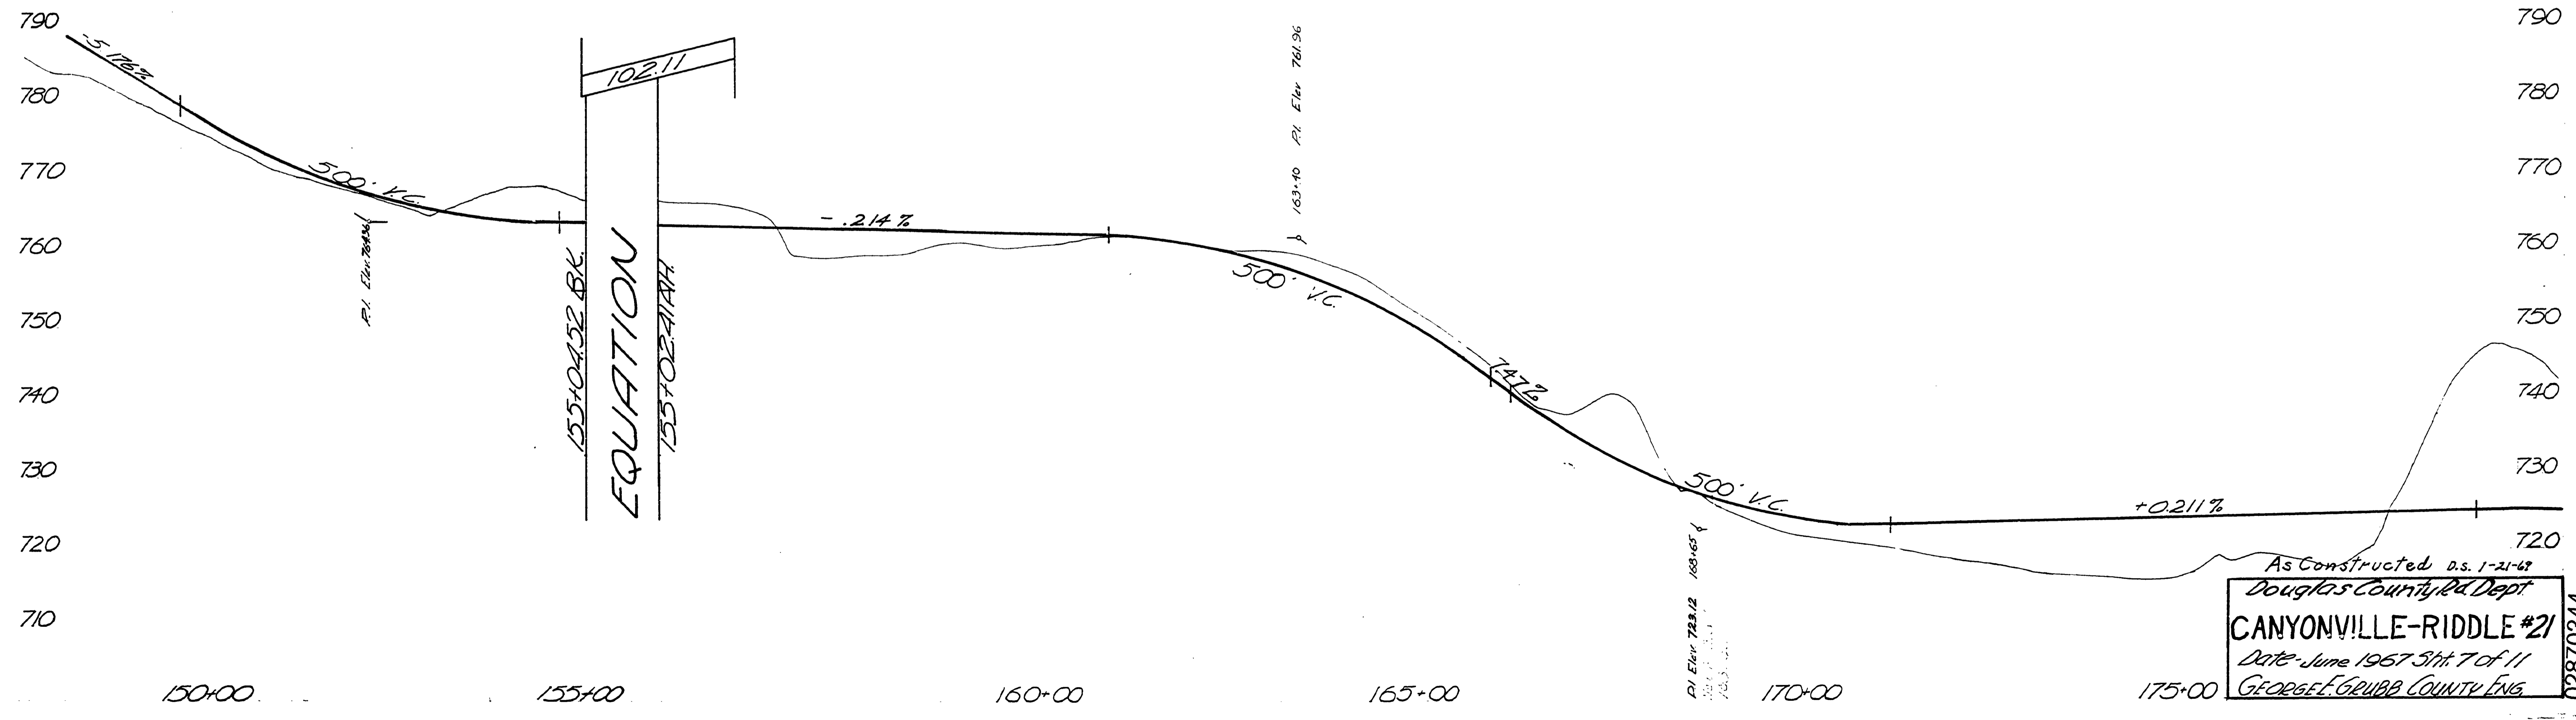

M.P. 2.87-3.44

02870344