


Brown indicates construction line. Red indicates construction line. ● Indicates 3/4" Iron Rod R/W Pin



As Constructed - 1-22-69 D.S.
 Douglas County Rd Dept
CANYONVILLE-RIDDLE #21
 Date - June 1967 5th of 11
 GEORGE E. GRUBB COUNTY ENG.

04580493

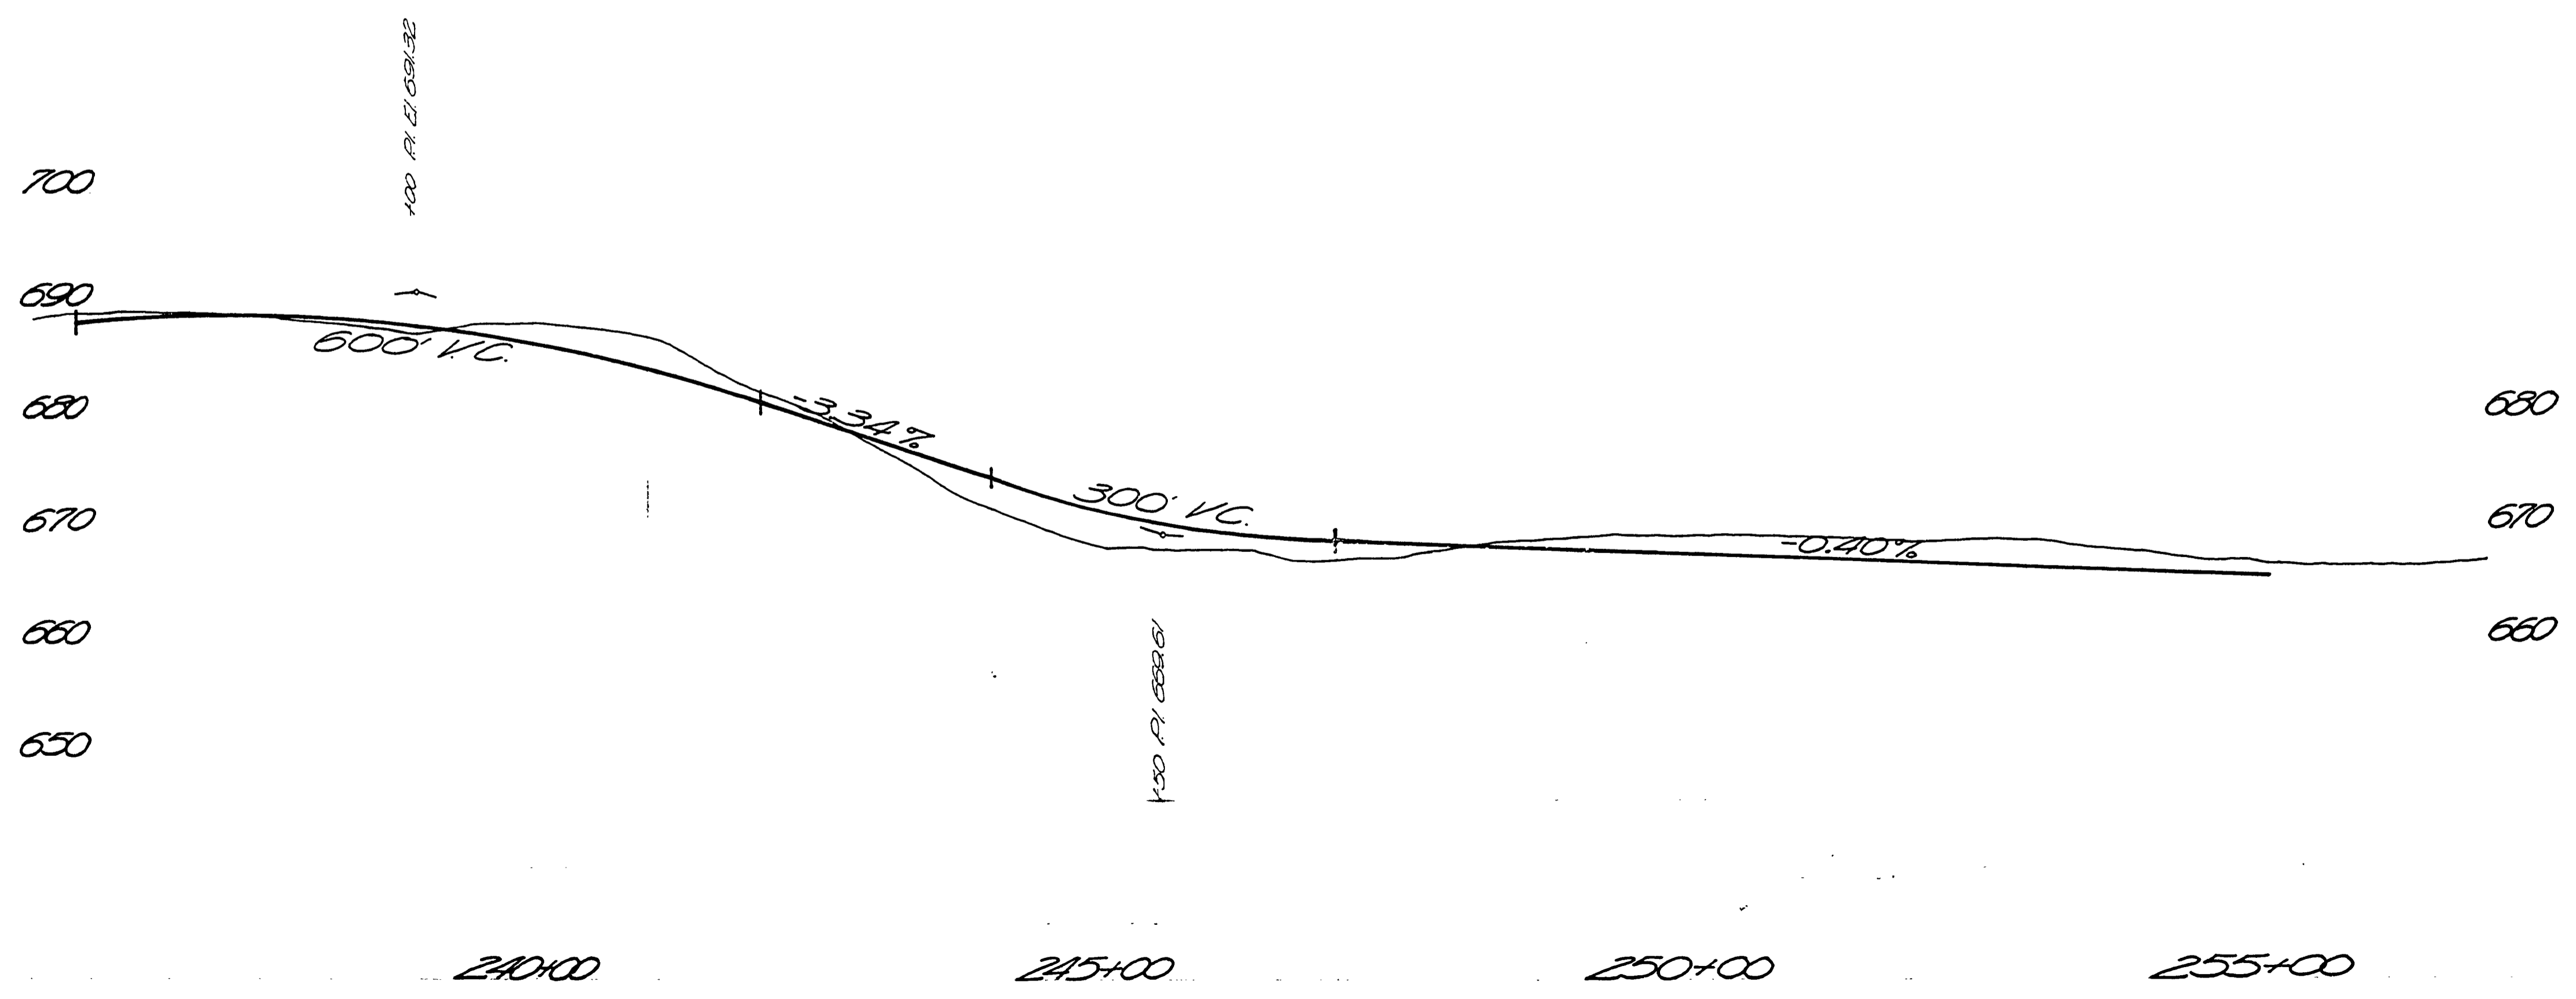