

# DOUGLAS COUNTY OREGON


## PLANS FOR PROPOSED PROJECT

### GRADING & SURFACING

# OAK STREET



## COUNTY ROAD #22

### JANUARY 1966

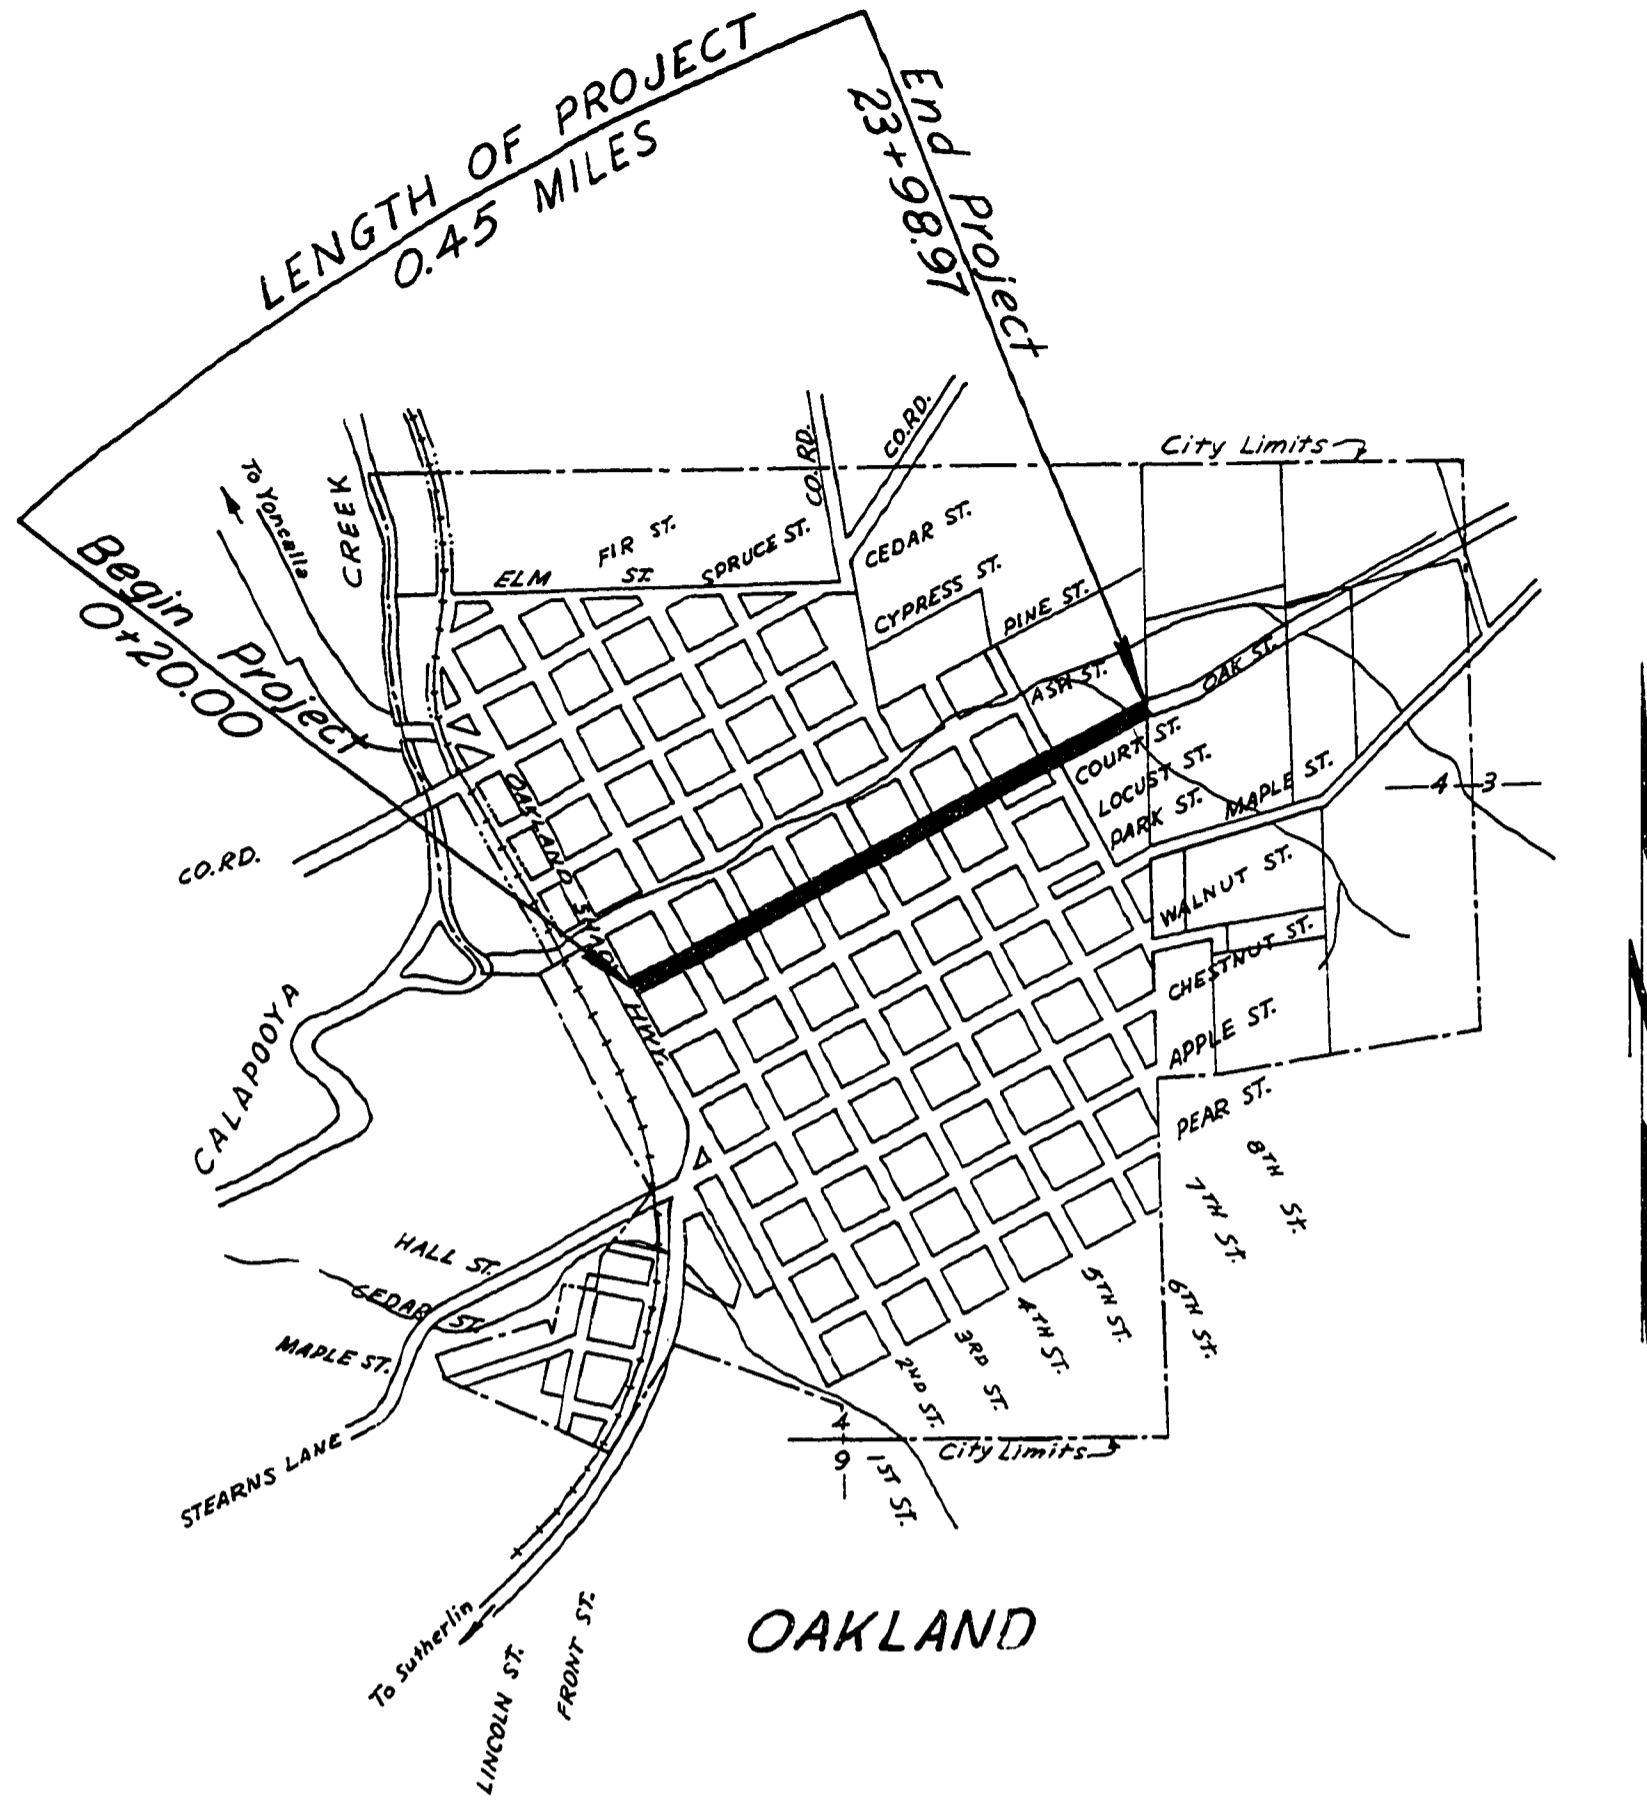

VICINITY MAP

TYPICAL SECTIONS

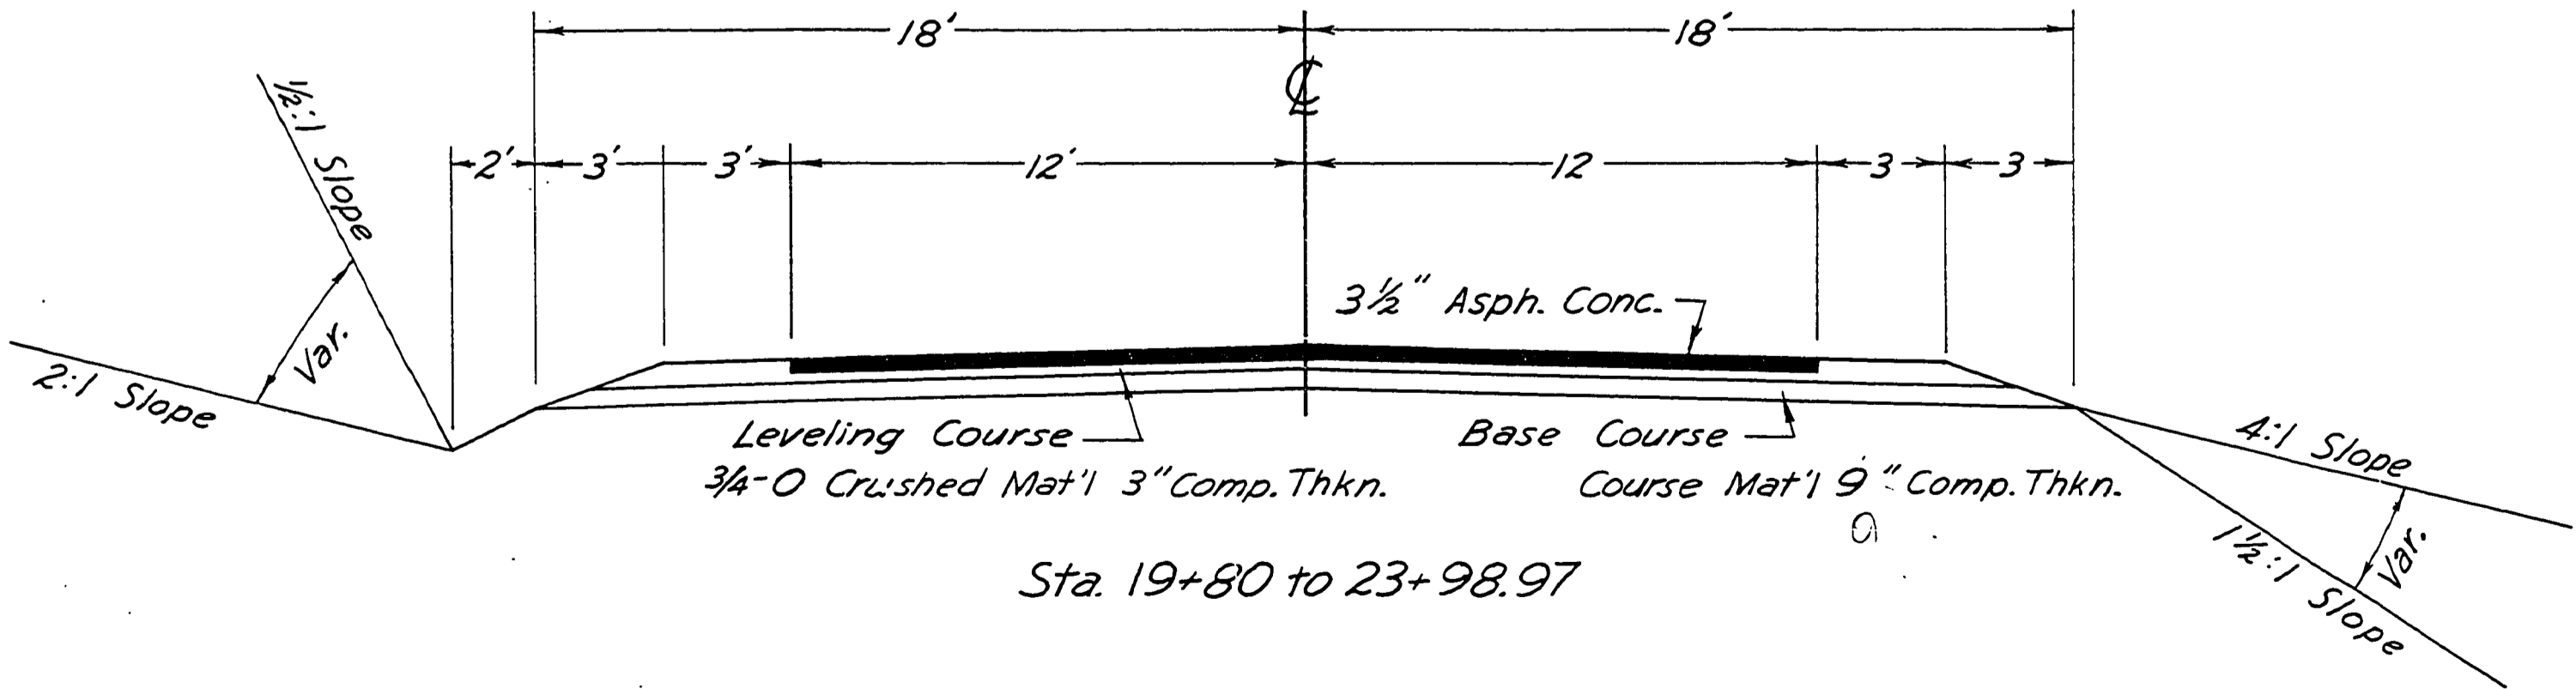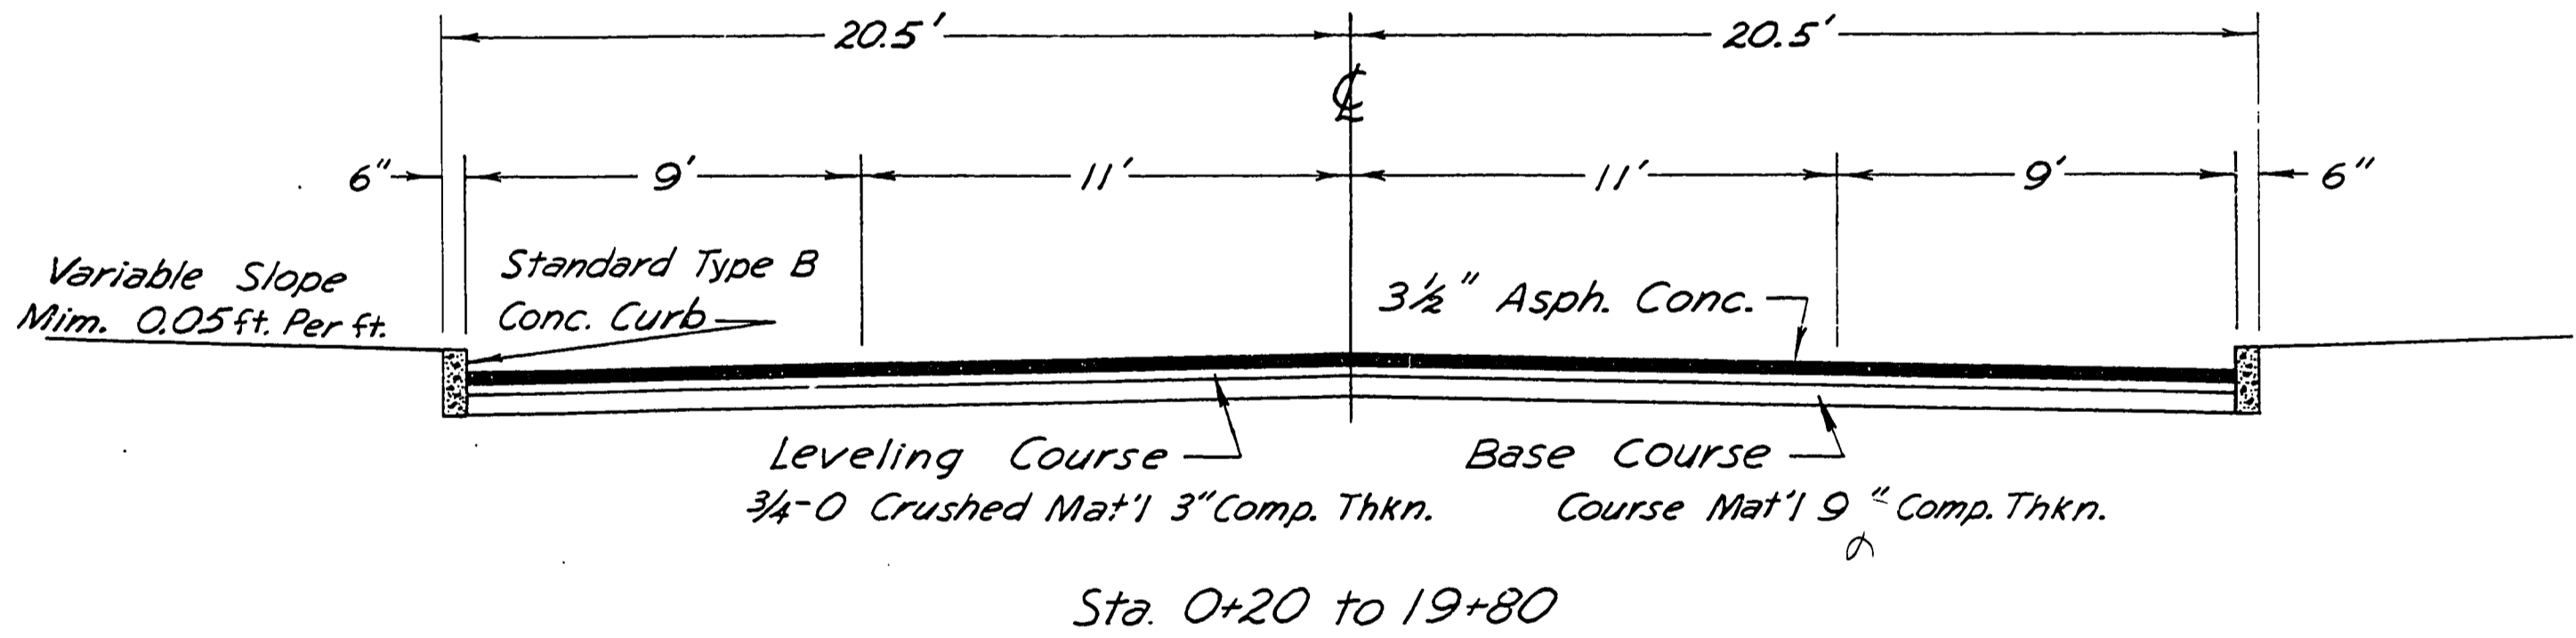

FILED  
RECEIVED  
JAN 16 1966  
COUNTY SURVEYOR  
DOUGLAS COUNTY, OREGON  
As Constructed 11-16-65  
Sheet 1 of 3

Co Rd. # 22 January 1966 SH. 1 of 3

0000005C

96