
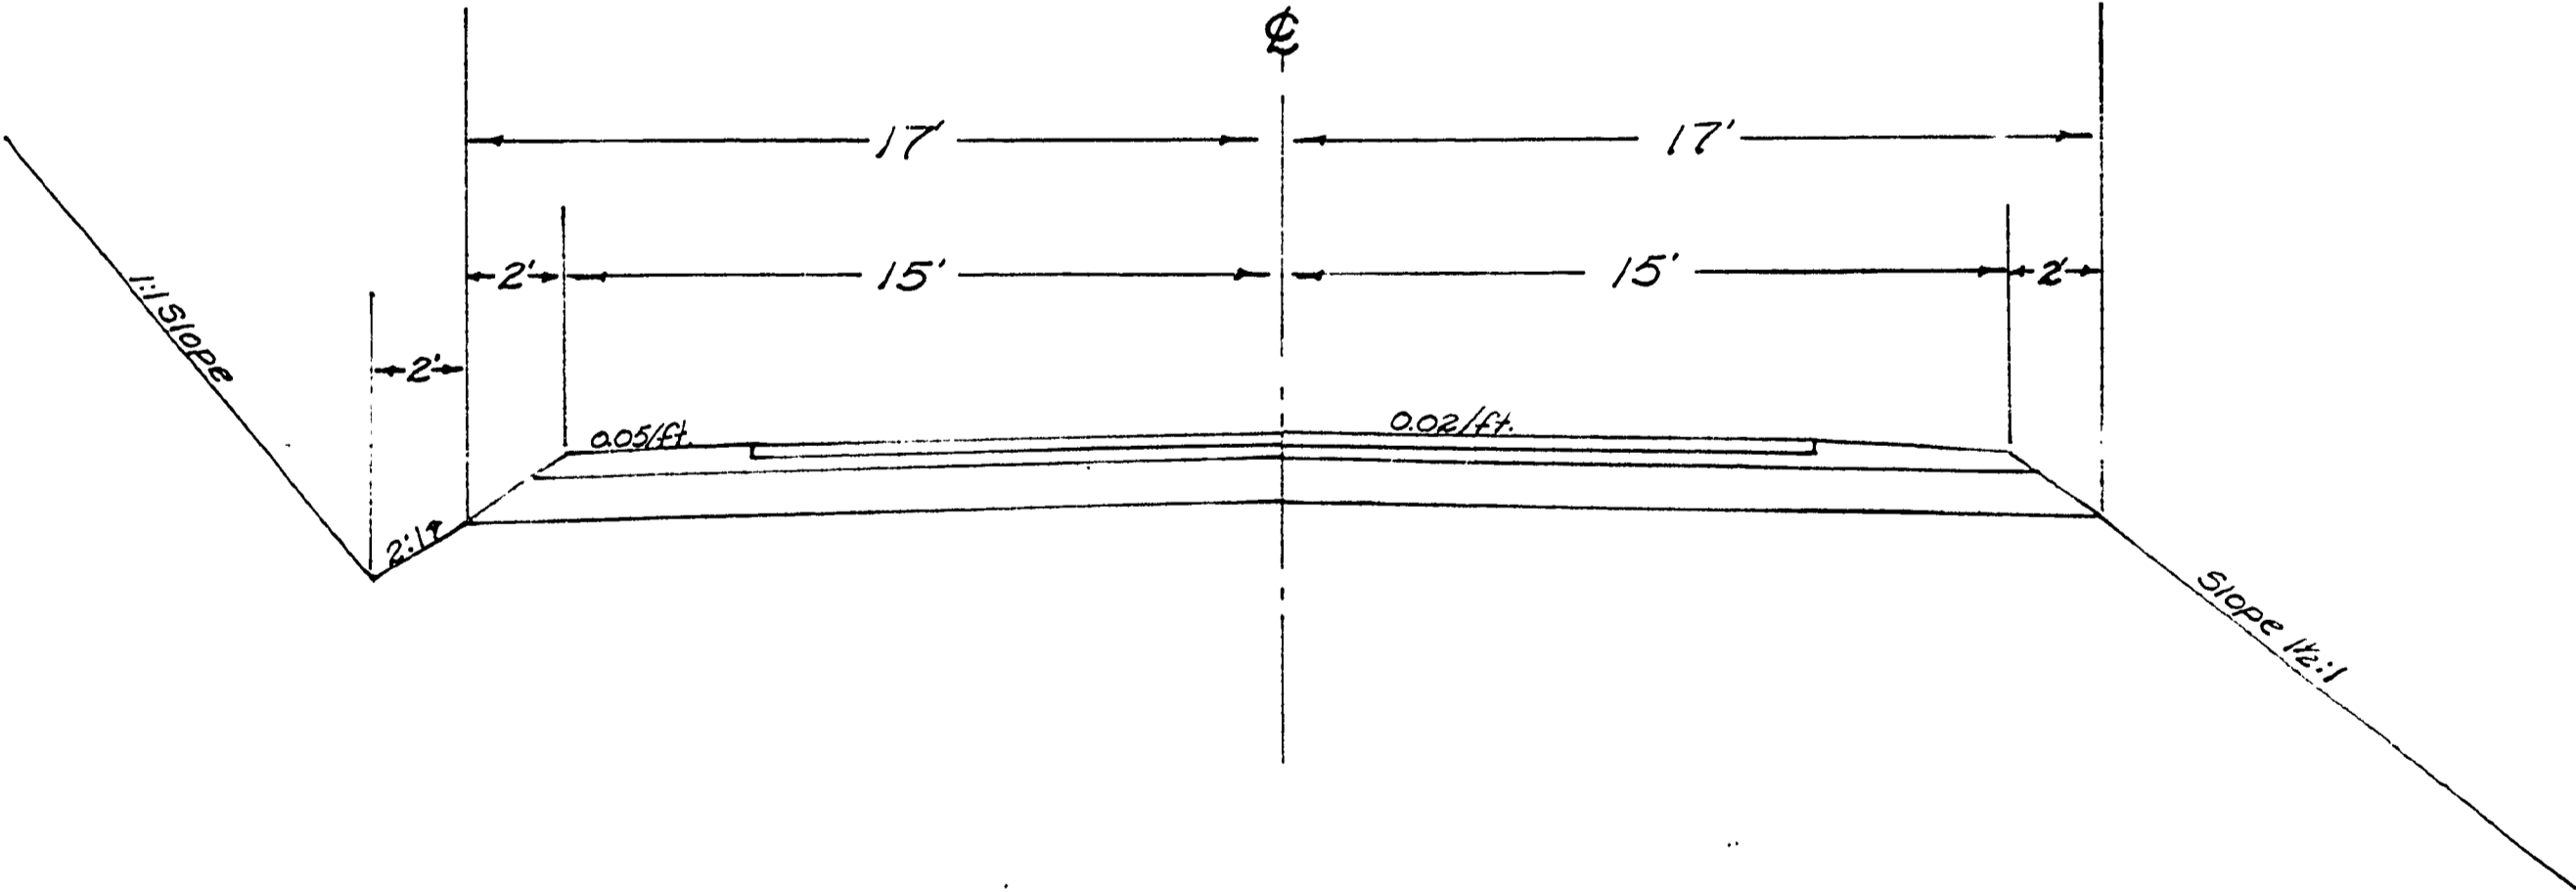


DOUGLAS COUNTY OREGON  
 PLANS FOR PROPOSED PROJECT  
**AS CONSTRUCTED**  
**DRIVER VALLEY ROAD**  
 COUNTY ROAD No. 22  
 May 1960

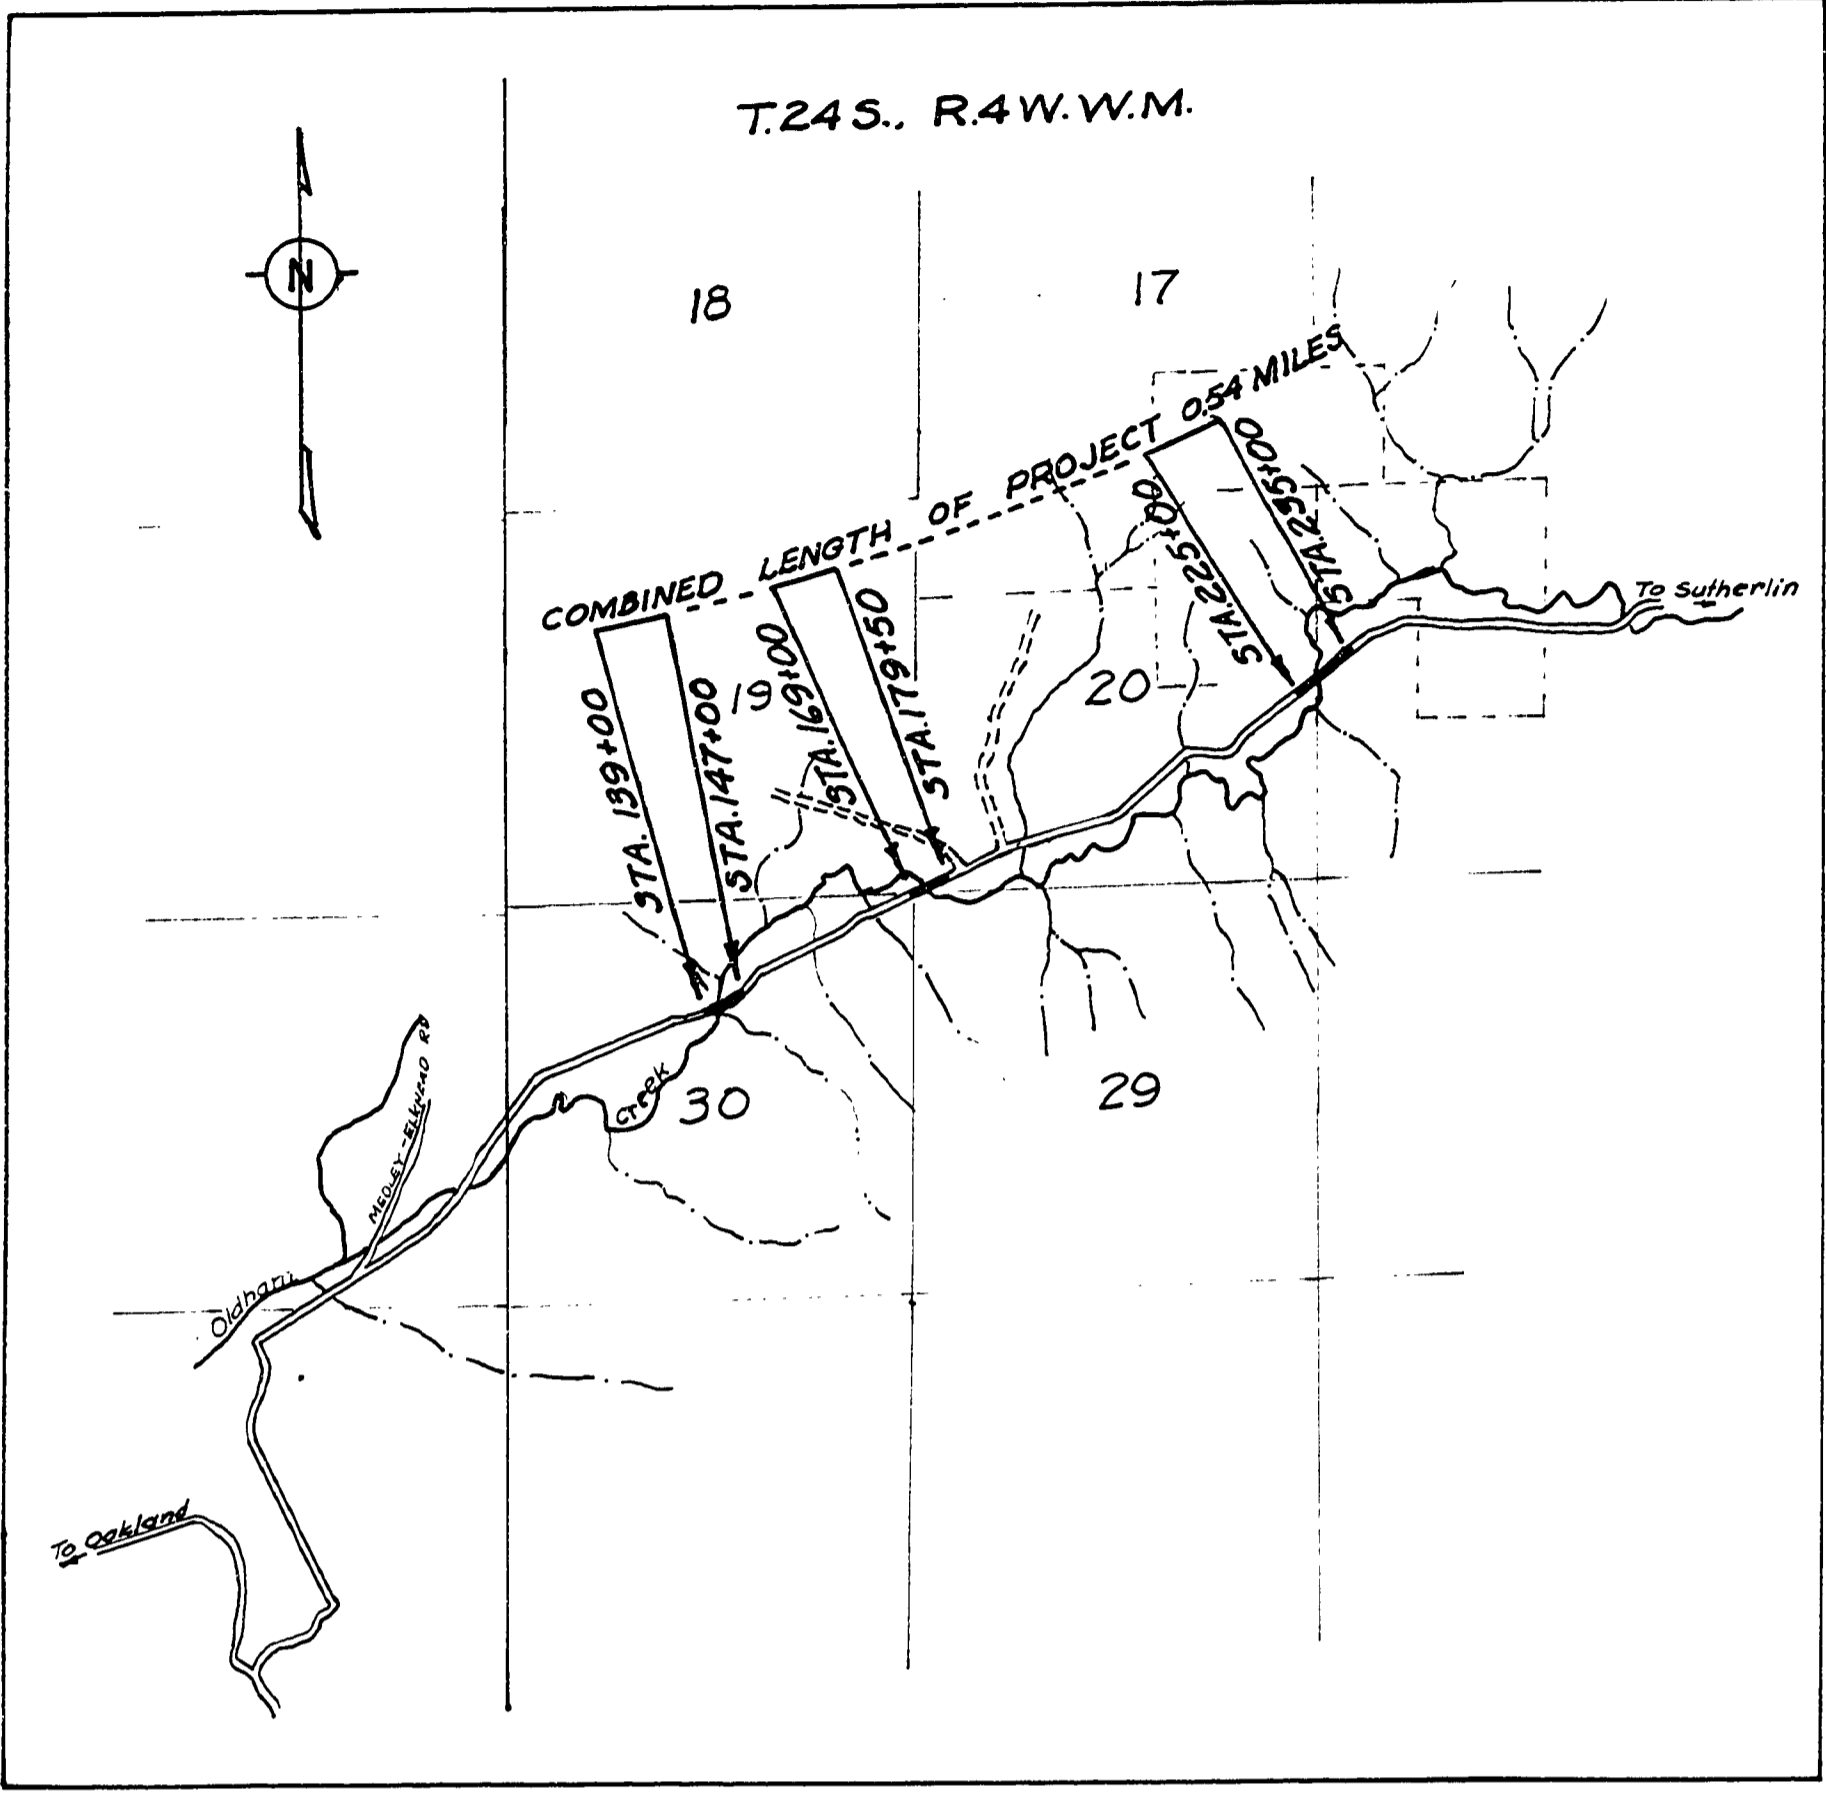

FILED  
 RECEIVED  
 FEB 15 1960  
 COUNTY SURVEYOR  
 DOUGLAS COUNTY, ORE.

0501068C