
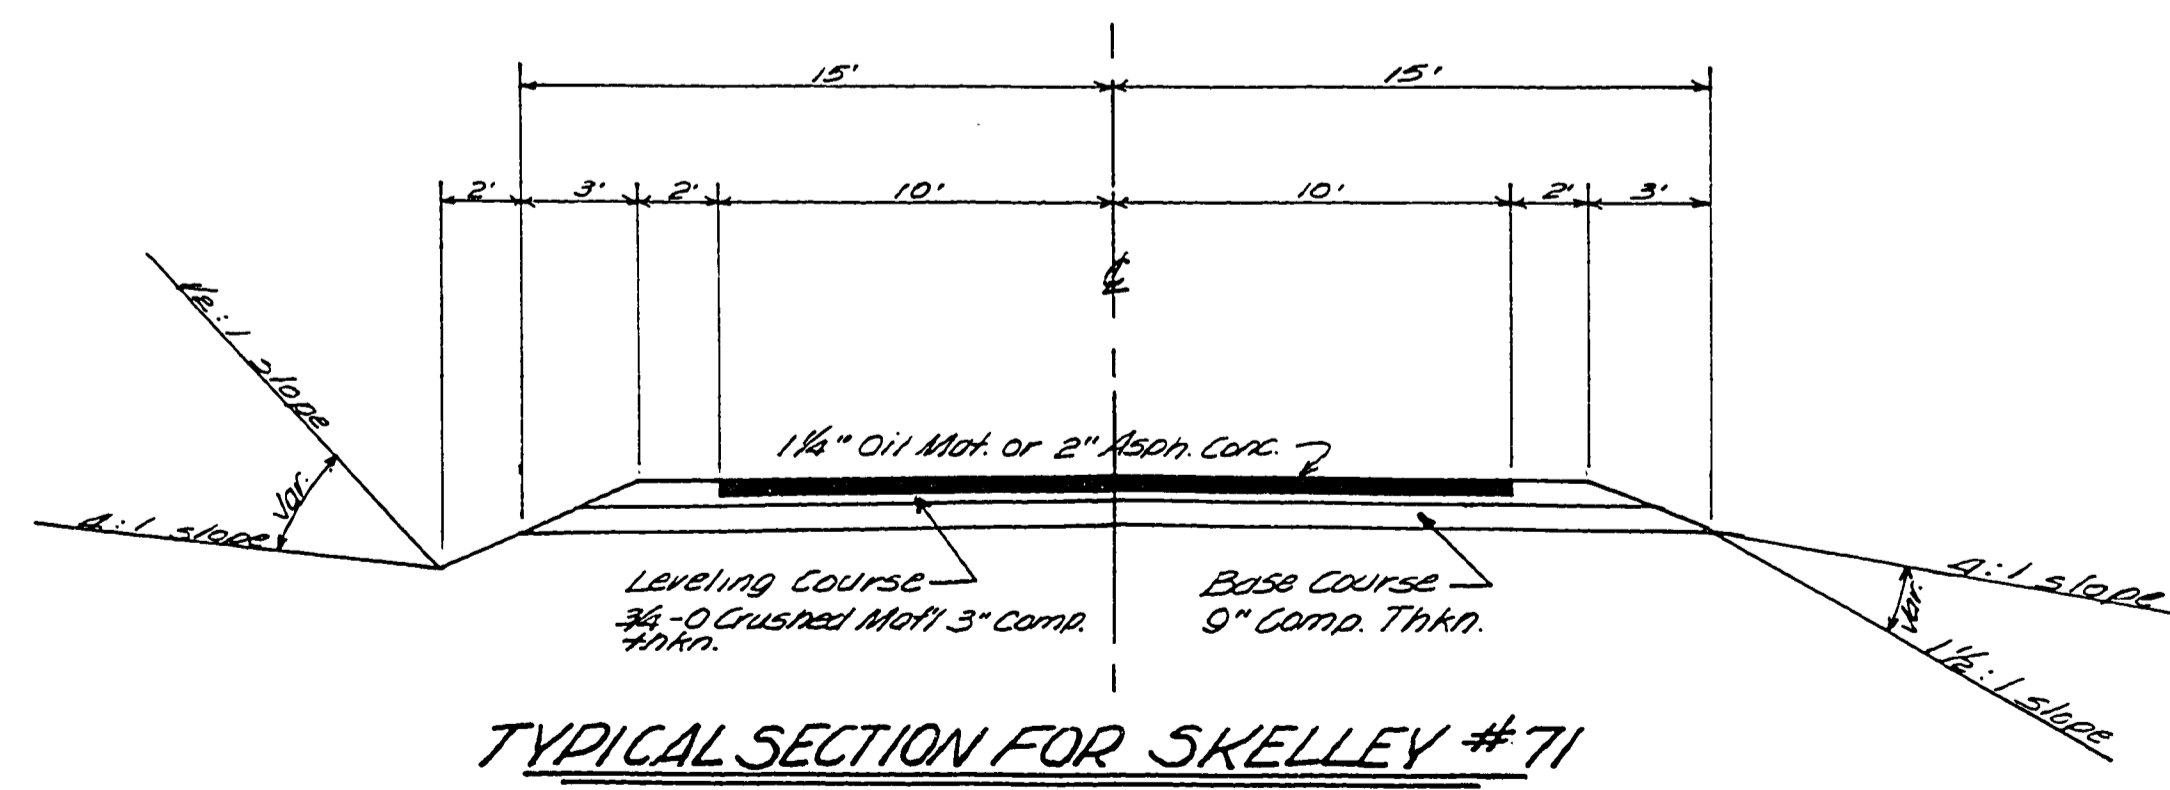
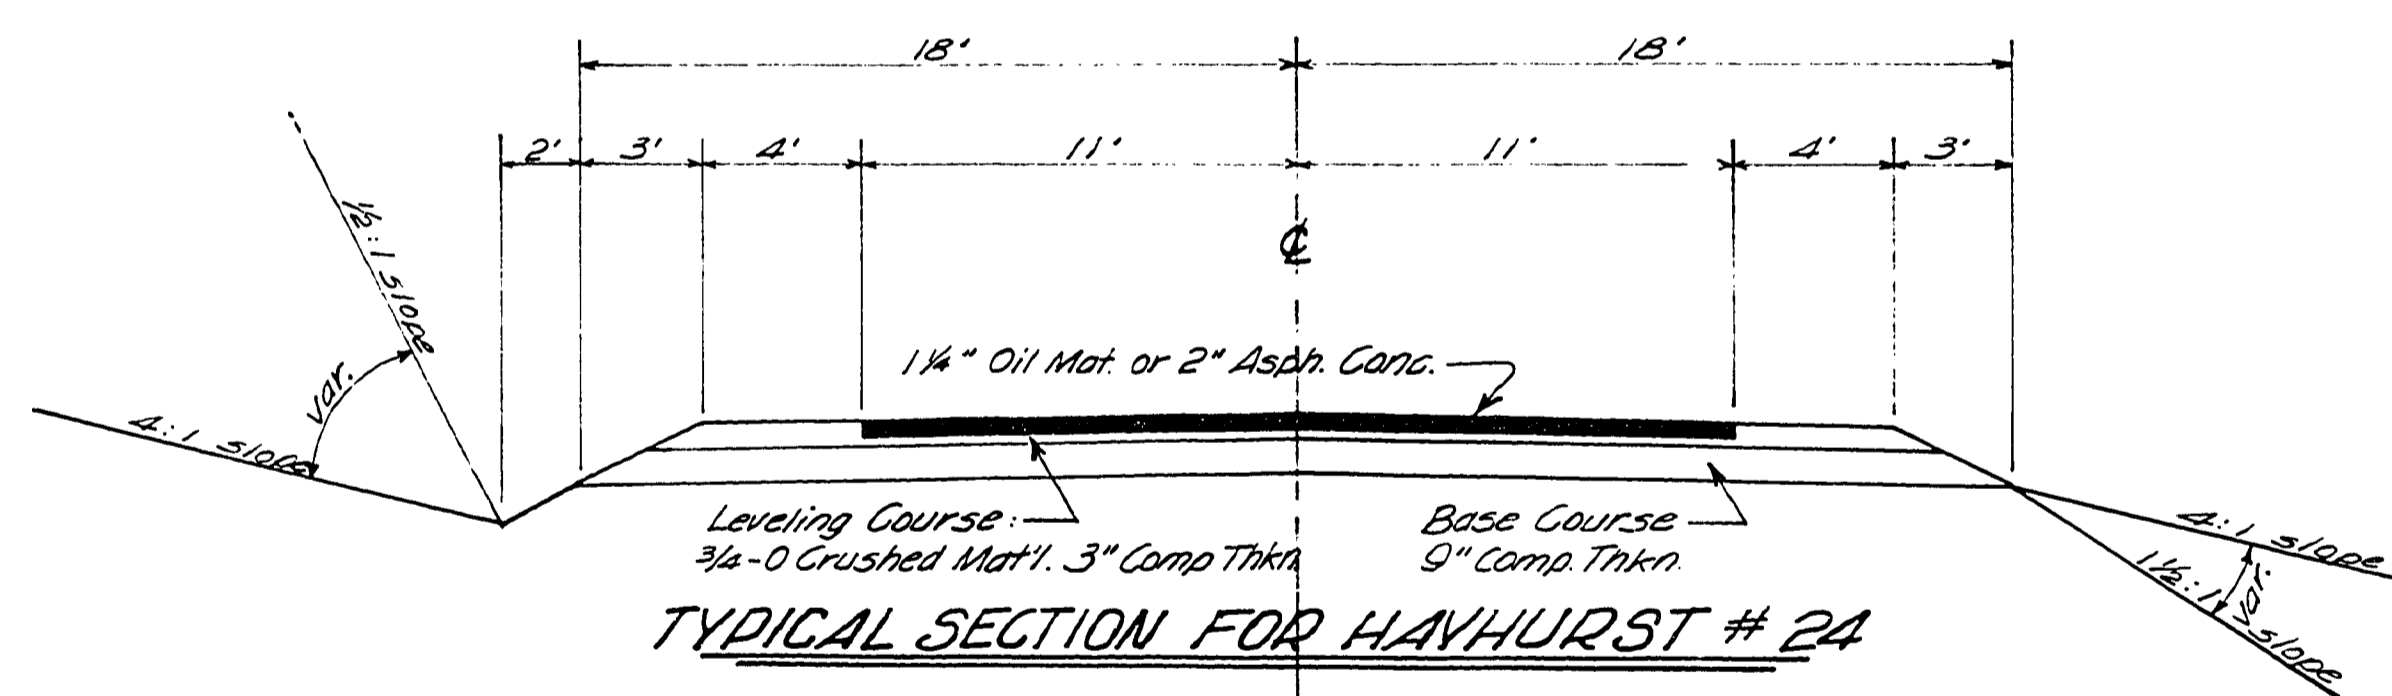


DOUGLAS COUNTY OREGON
 PLANS FOR PROPOSED PROJECT
 AS CONSTRUCTED
HAYHURST ROAD
SKELLEY ROAD

COUNTY ROAD # 24
 COUNTY ROAD # 71

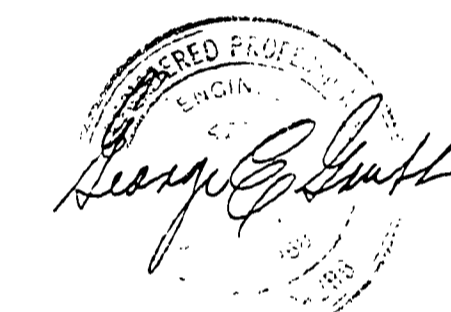

FILED
 RECEIVED
 1961

FILED
 RECEIVED
 1961
 COUNTY SURVEYOR
 DOUGLAS COUNTY, ORE

0712031C