

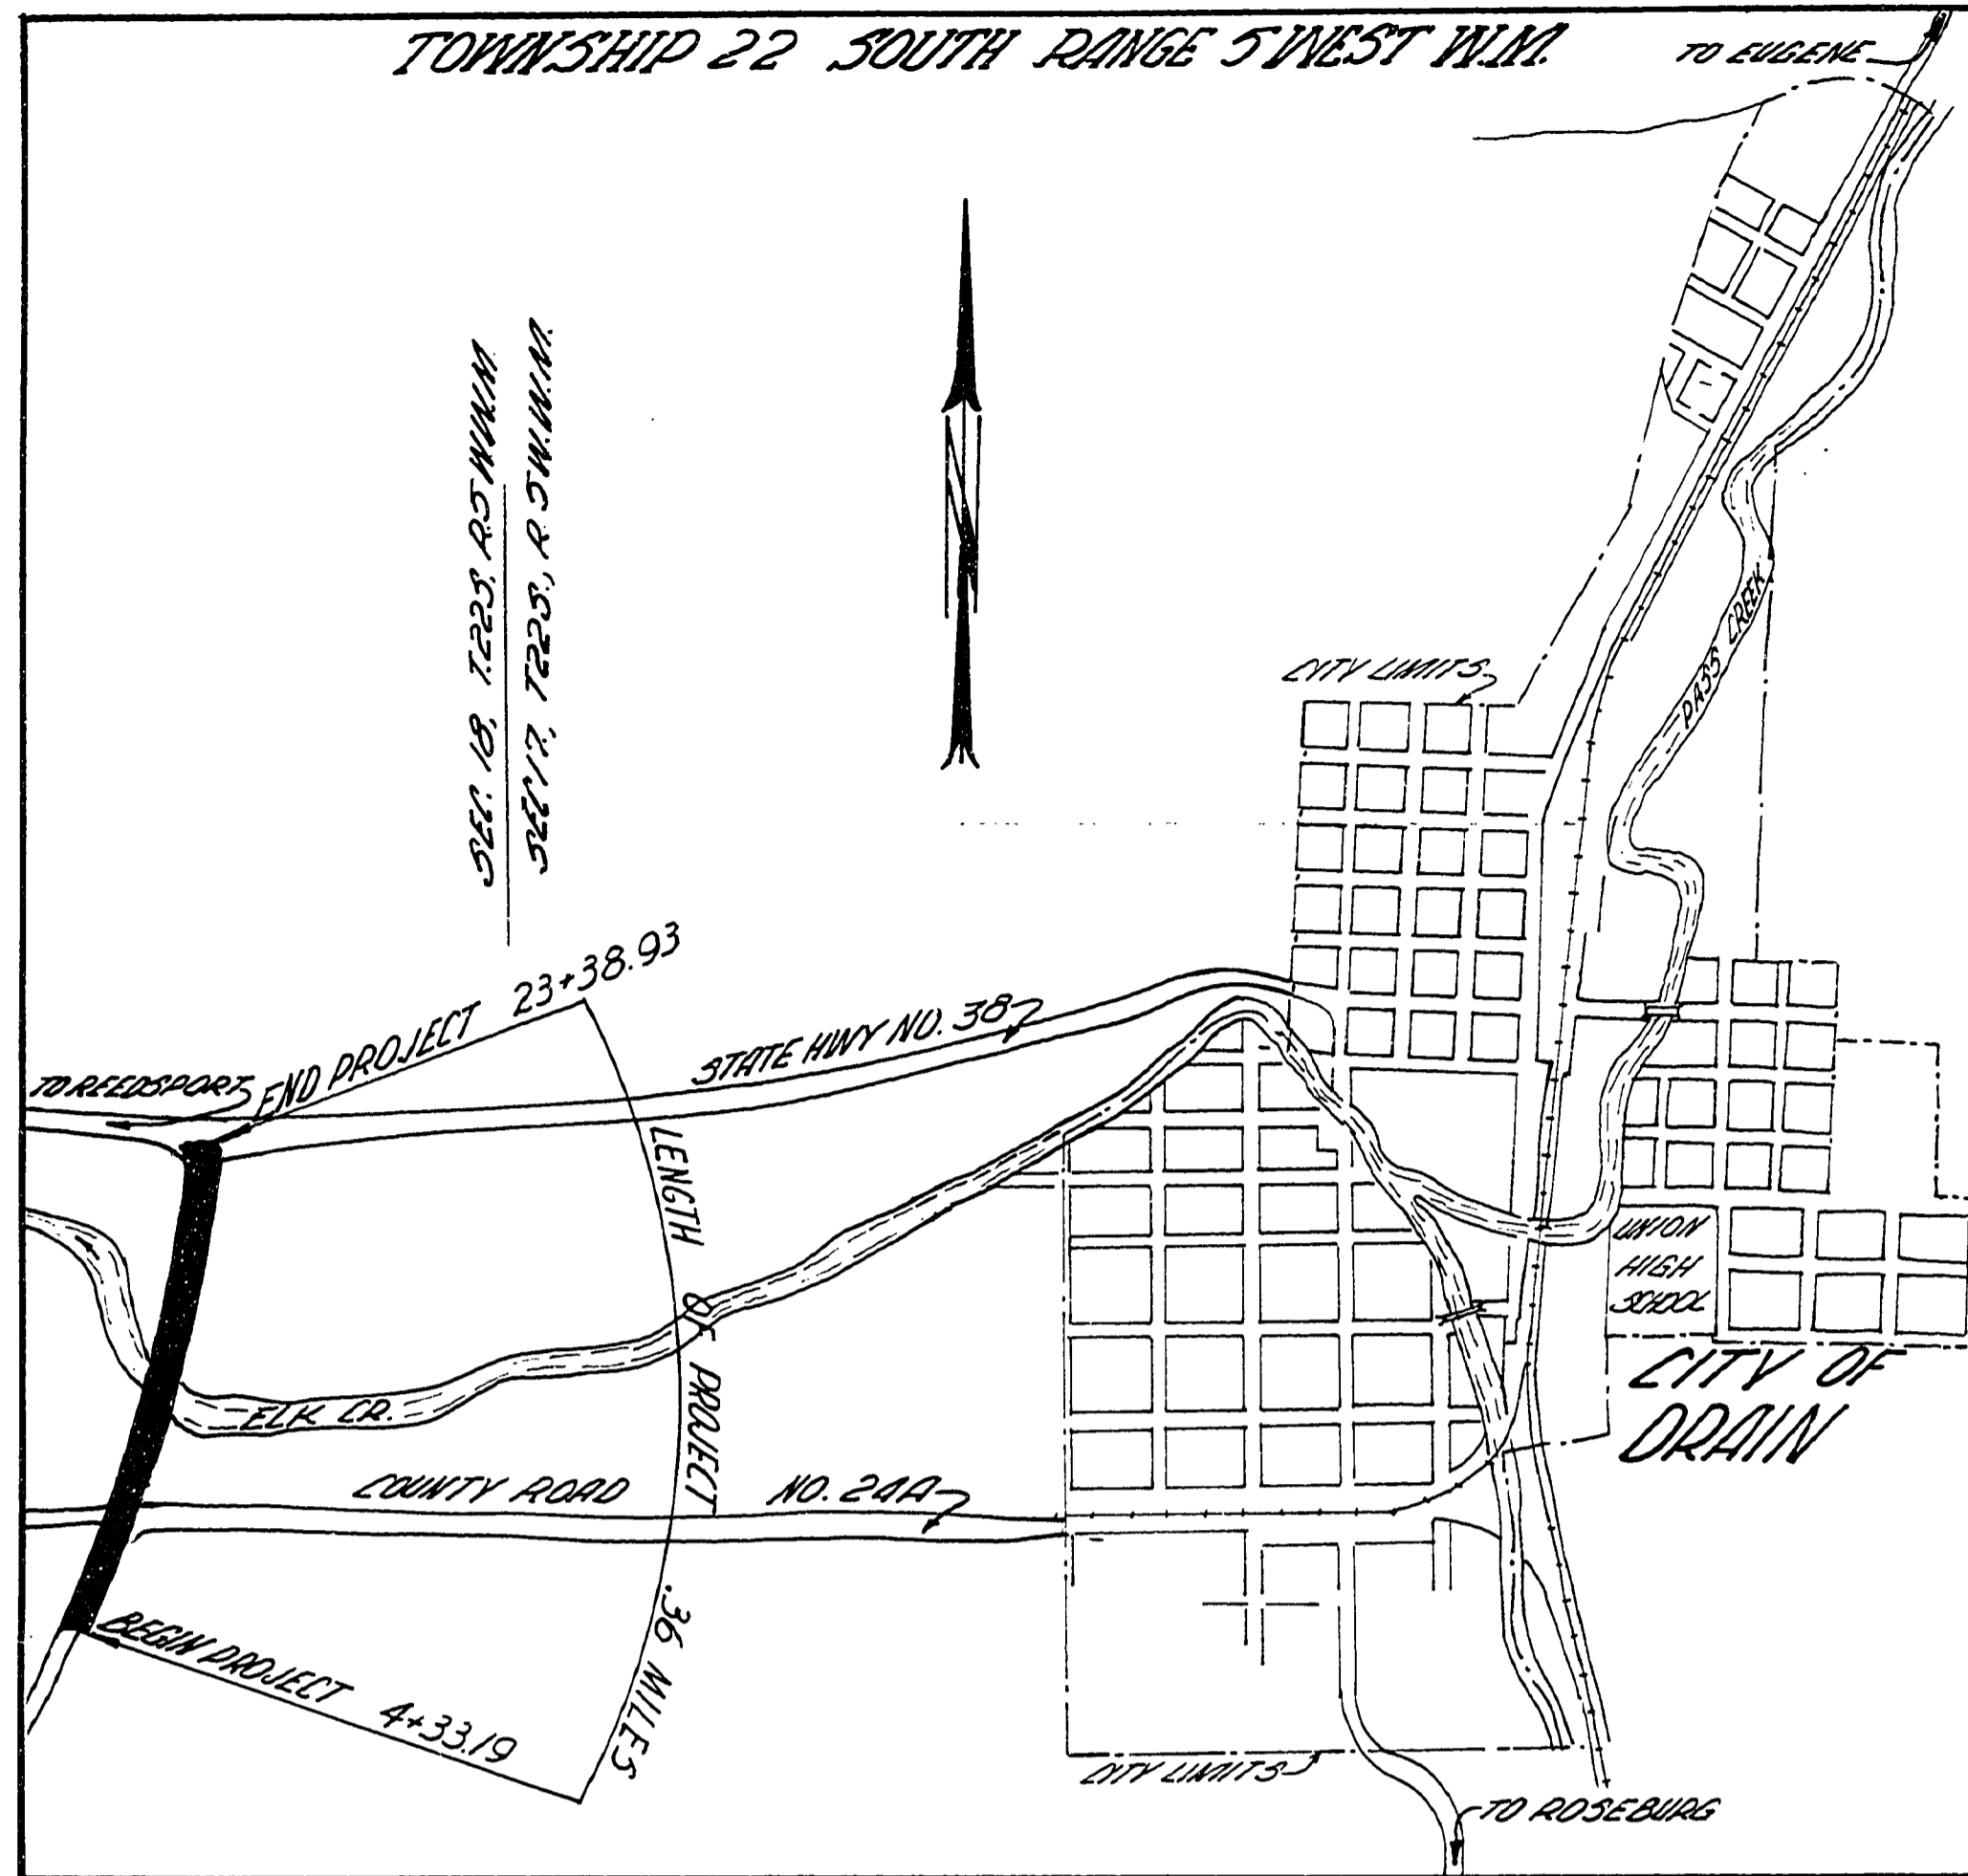


# DOUGLAS COUNTY OREGON PLANS FOR PROPOSED PROJECT GRADING & SURFACING HAYHURST ROAD NO. 24

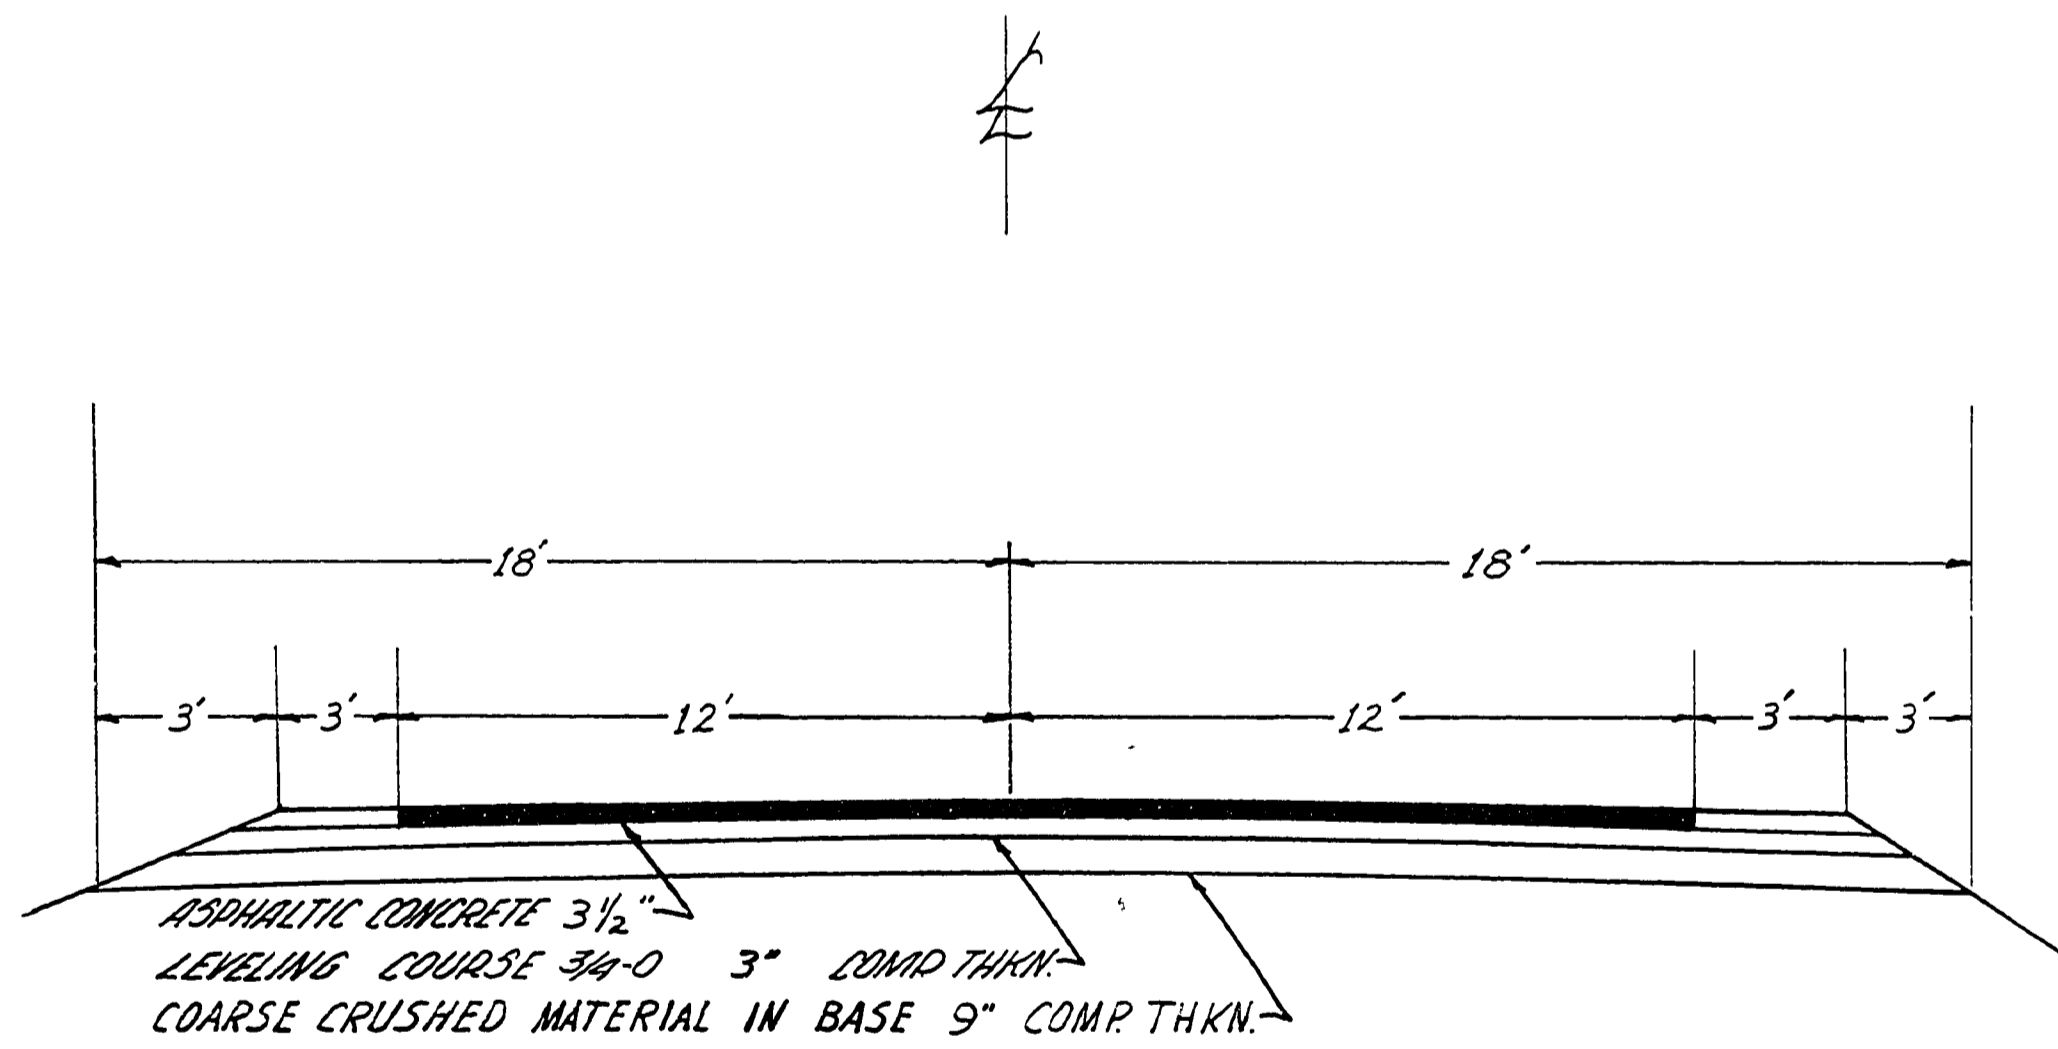

VICINITY MAP

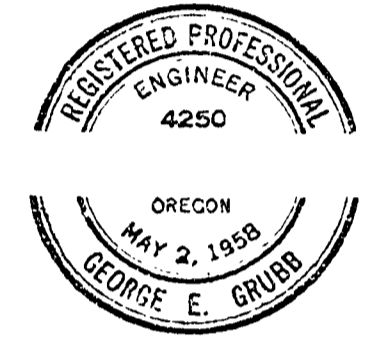

TYPICAL SECTION

DOUGLAS COUNTY  
ENGINEER

AS CONSTRUCTED  
2-7-68

Co. Rd #24  
2-7-68  
1 of 2

0870091C

140