

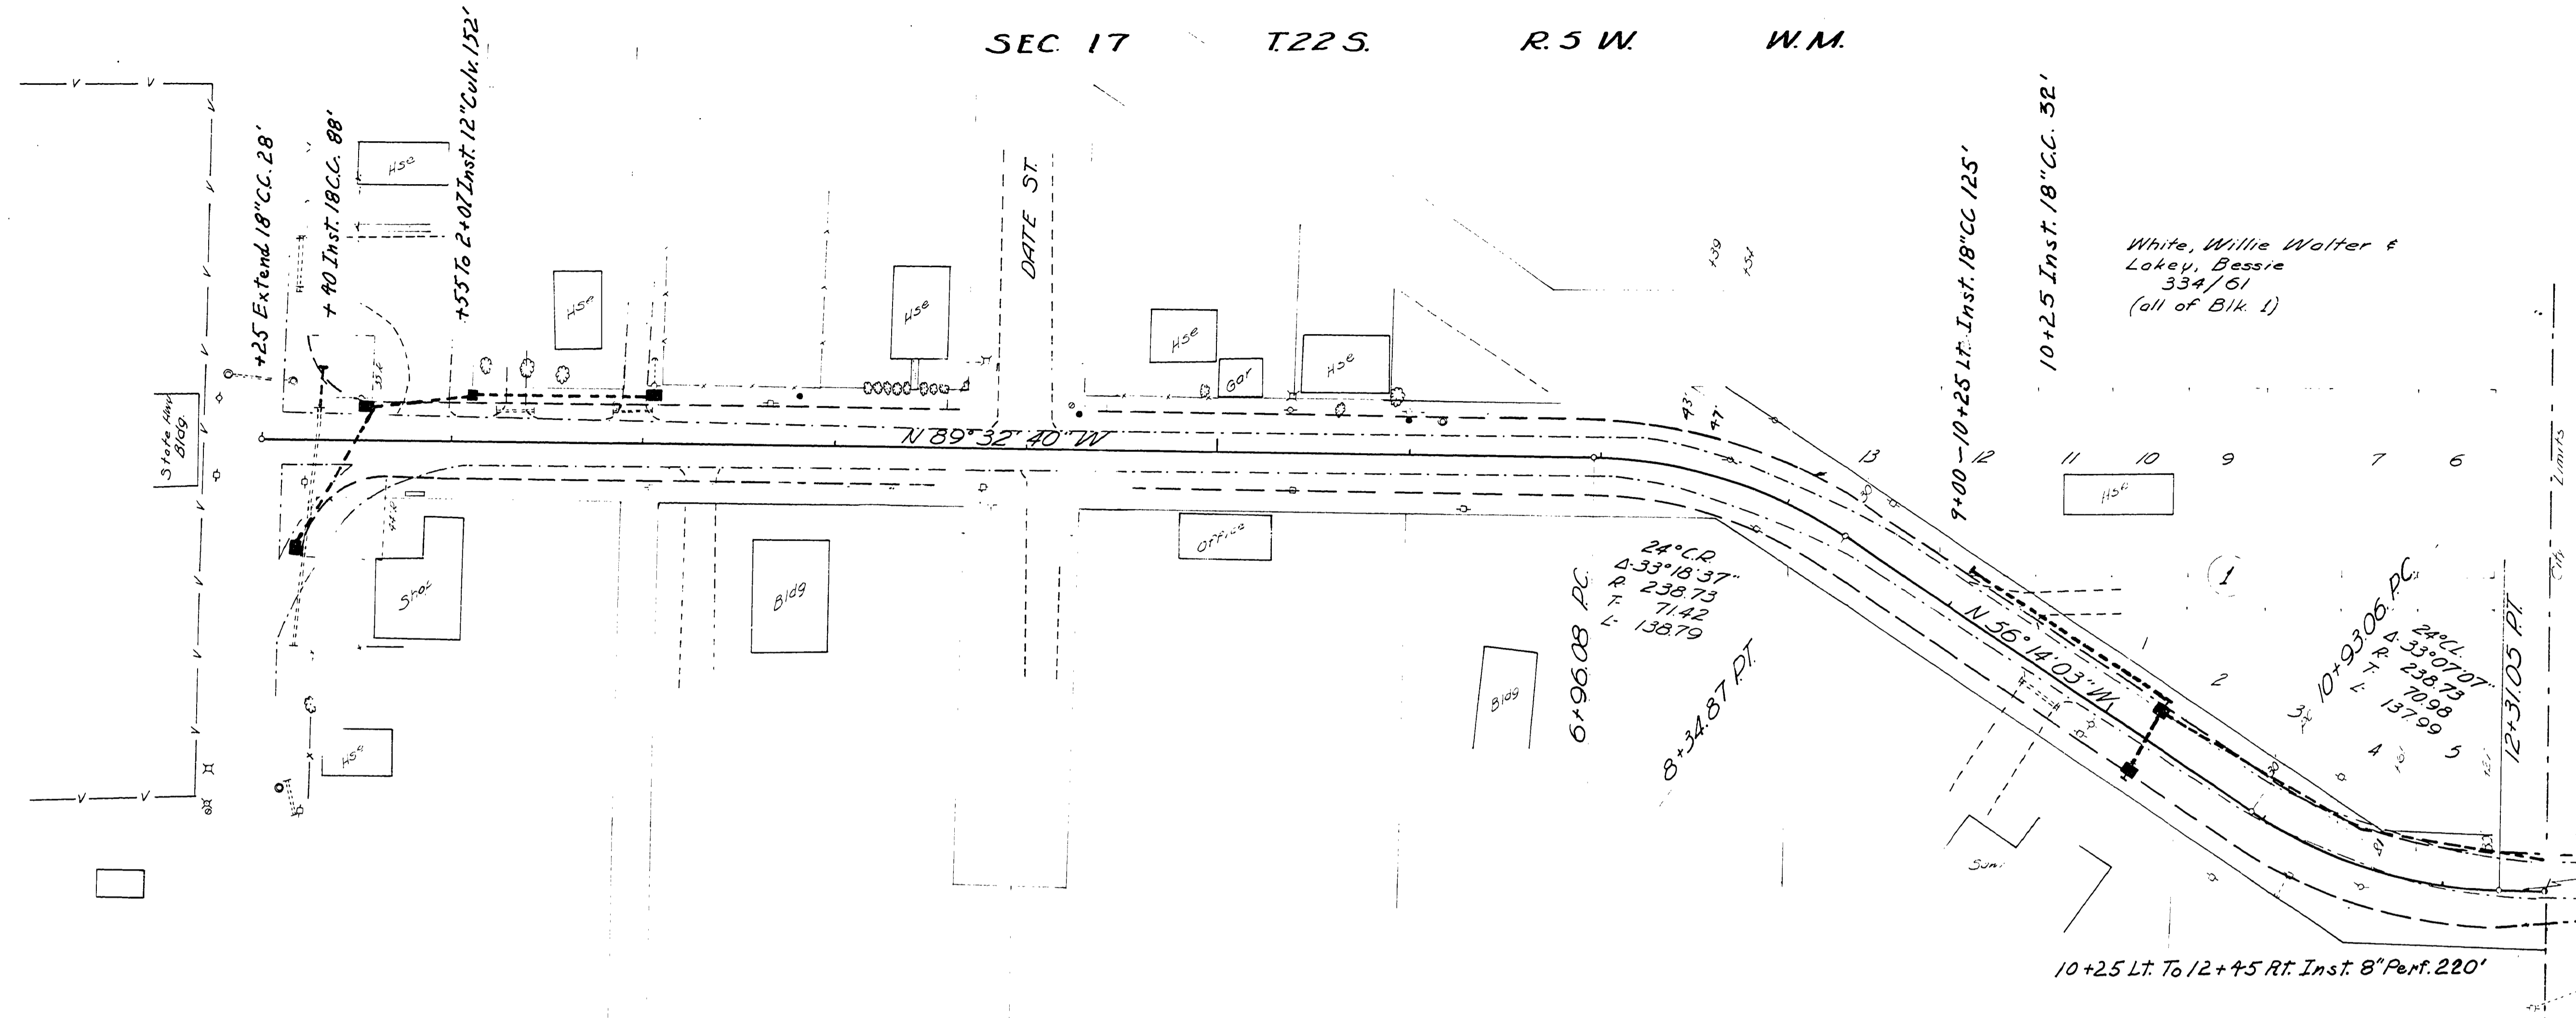
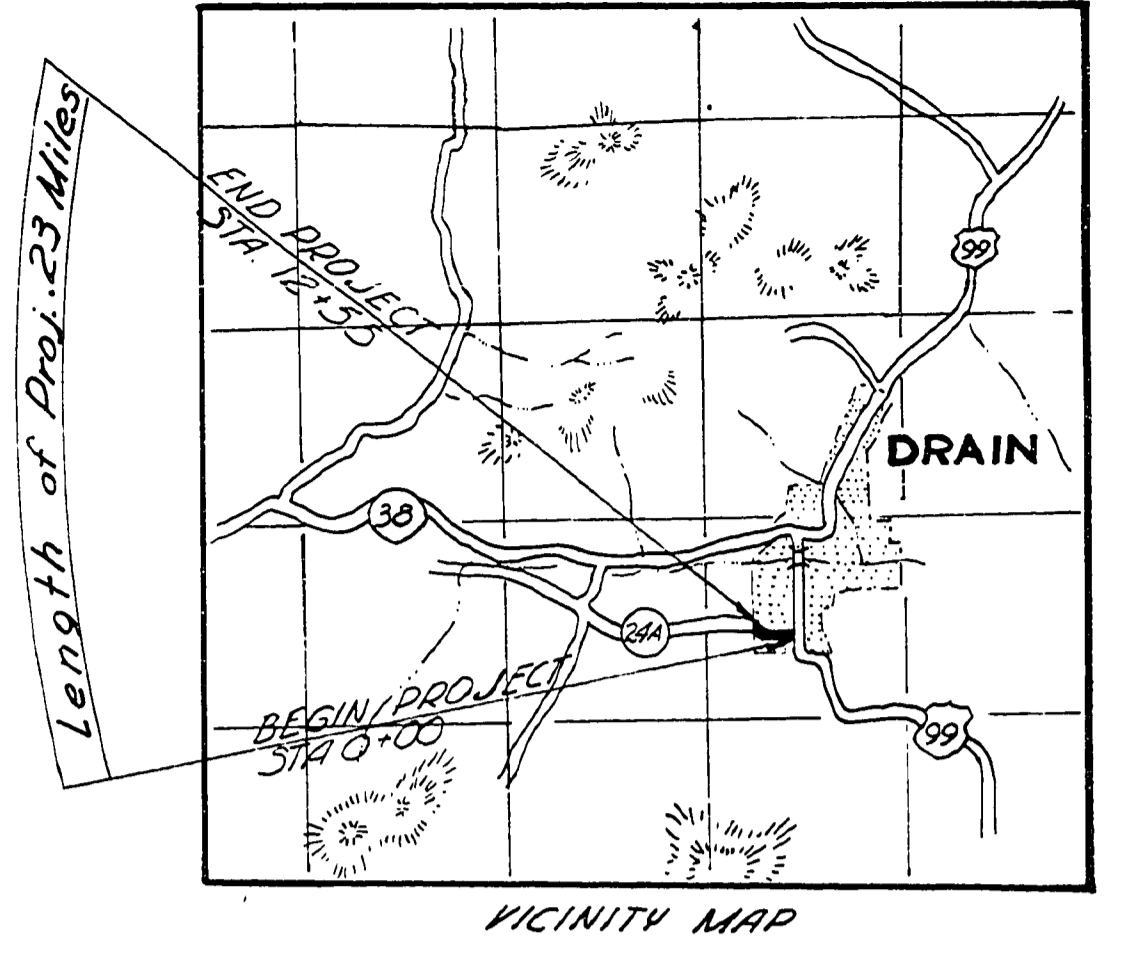


SEC 17 T22 S. R. 5 W. W.M.

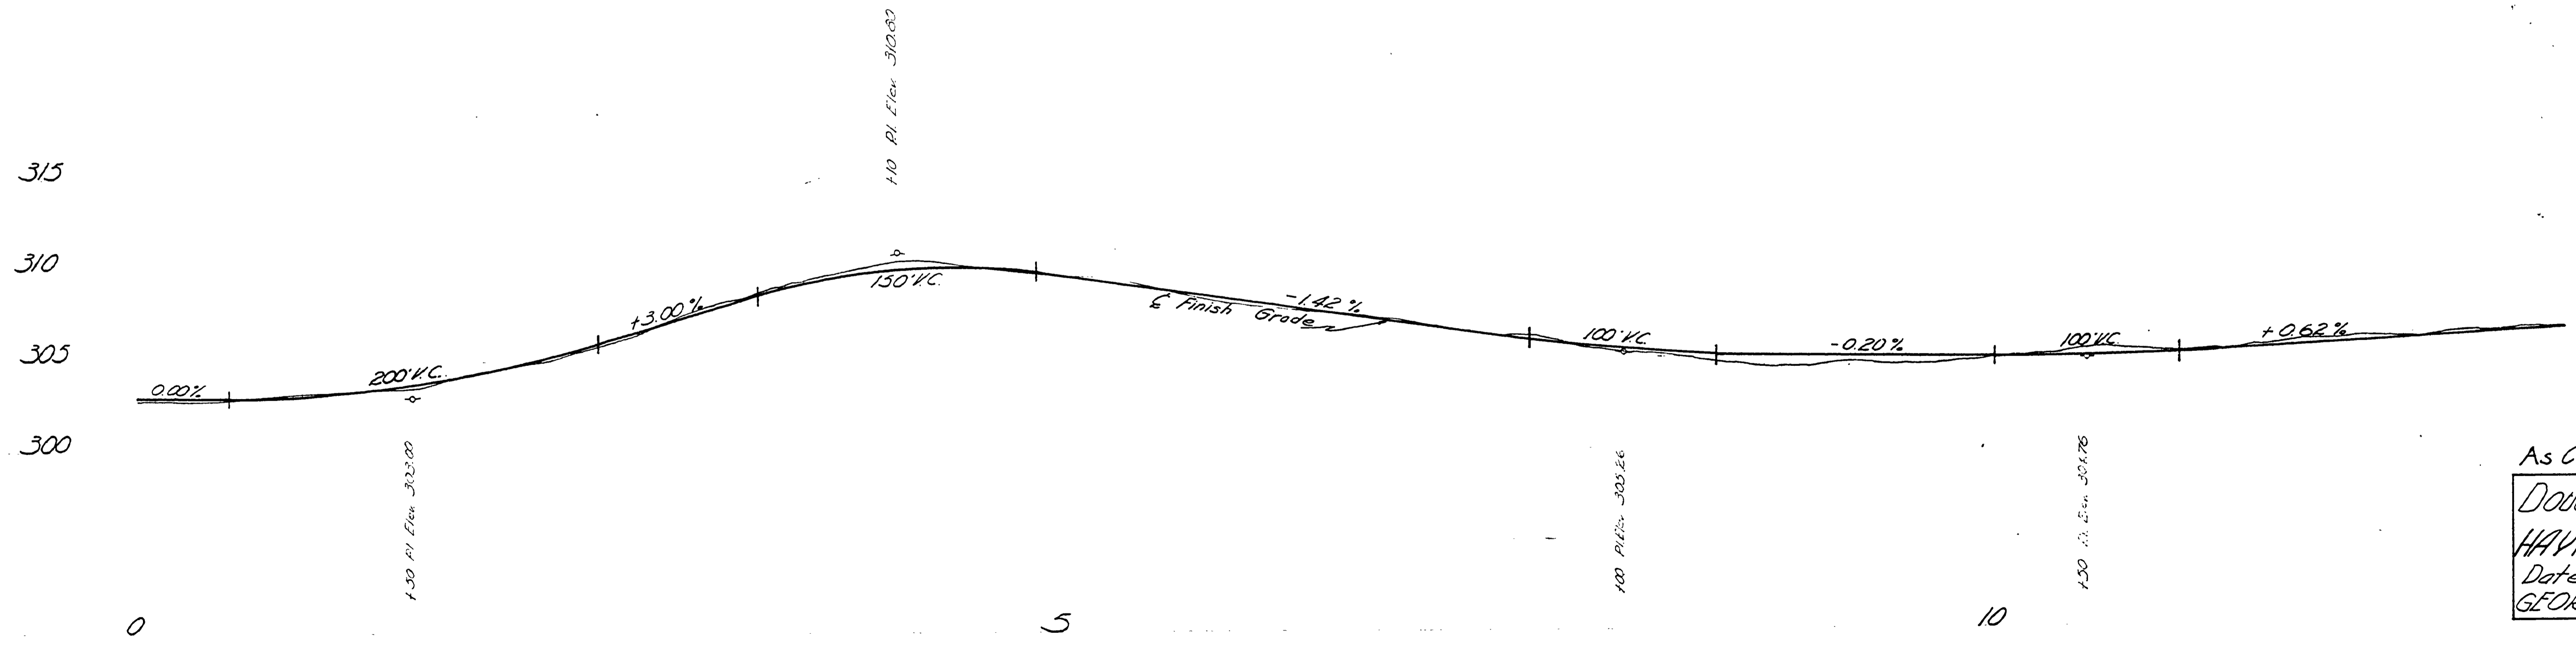

DOUGLAS COUNTY ROAD DEPT.
PLANS FOR PROPOSED PROJECT
GRADING & SURFACING
HAYHURST ROAD NO 24A
 JULY 1967

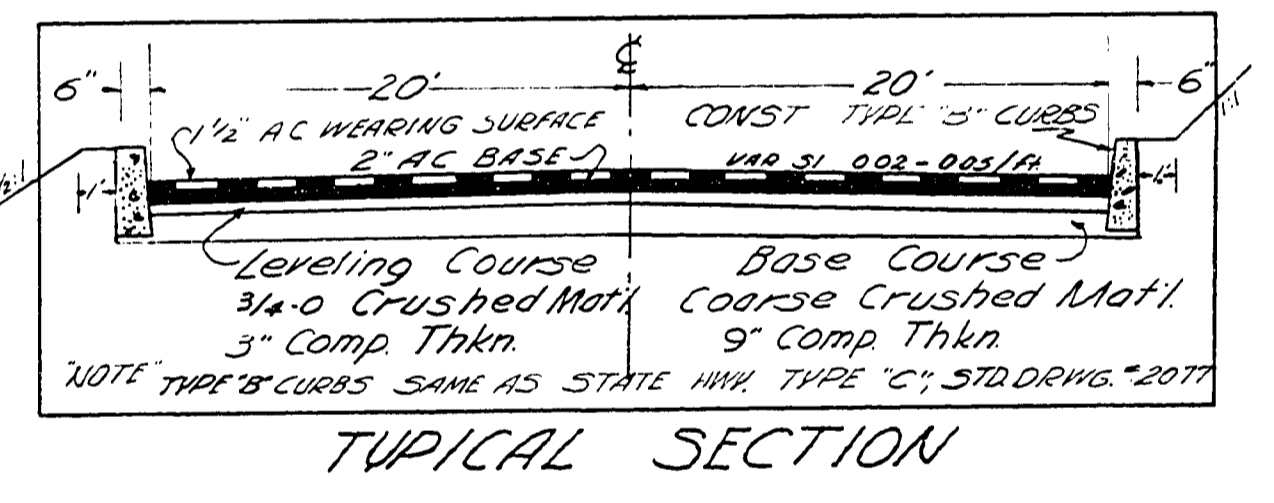

As Constructed 4-14-69 a.s.

DOUGLAS COUNTY ROAD DEPT.
 HAYHURST ROAD # 24A
 Date - July 1967 Sht. 1 of 1
 GEORGE E. GRUBB CO. ENG.

M.P. 0.00 - 0.23

Co. Rd. # 24 A JULY 1967
 Sht. 1 of 1 (142)