




DOUGLAS COUNTY, OREGON
 PLANS FOR PROPOSED PROJECT
AS CONSTRUCTED
HAPPY VALLEY
 COUNTY ROAD No. 26
 APRIL 1961

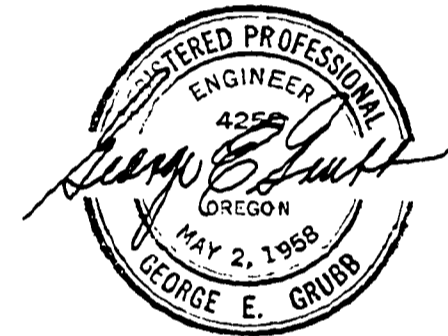

TYPICAL SECTION

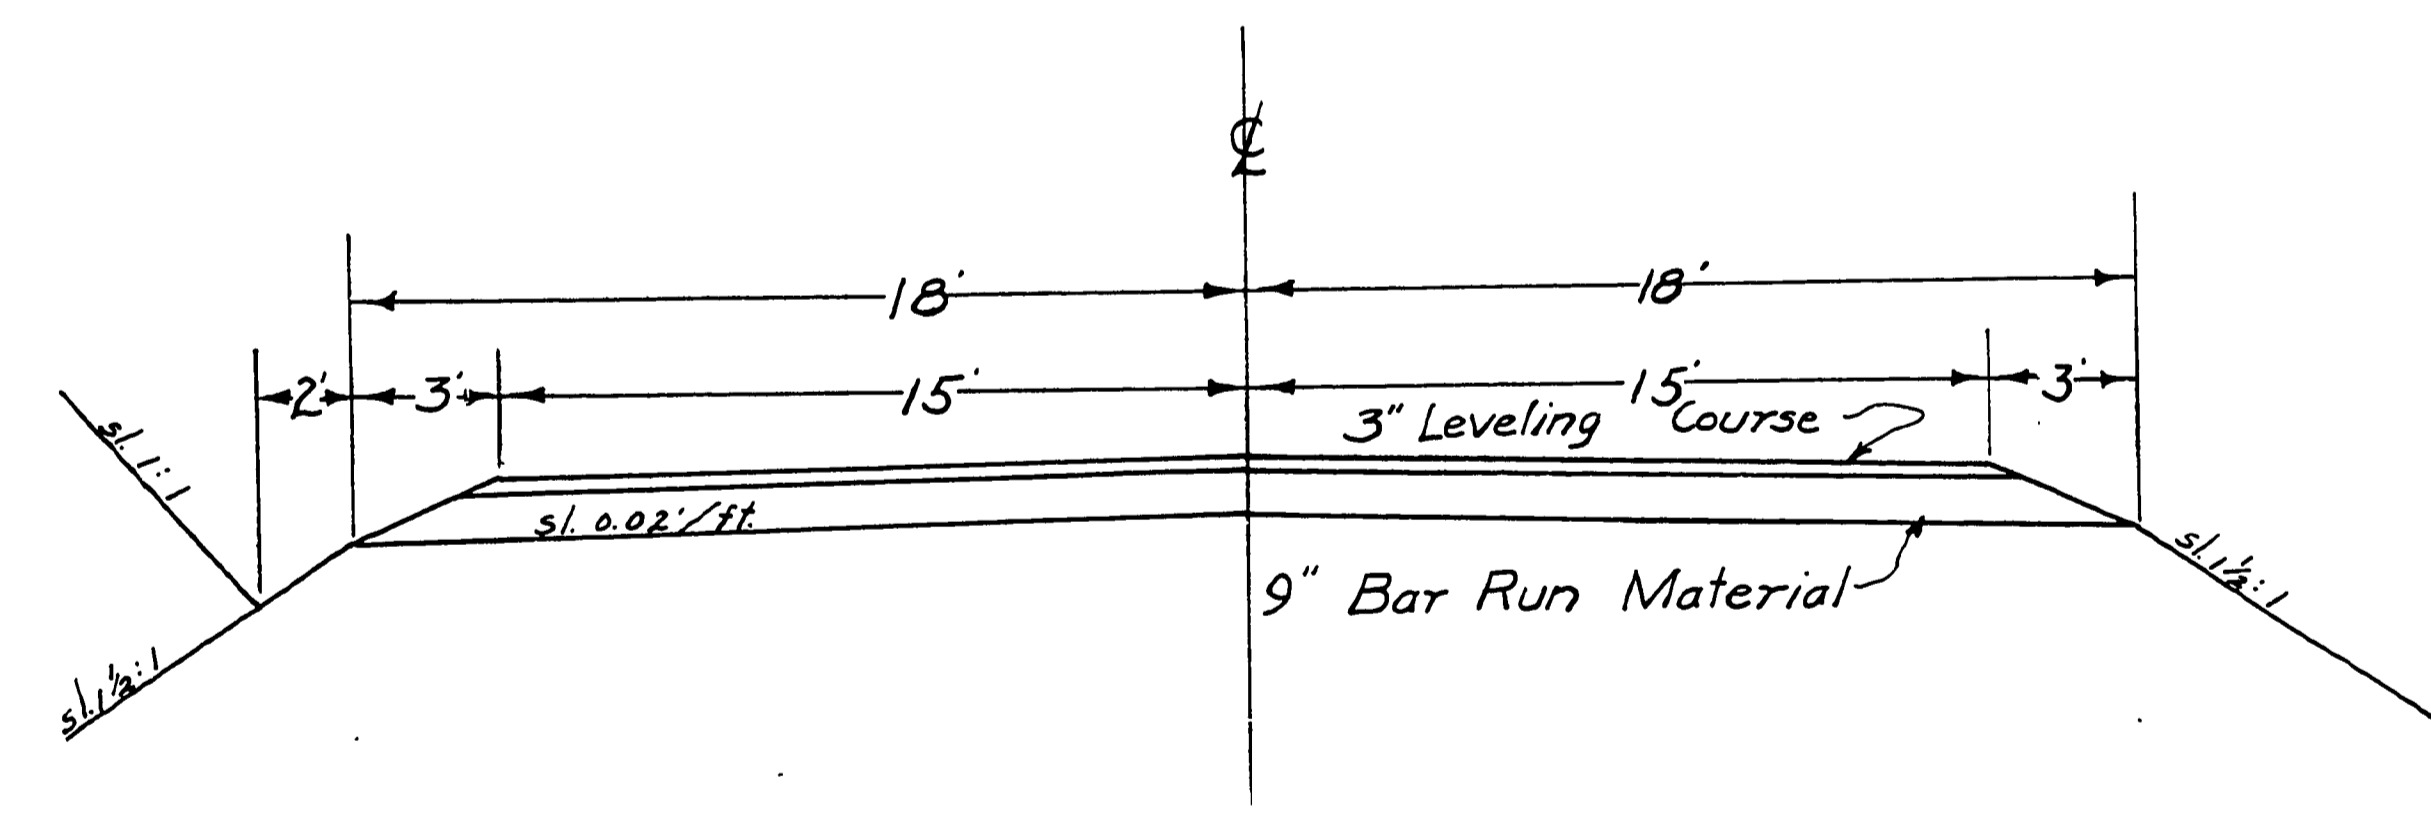

TYPICAL SECTION CHANNEL CHANGE

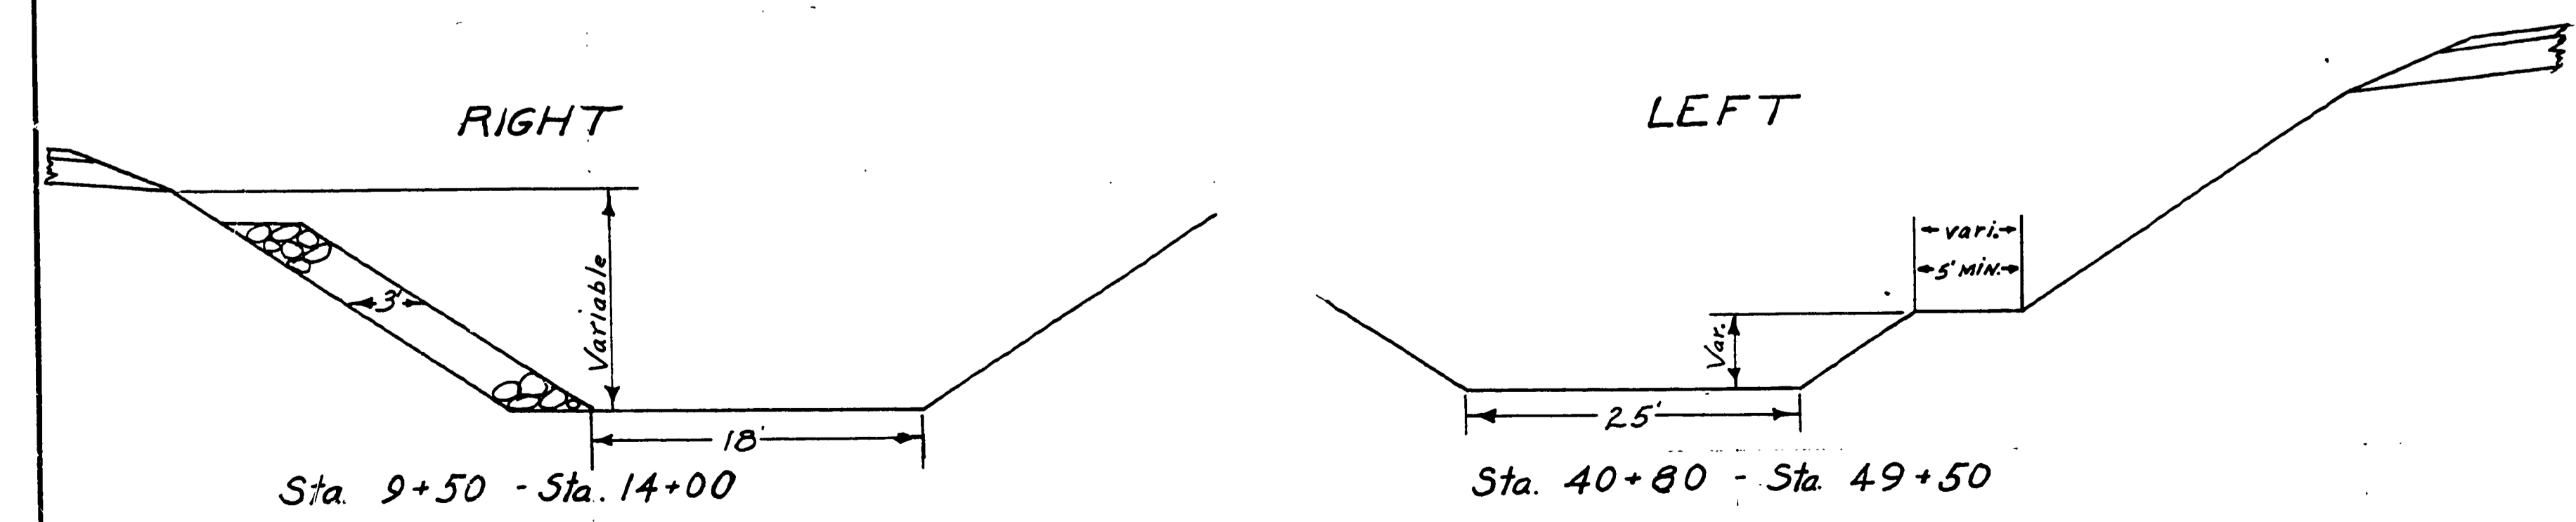

FILED
 RECEIVED
 COUNTY SURVEYOR
 DOUGLAS COUNTY, ORE.

FILED
 RECEIVED
 FEB 15 1961
 COUNTY SURVEYOR
 DOUGLAS COUNTY, ORE.

Sheet 1 of 9
 APRIL 1961

Co Rd. #26

sht 1 of 9

0009046C

