


VICINITY MAP

DOUGLAS COUNTY, OREGON

GRADING & SURFACING

MCCULLOUGH CREEK CO. RD. #27A

AUGUST 1967

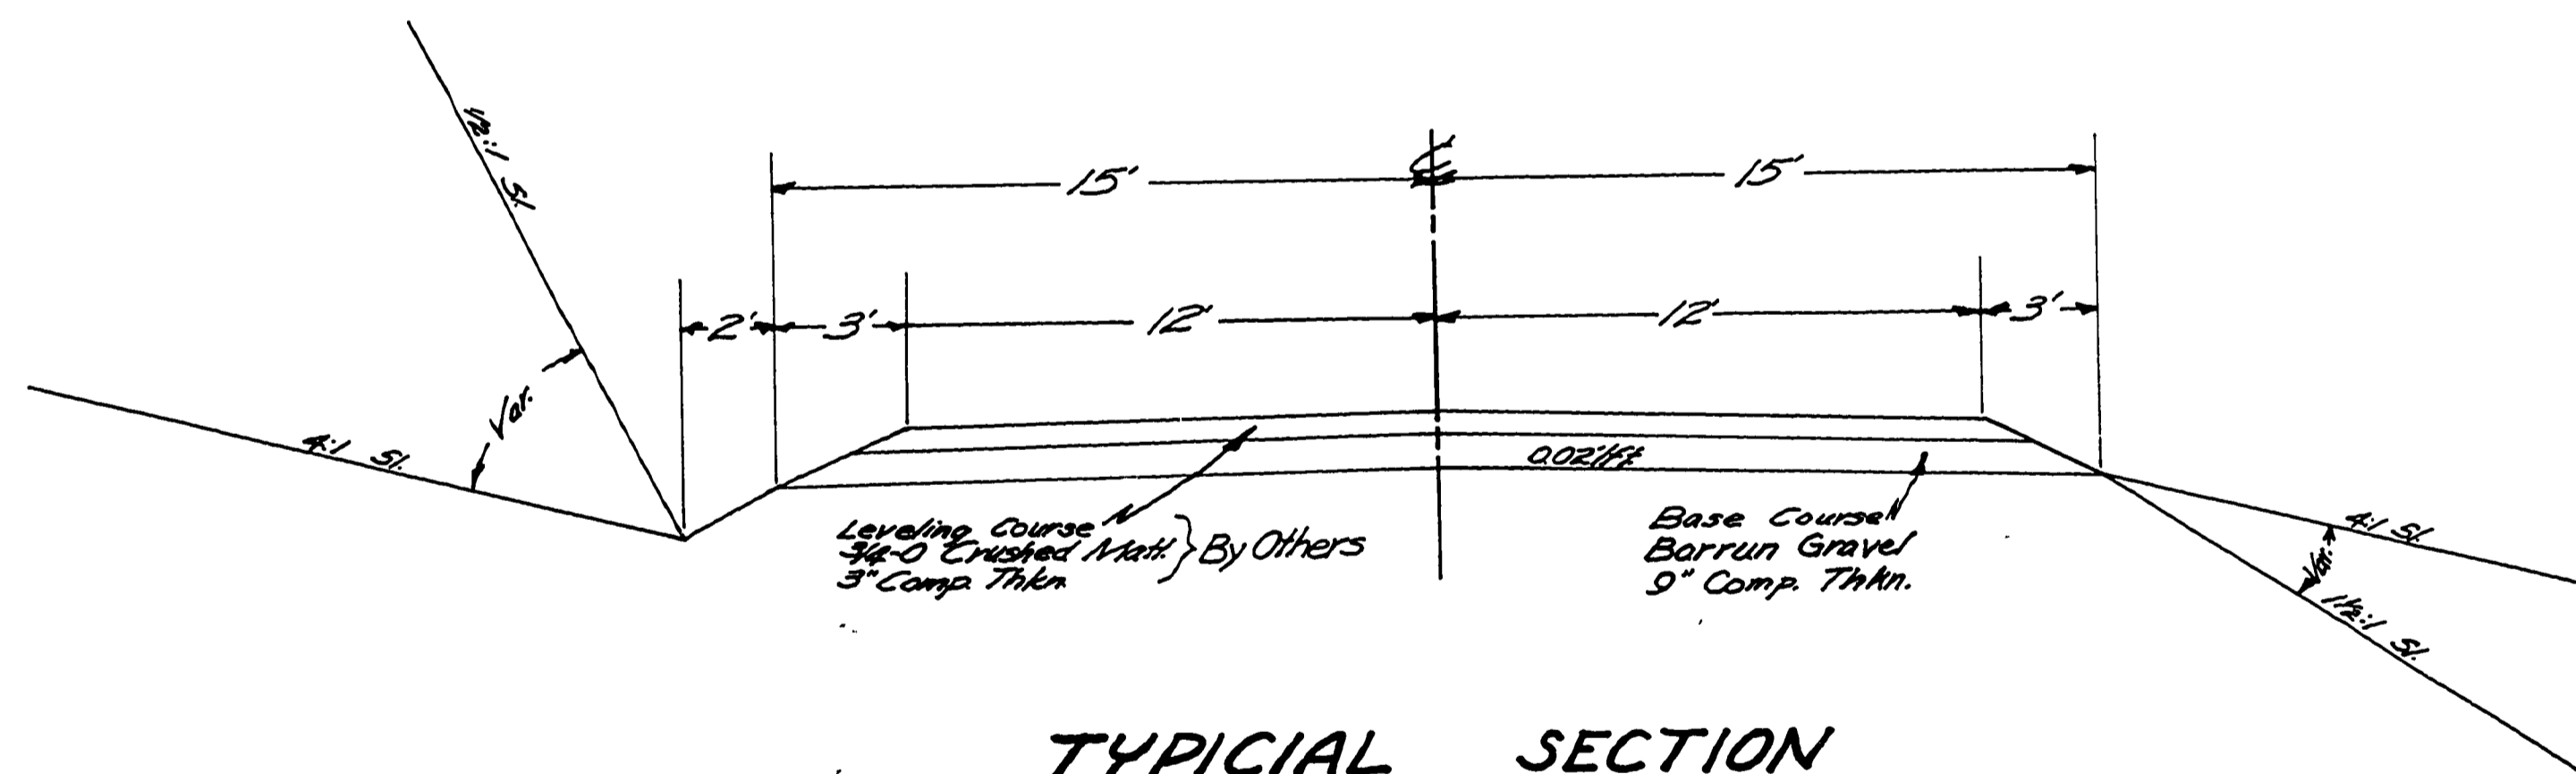

TYPICAL SECTION

FILED
RECEIVED

MAY 22 1968

COUNTY SURVEYOR
DOUGLAS COUNTY, OREGON

AS CONSTRUCTED

2-T. 66 OR
Sht. 1 of 4

Co. Rd. # 27-A

Aug. 1967
Sht. 1 of 4

(22)

0079021C