



# DOUGLAS COUNTY OREGON PLANS FOR PROPOSED PROJECT GRADING & SURFACING WILBUR-GARDEN VALLEY ROAD #31

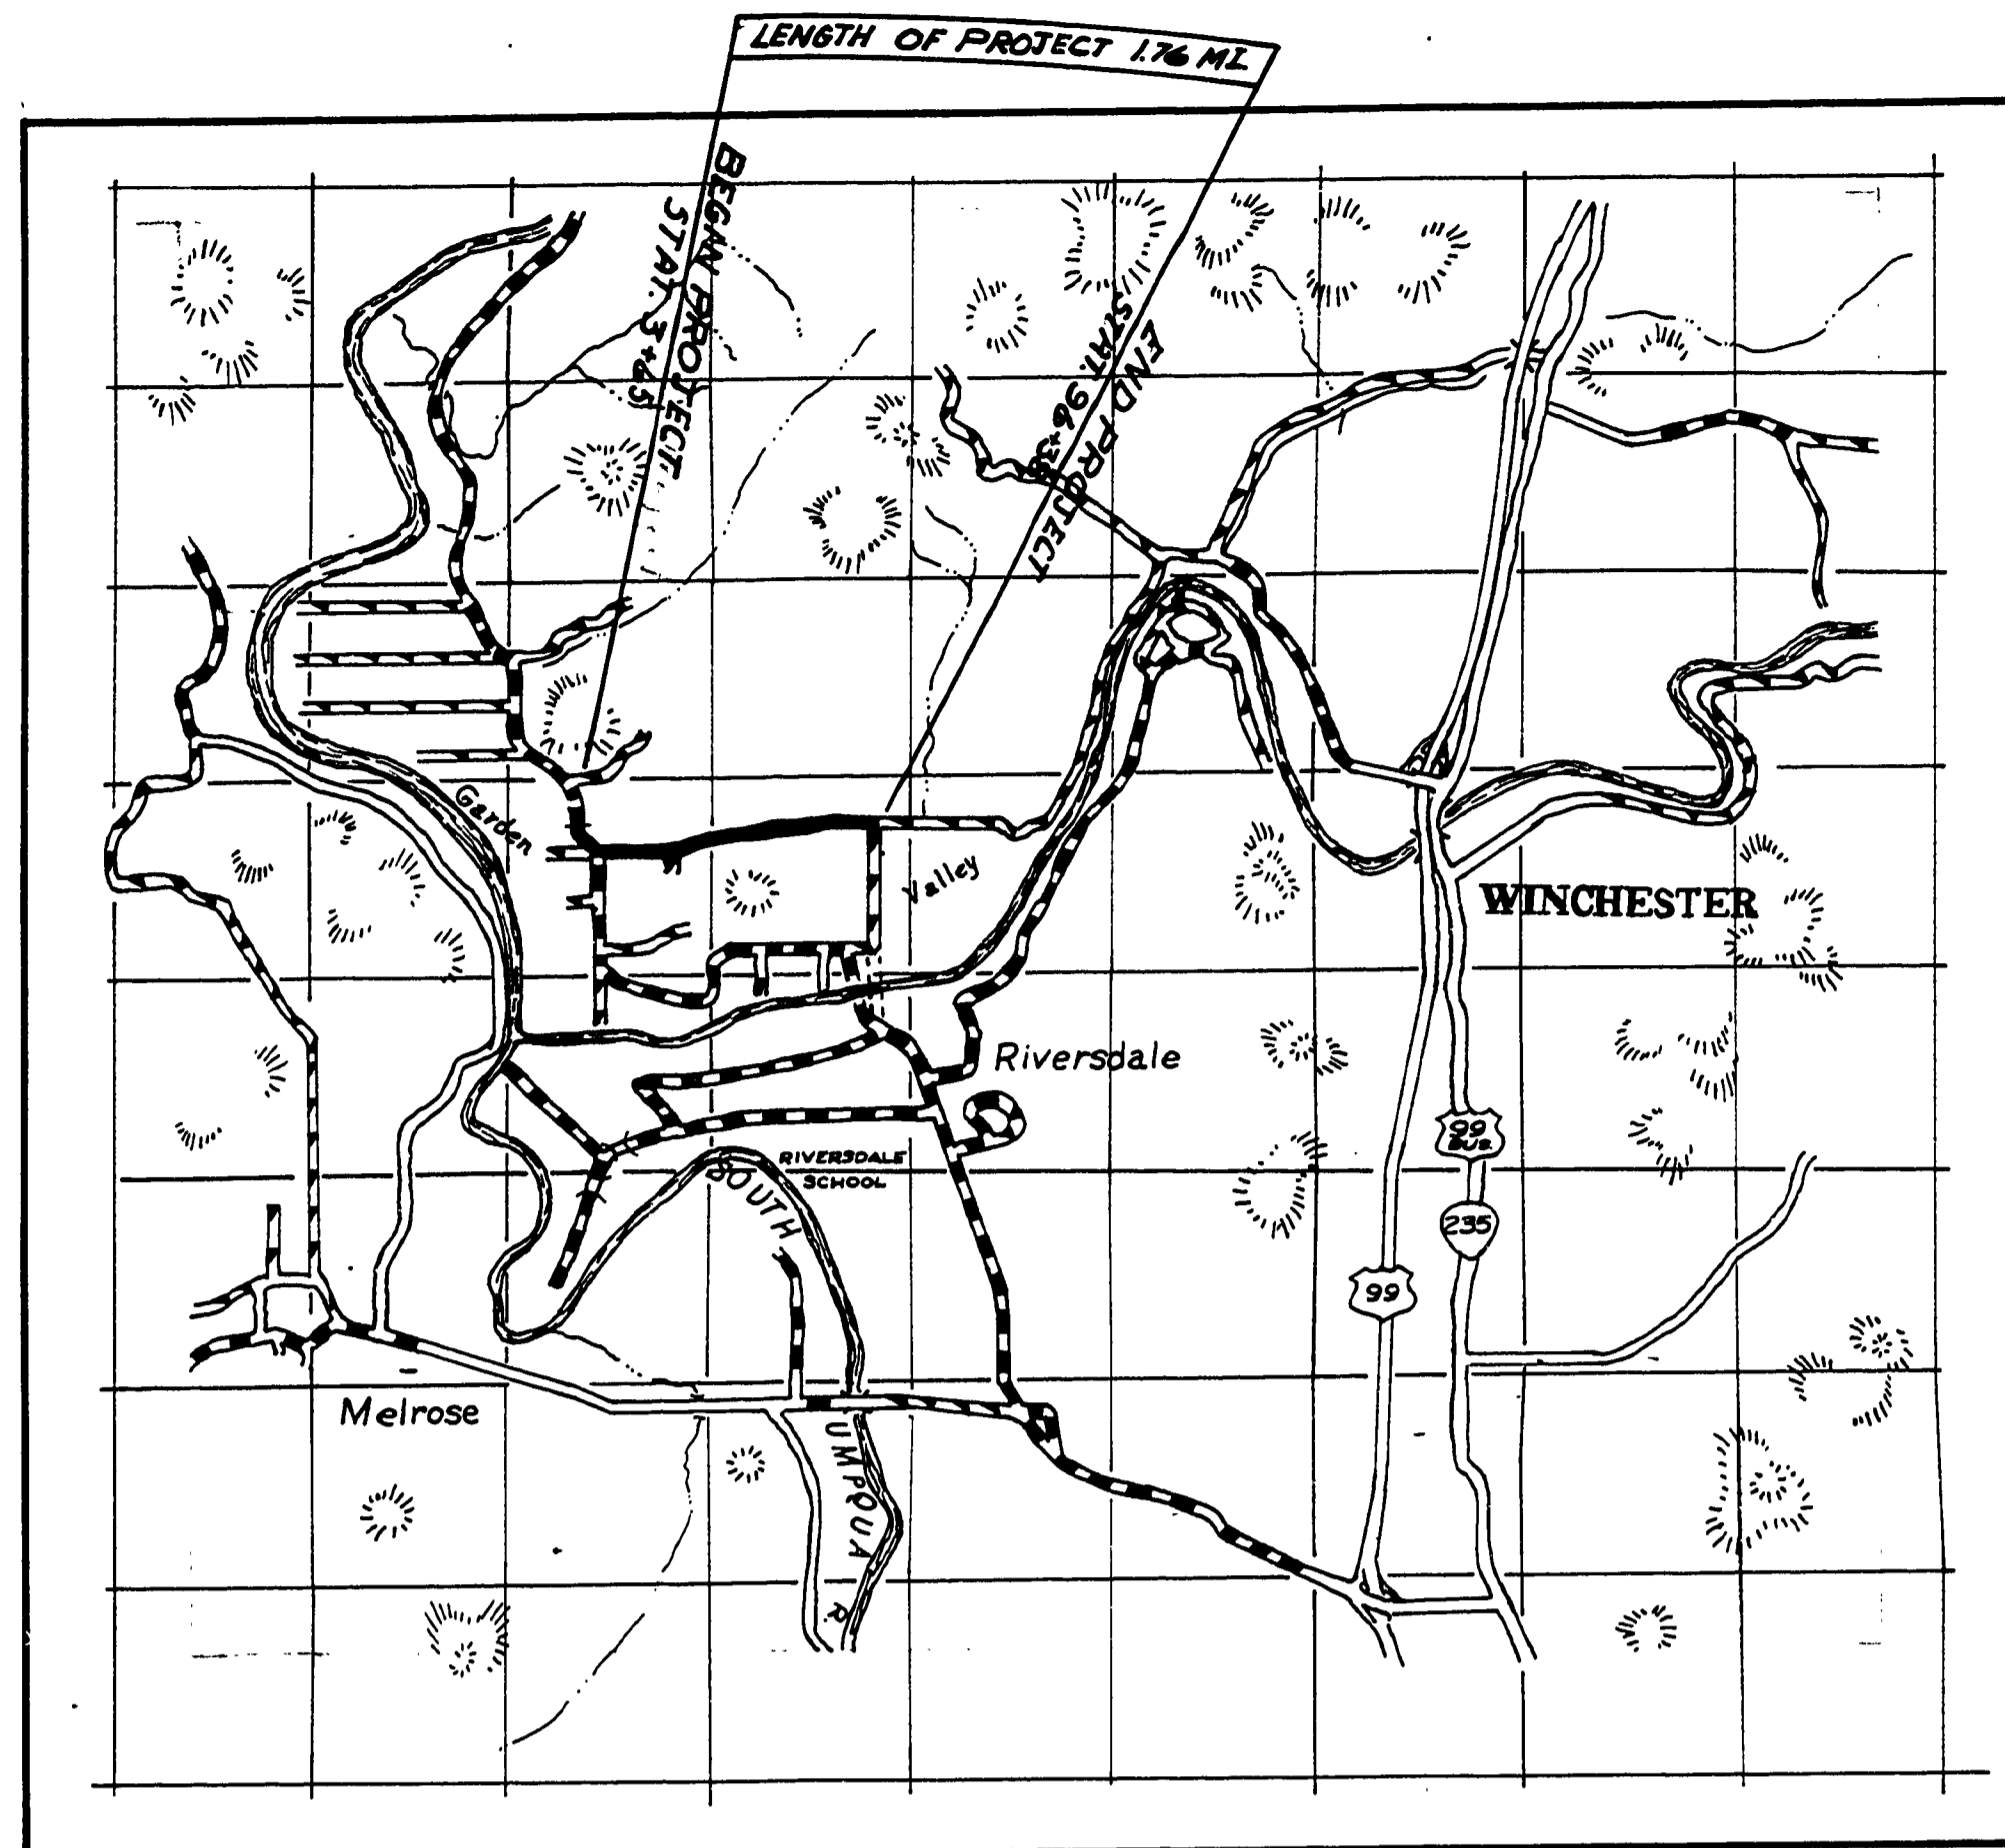

VICINITY MAP

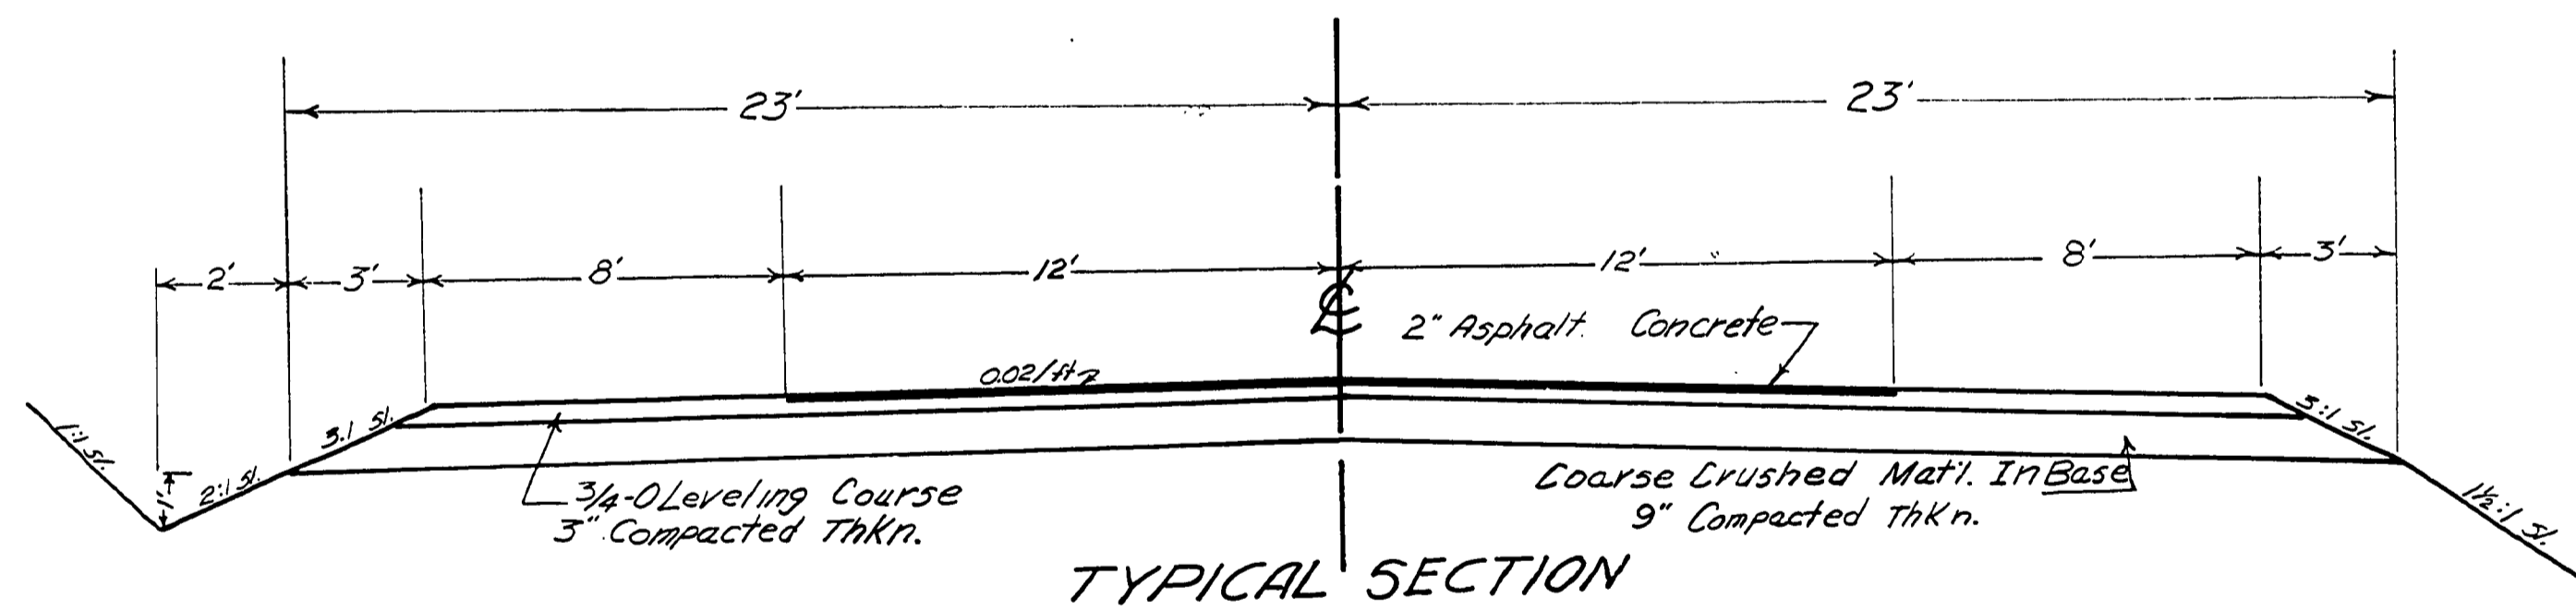

FILED  
RECEIVED  
APR 11 1969  
COUNTY SURVEYOR  
DOUGLAS COUNTY, OREGON

SHEET 1 OF 7  
As Constructed 4-11-69 o.s.

G. Rd. #31 MAY, 1967  
Sht. 1 of 7

0646047C

50'