


DOUGLAS COUNTY, OREGON
 PLANS FOR PROPOSED PROJECT
 AS CONSTRUCTED
COW CREEK ROAD
 COUNTY ROAD NO. 36
 JANUARY 1961

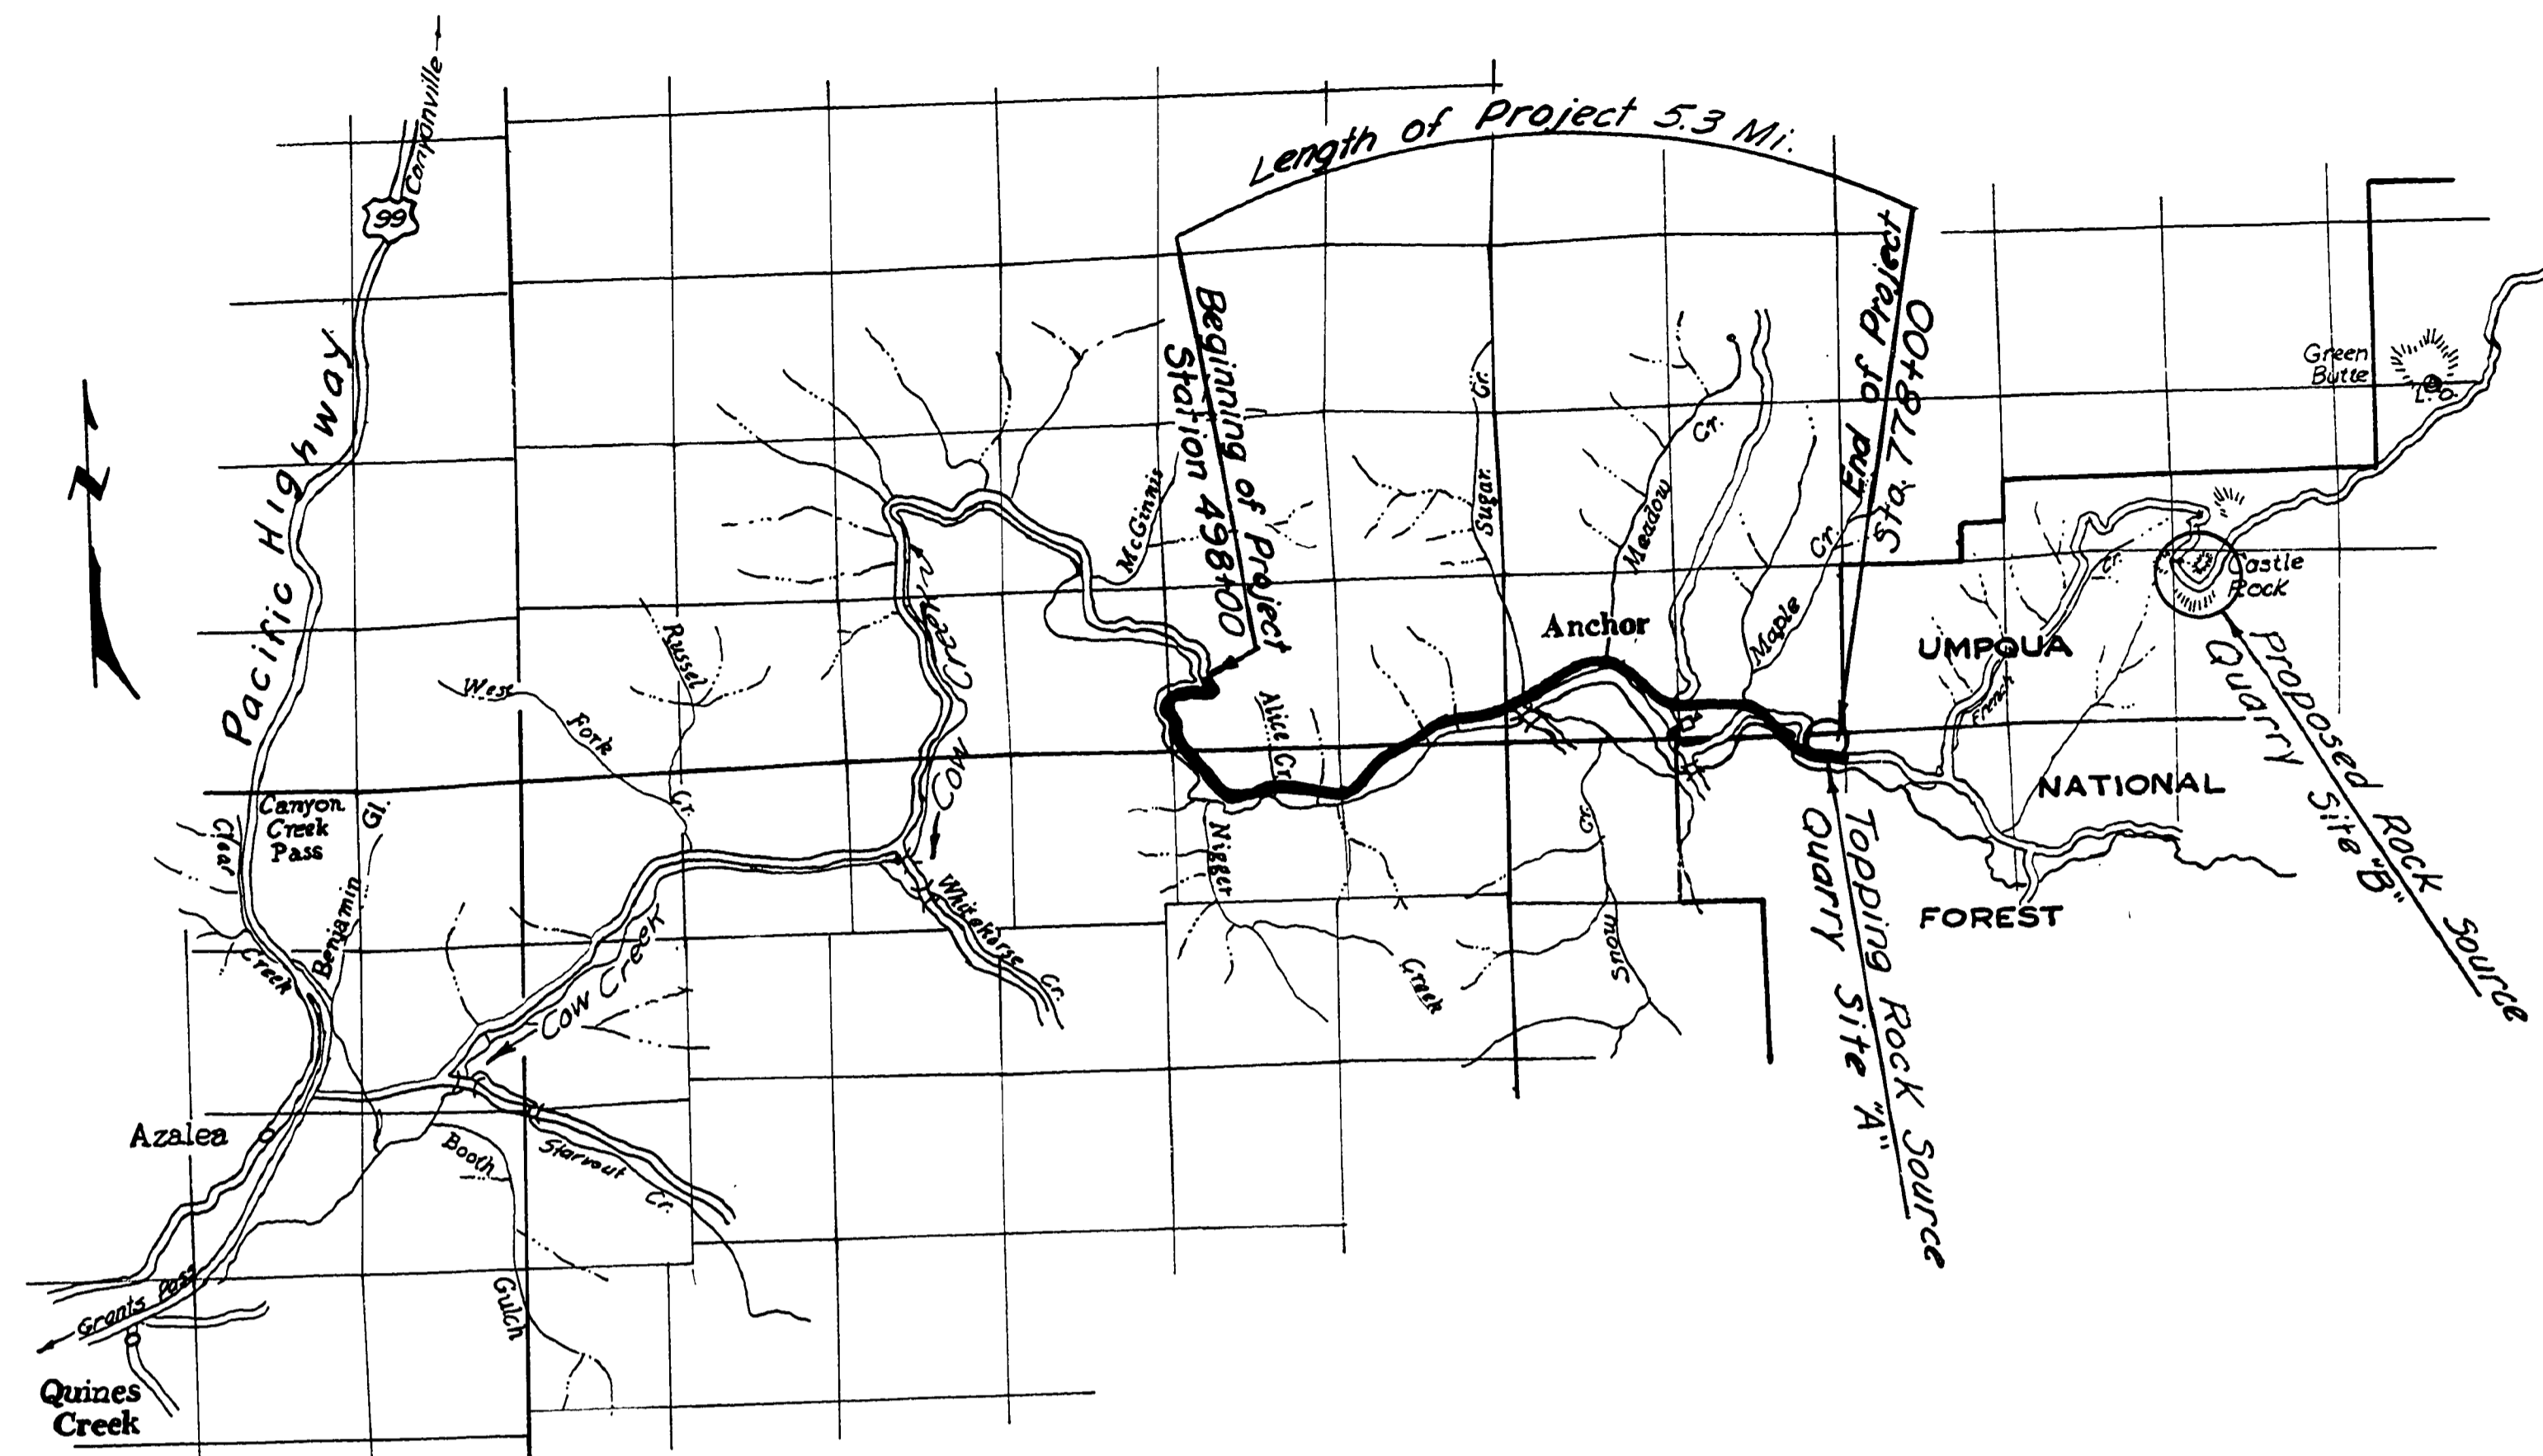


Approved W. H. Mandy
 County Engineer

Date 1/18/61



TYPICAL SECTIONS

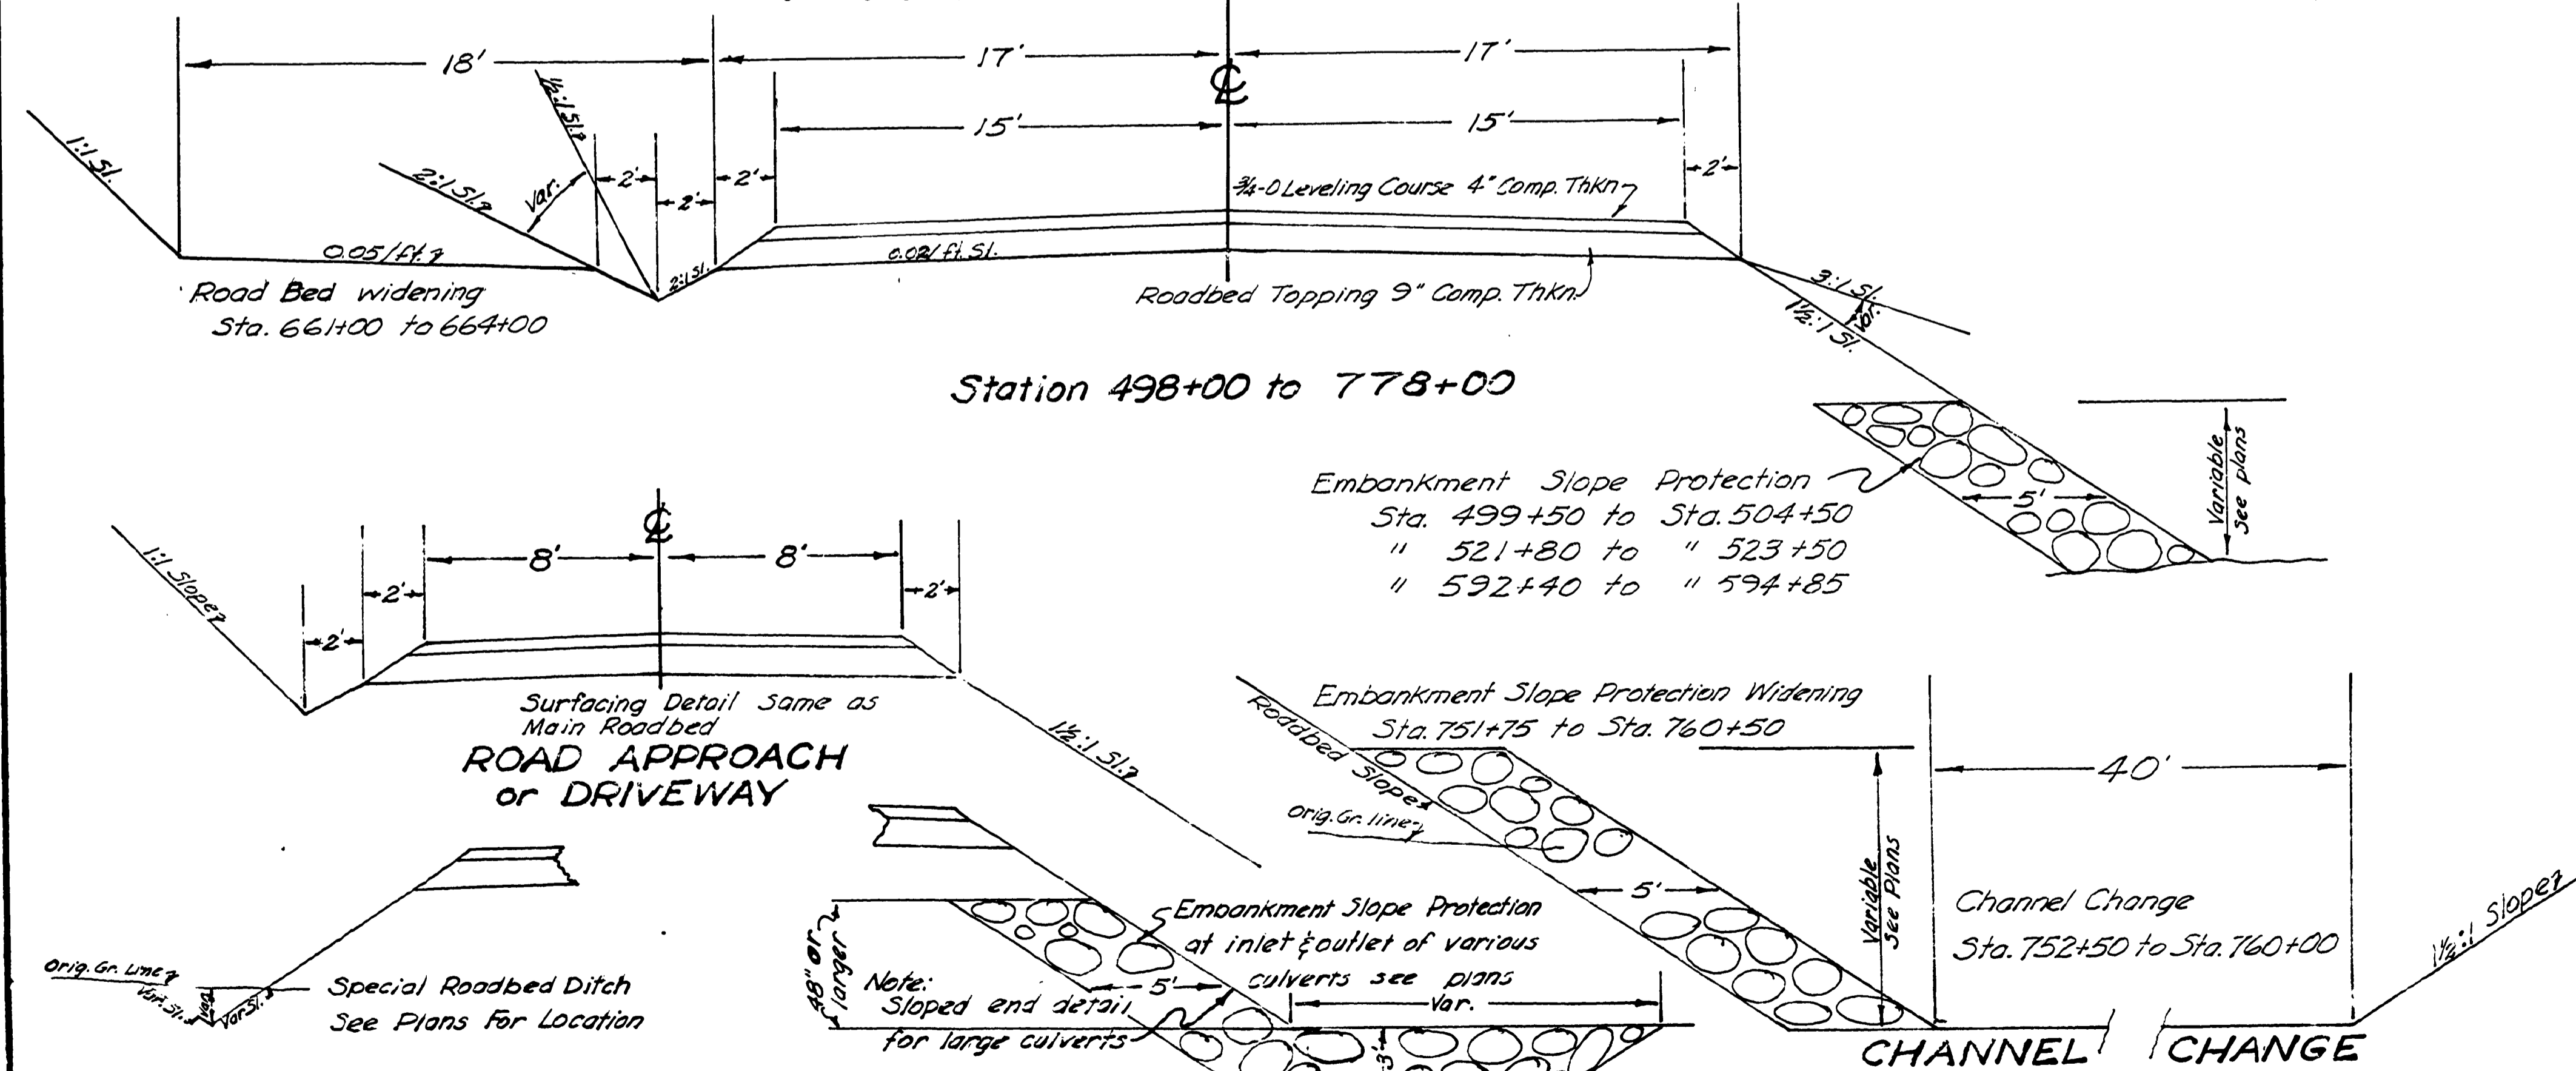

RECEIVED
 JAN 20 1961
 COUNTY ENGINEER

0920145C

(36)