


SHEET INDEX

1. SHEET LAYOUT AND SHEET INDEX
2. CONTROL NETWORK AND BASIS OF BEARING
- 3.-6. SURVEY
7. RIGHT OF WAY MONUMENT TABLE & SURVEY NARRATIVE

NE 1/4 SEC 32 T29S R5W WM
 SE 1/4 SEC 32 T29S R5W WM
 SW 1/4 SEC 33 T29S R5W WM
 NW 1/4 SEC 33 T29S R5W WM

FILED
 Date: 4-29-2013 By: JC
 This survey consists of:
 Map: CO RD # 41A
 Narrative: 7 sheets
 Corner Rpt: _____
 DOUGLAS COUNTY
 Survey 1985

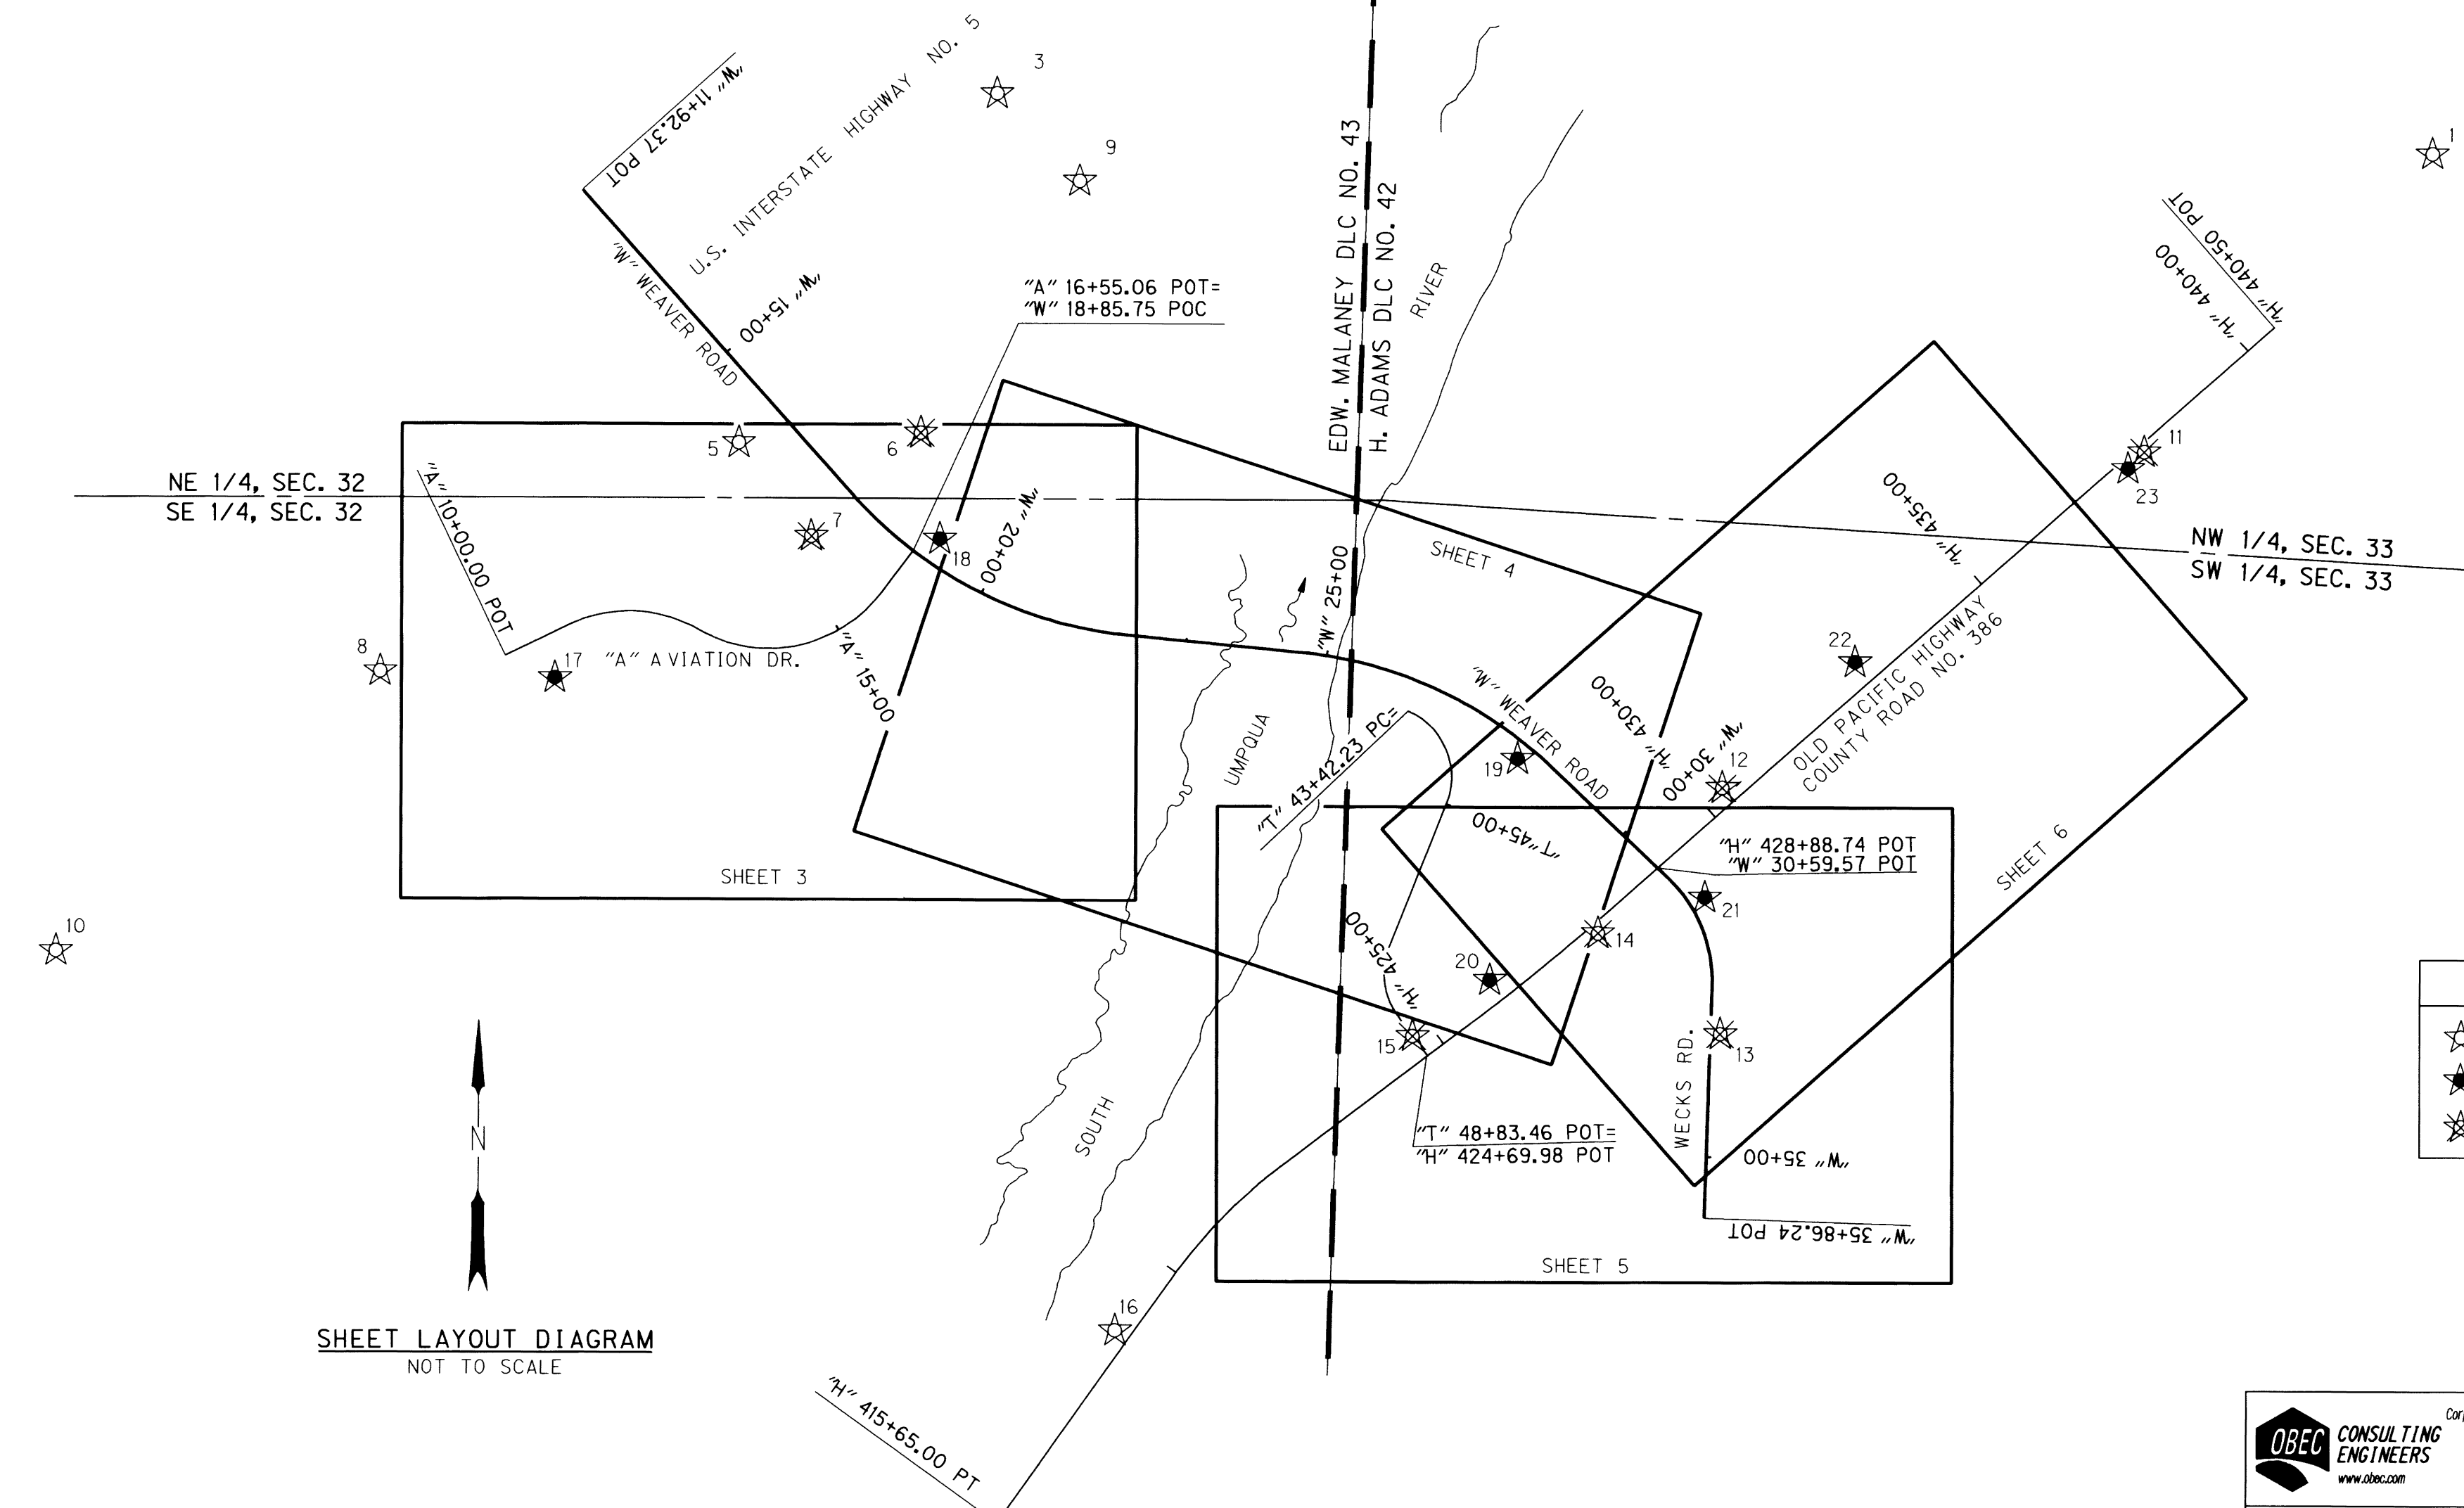

SHEET LAYOUT DIAGRAM
 NOT TO SCALE

CONTROL LEGEND	
☆	FOUND GPS NETWORK POINT
★	SET GPS NETWORK POINT
✱	DESTROYED GPS NETWORK POINT

FILE NAME: 14085mon.dgn

OBEC CONSULTING ENGINEERS
 Corporate Offices: 920 COUNTRY CLUB ROAD, SUITE 100B EUGENE, OREGON 97401-6089, 541-683-6090
 2235 MISSION STREET SE, SUITE 100 SALEM, OREGON 97302-1295, 503-589-4100
 831 O'HARE PARKWAY MEDFORD, OREGON 97504-4005, 541-774-5590
 5005 SW MEADOWS ROAD, SUITE 120 LAKE OSWEGO, OREGON 97035, 503-620-6103
 www.obec.com

OREGON DEPARTMENT OF TRANSPORTATION &
 DOUGLAS COUNTY PUBLIC WORKS
 RIGHT OF WAY BOUNDARY MONUMENTATION SURVEY
 WEAVER ROAD EXTENSION
 OLD PACIFIC HIGHWAY
 DOUGLAS COUNTY

ODOT REGION 3
 3500 NW STEWART PARKWAY
 ROSEBURG, OR. 97470 KEY # 14085
 APRIL, 2013
 NO SCALE
 SHEET 1 OF 7

REGISTERED PROFESSIONAL LAND SURVEYOR

A. Cutsforth

OREGON
 JULY 12, 2005
 ARON JAMES CUTSFORTH
 65696
 RENEWAL: DEC. 31, 2013

JIM COLTON	OBEC	DESIGNED: A. CUTSFORTH	PROJ. NO. 19-84.57
APPROVED BY: SURV. GROUP MNGR.		DRAWN: L. MILES	CHK'D: B. ELITHORP

Co. Rd. # 41A MP 0.00-0.27

CO. RD. # 41A

41A
 1

R41ACOVr