



SEC 22 T30S R2W W.M.

SE 1/4 OF THE SE 1/4

NE 1/4 OF THE SE 1/4

PLAN	DATE
REVISIONS	BY
NOTED	
NOT CHECKED	
NO. OF SHEETS	
NO.	

PROFILE	DATE
REVISIONS	BY
NOTED	
NOT CHECKED	
STRUCTURE NOTATION CHECKED	
NO.	

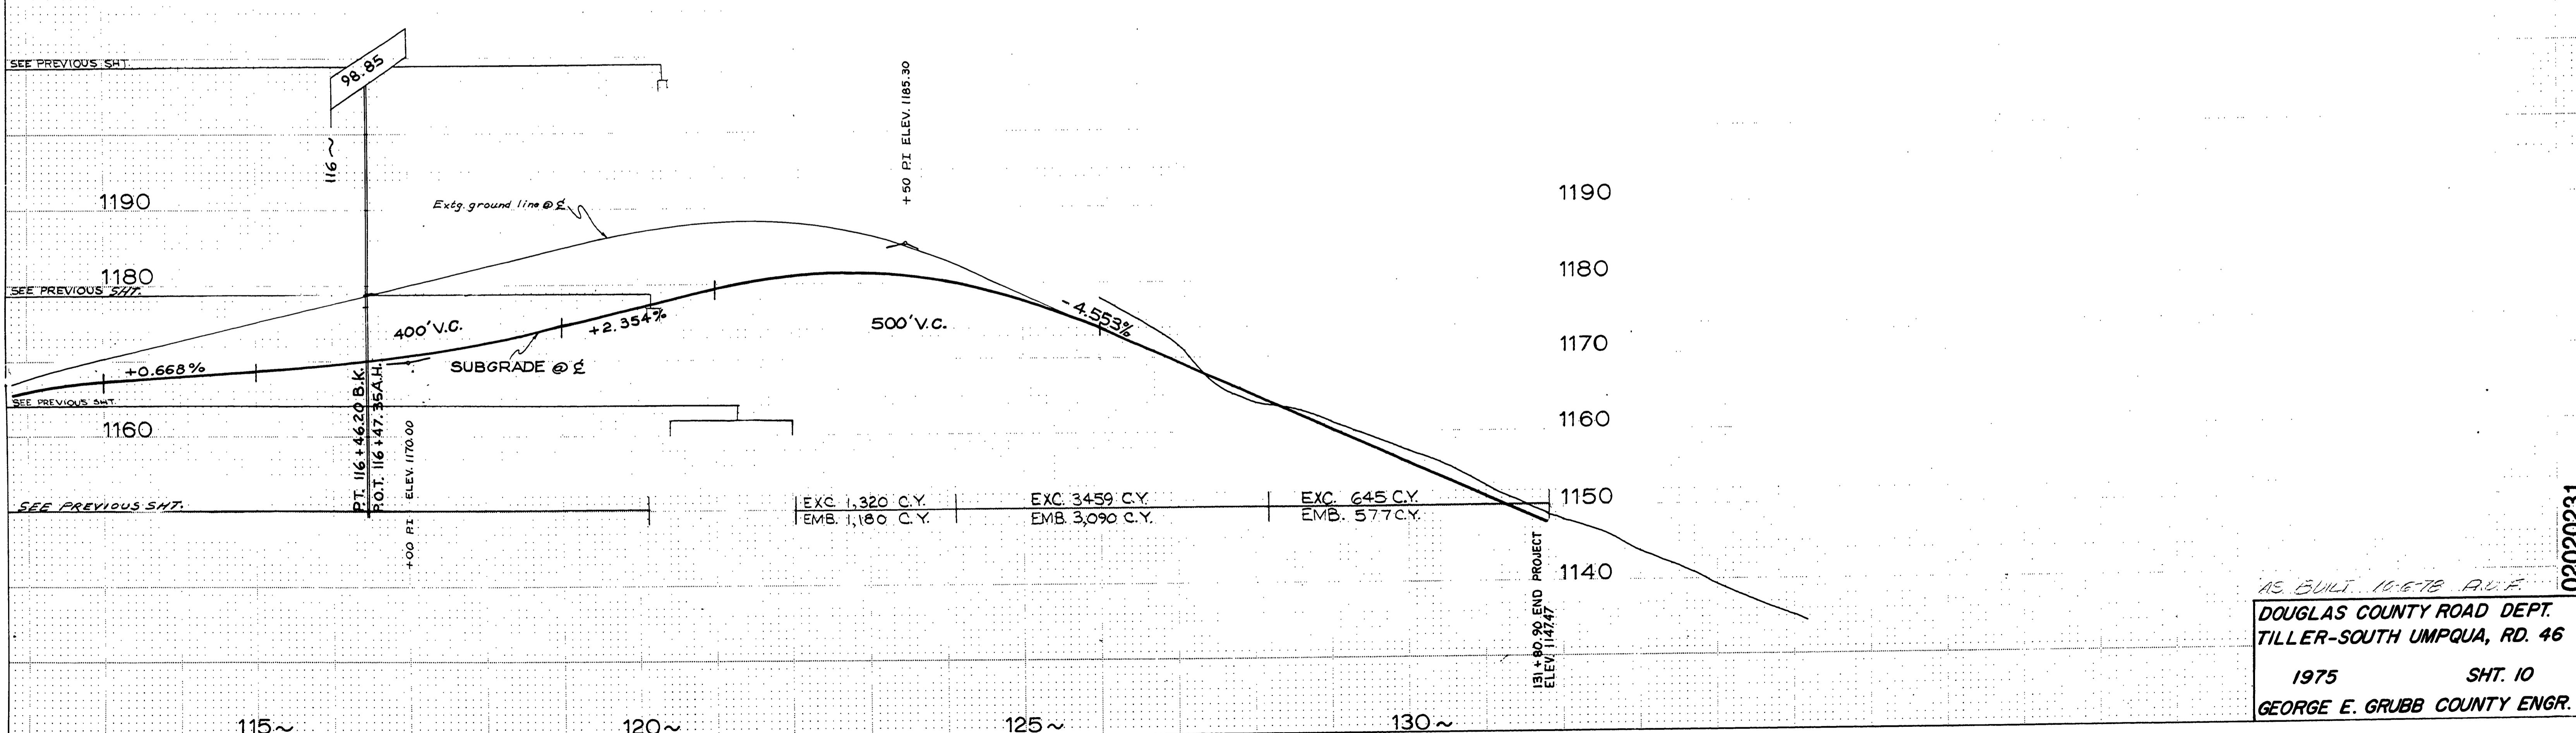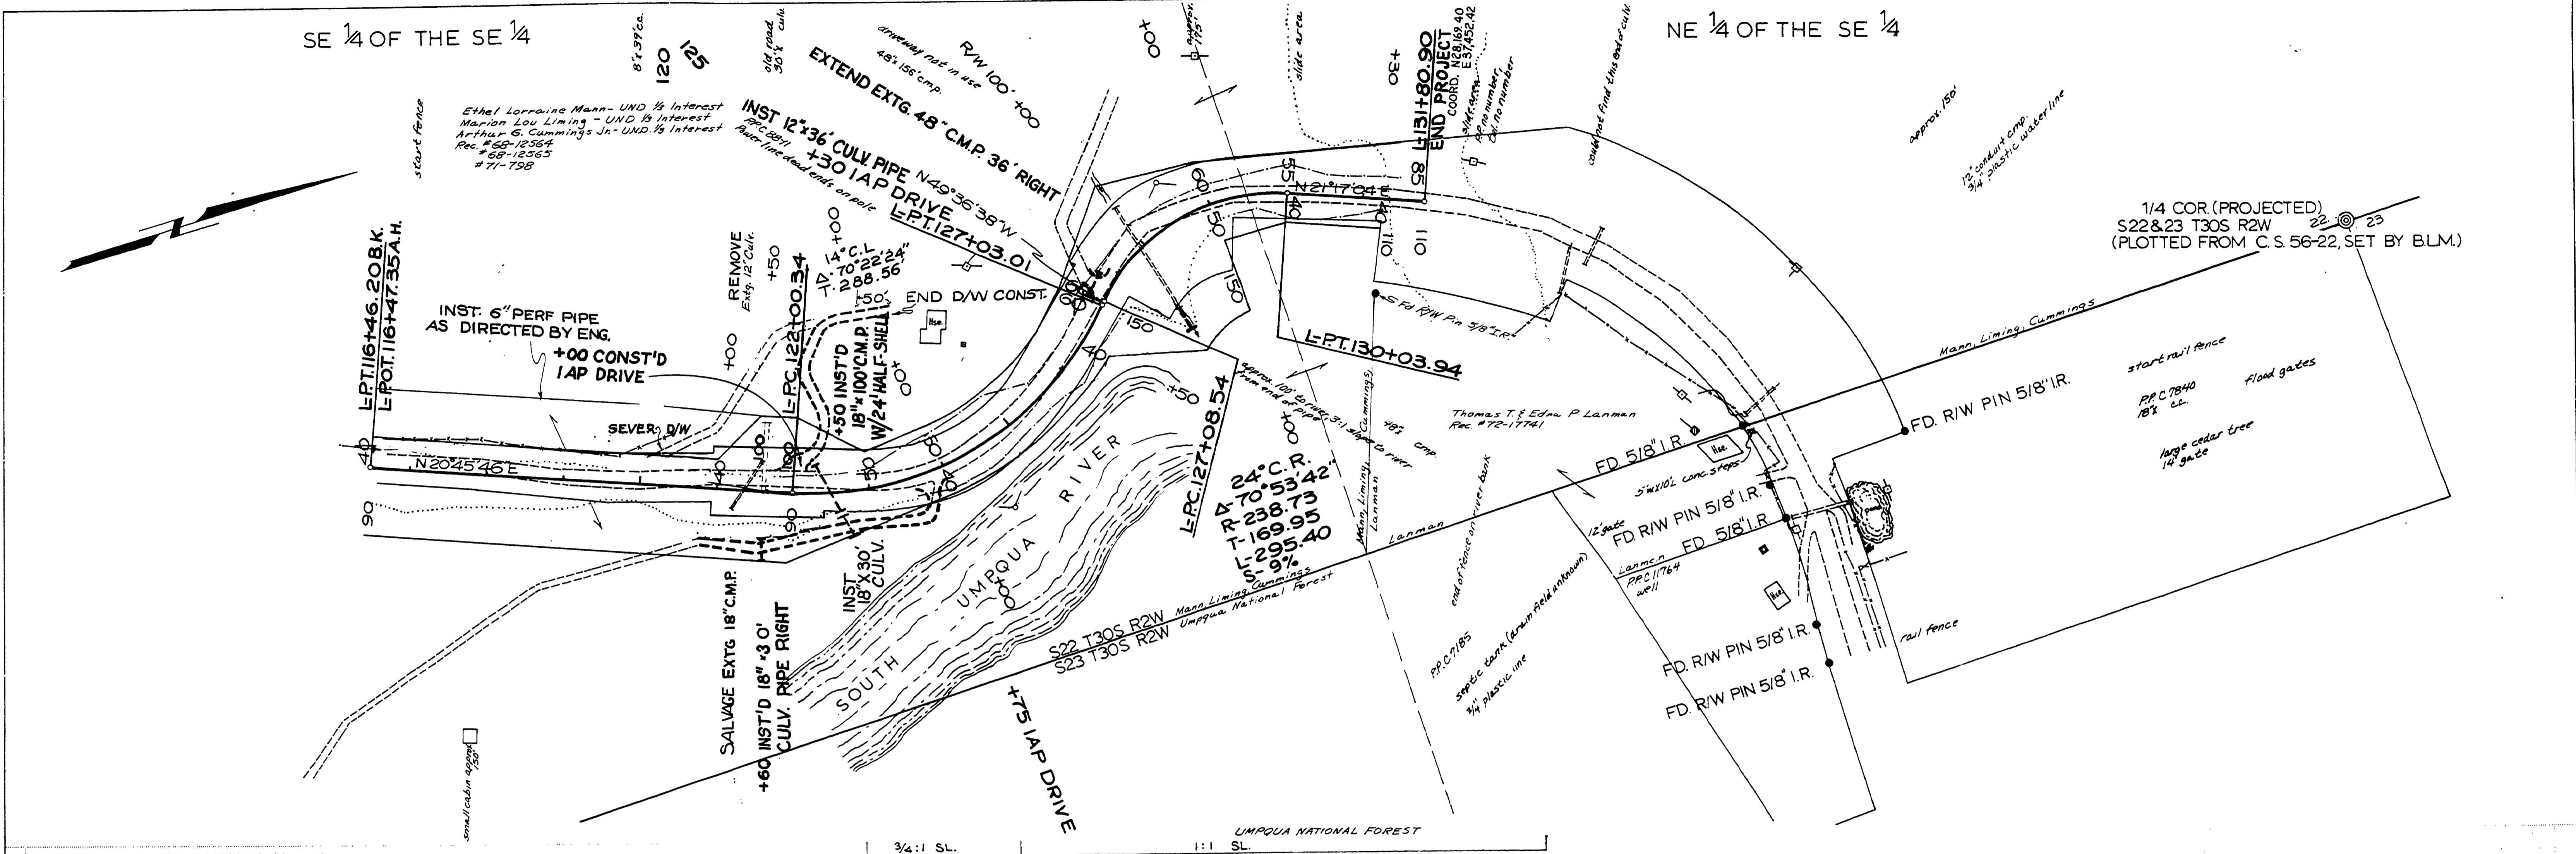

AS BUILT 10-16-78 R.D.F.
 DOUGLAS COUNTY ROAD DEPT.
 TILLER-SOUTH UMPQUA, RD. 46
 1975 SHT. 10
 GEORGE E. GRUBB COUNTY ENGR.

02020231