
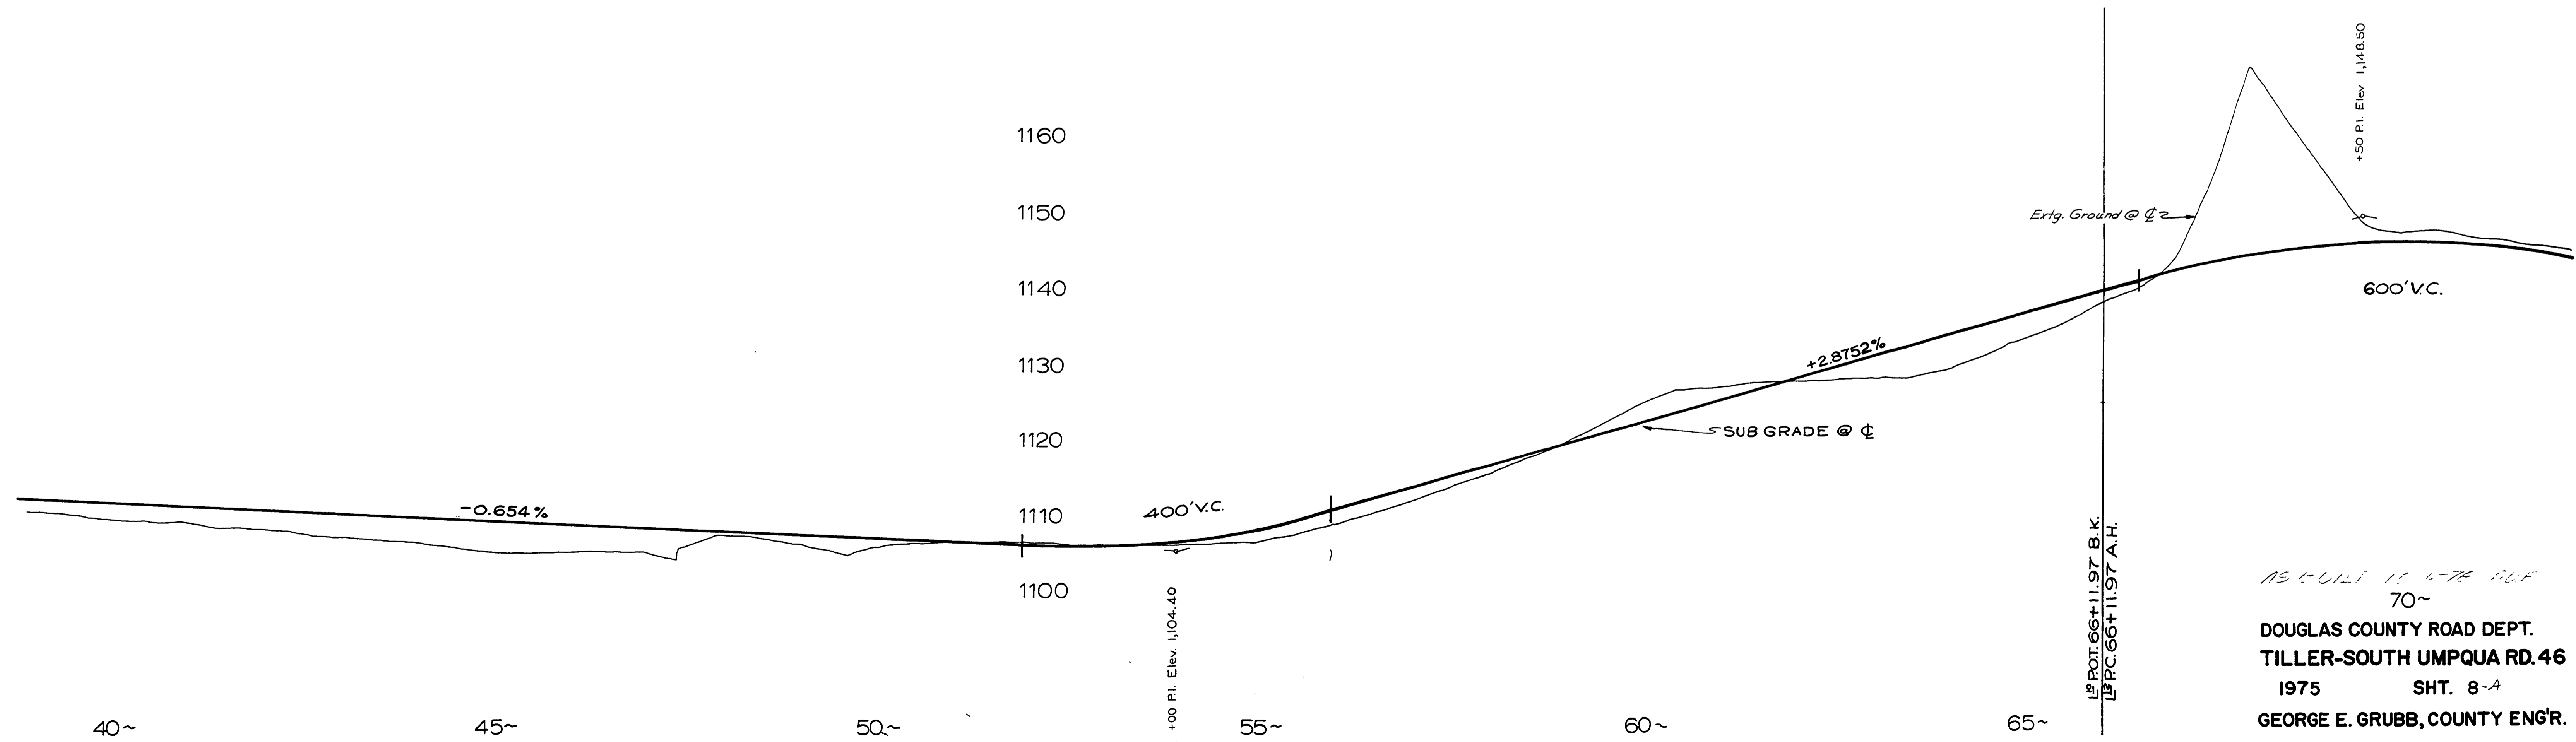


S 13 & 24 T 30 S R 2 W W.M.

RD. 46

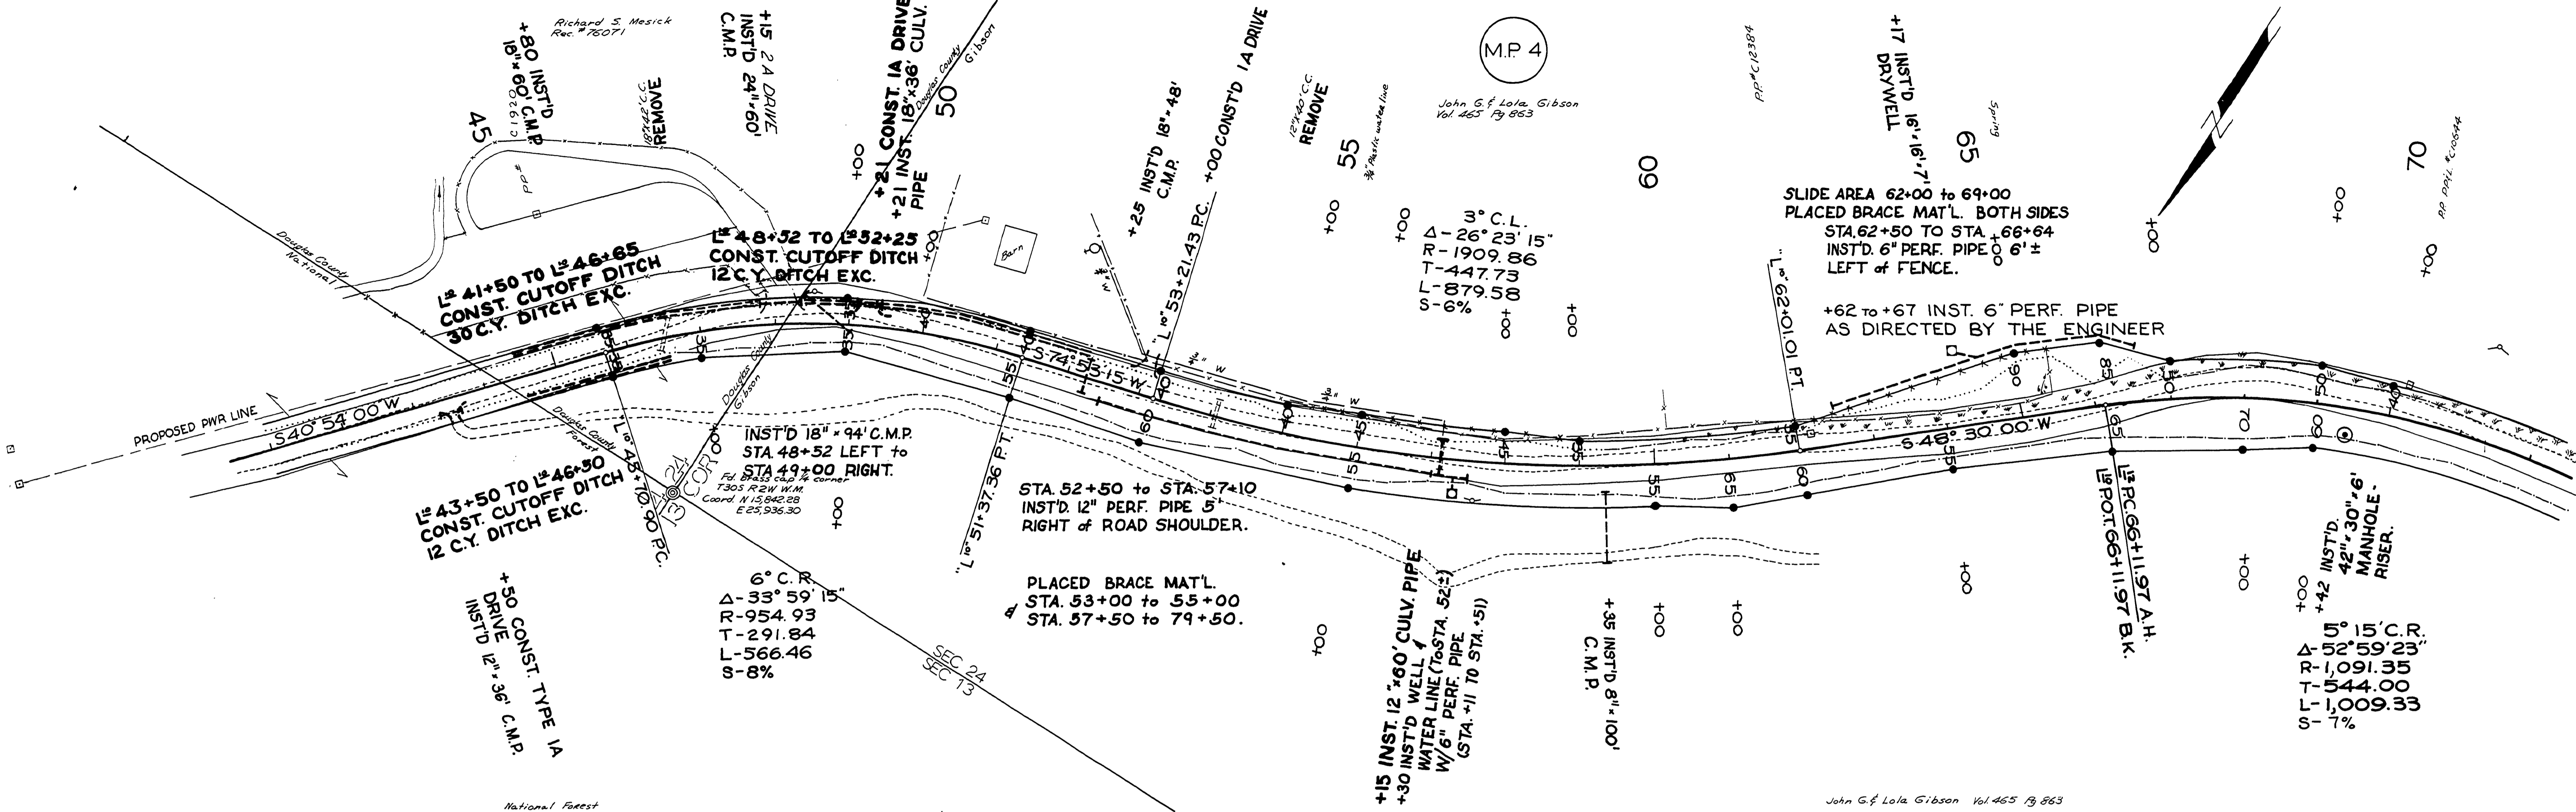

AS-BUILT 11-16-75
 70~
 DOUGLAS COUNTY ROAD DEPT.
 TILLER-SOUTH UMPQUA RD. 46
 1975 SHT. 8-A
 GEORGE E. GRUBB, COUNTY ENGR.

04260377

1975
 G. Rd. # 46 SHT. 8-A of 9-A (66)

M.P. 4.26-3.77