
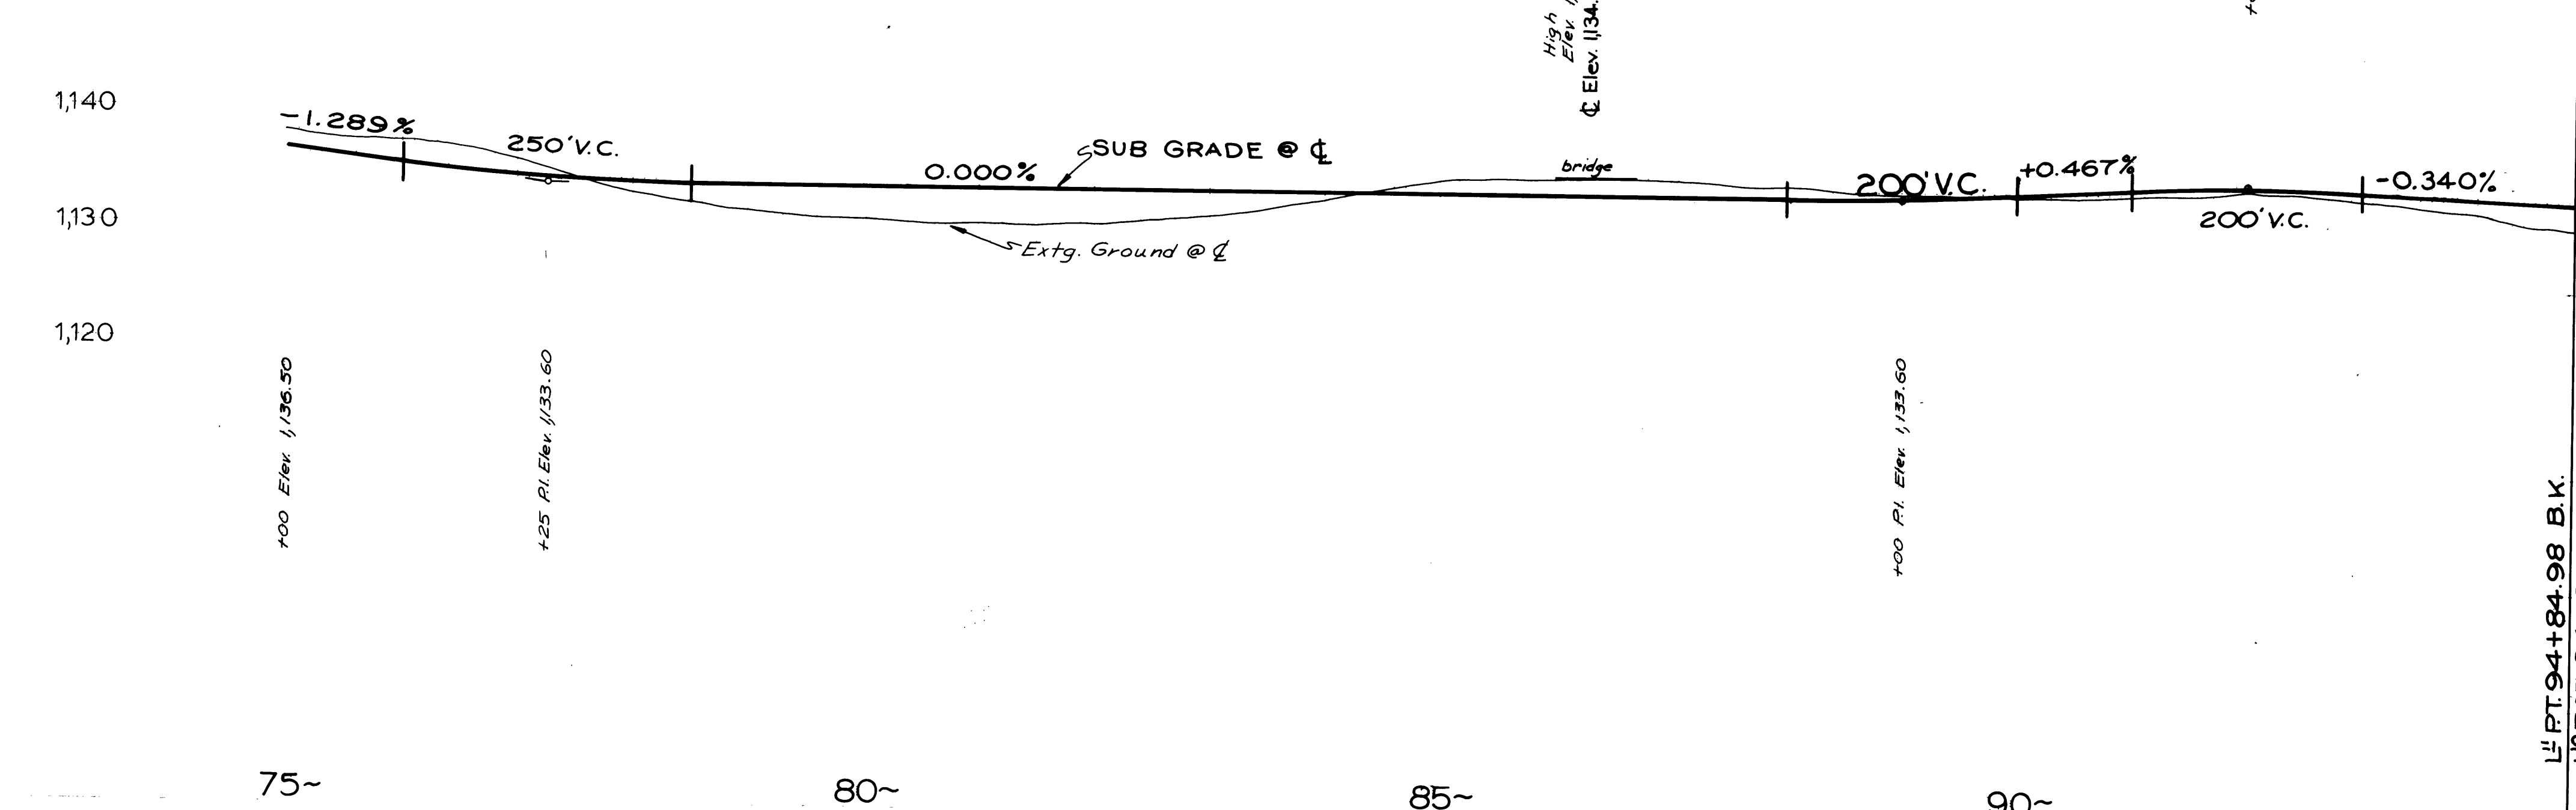


S18 T30S R1W W.M.

PLAN	SURVEYED	DATE
NO	BY	
	NOTE BOOK	
	ALIGNMENT CHECKED	
	HT. DI. WAY CHECKED	

PROFILE	SURVEYED	DATE
NO	BY	
	NOTE BOOK	
	GRADES CHECKED	
	STRUCTURE NOTATIONS CHECKED	

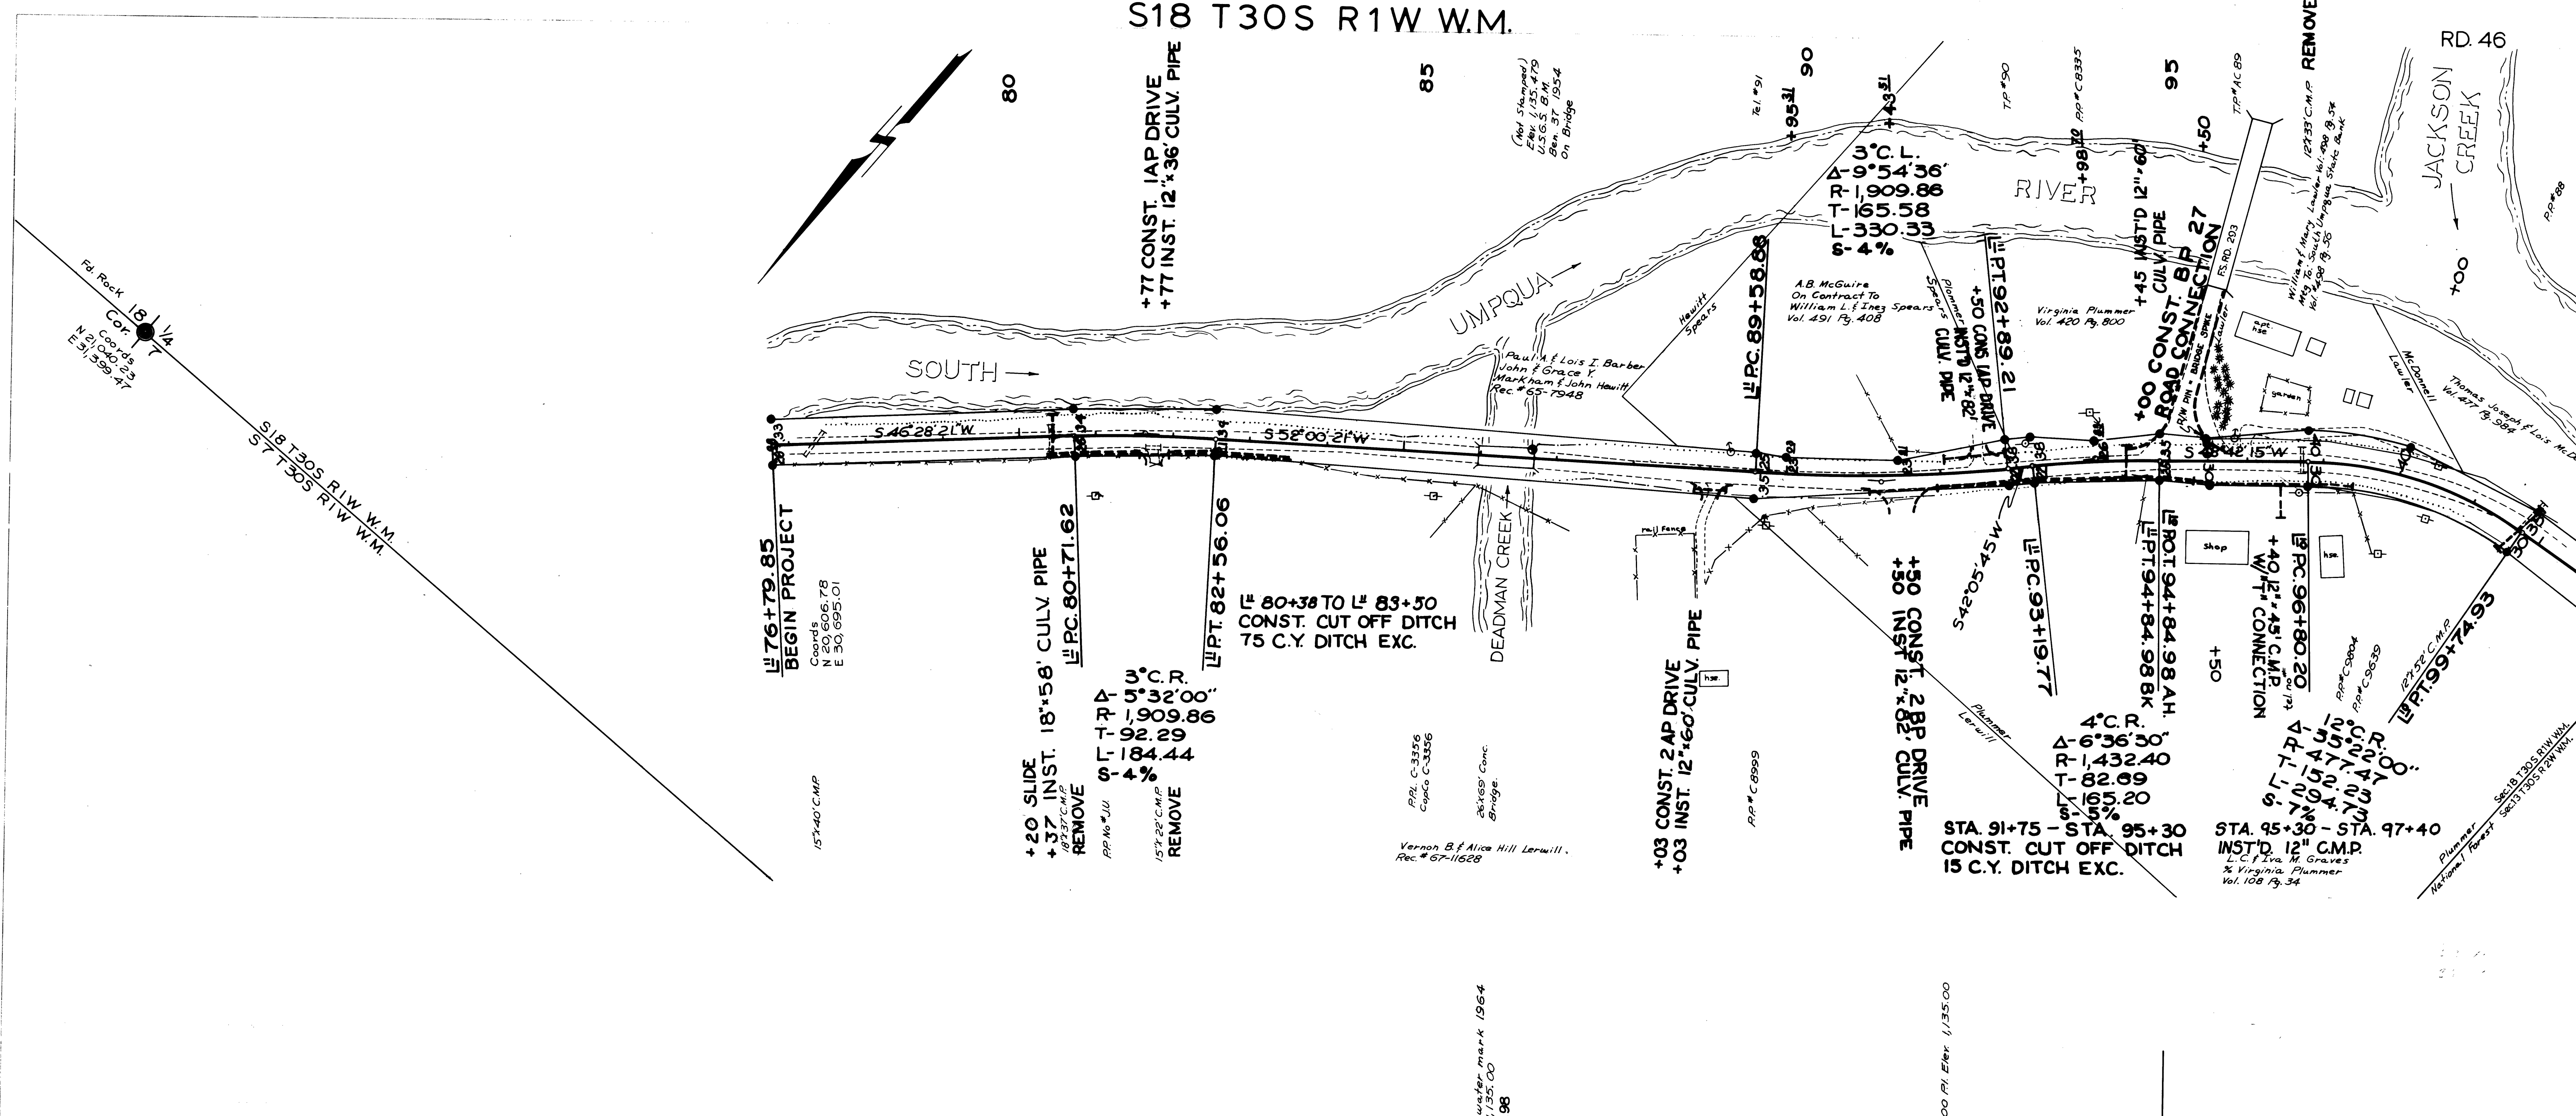

FILED
 Date: 1-21-1975 By: JP
 This survey consists of:
 Map: Co. Rd. # 46
 Narratives:
 Corner Rpt:
 DOUGLAS COUNTY SURVEYOR

AS BUILT 10-6-75 A.H.E.
 DOUGLAS COUNTY ROAD DEPT.
 TILLER-SOUTH UMPQUA RD. 46
 1975 SHT. 5A
 GEORGE E. GRUBB, COUNTY ENGR.

05570521