


DOUGLAS COUNTY, OREGON
 PLANS FOR PROPOSED PROJECT
 GRADING & SURFACING
DILLARD-BROCKWAY-LOOKINGGLASS
ROAD NO. 47

1973

MILE POINT 0.47 TO MILE POINT 1.42

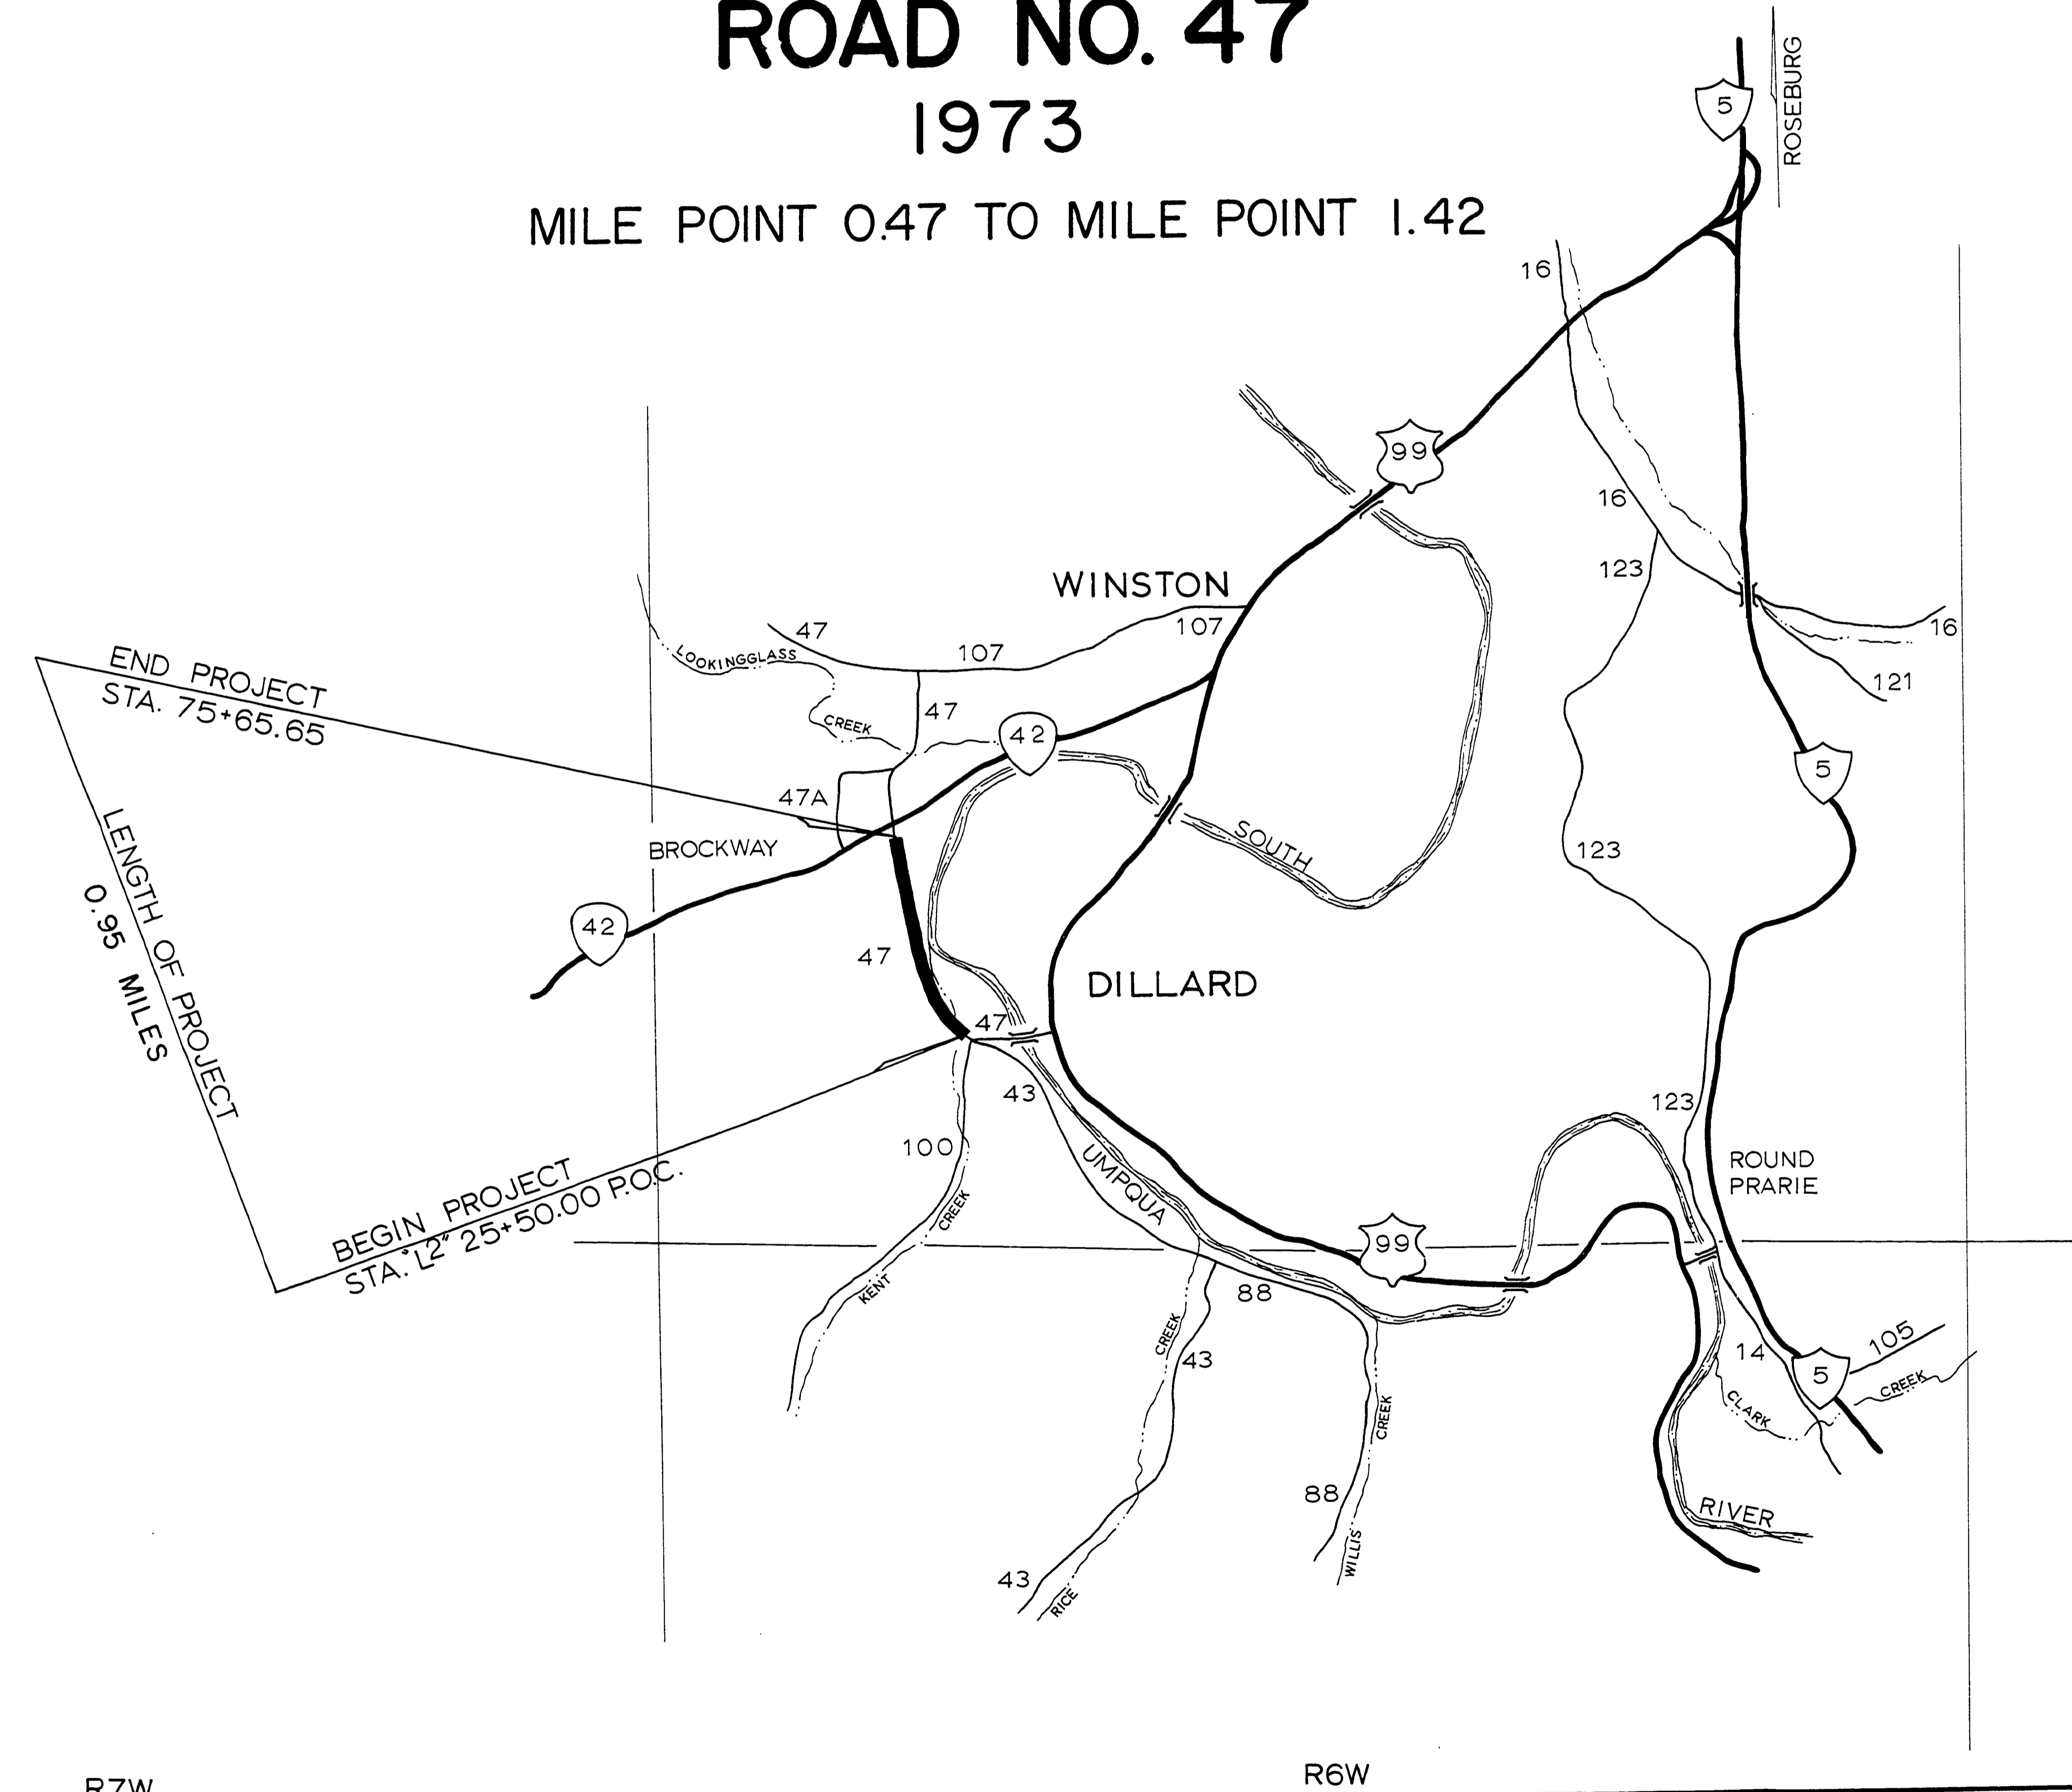

INDEX OF DRAWINGS

SHEET NUMBER	
1	TITLE SHEET
2	QUANTITY SUMMARY
3	TYPICAL SECTIONS
4,5 & 6	ROAD PLANS
STANDARD DRAWINGS	
1,2,3,9 & 14	
TOTAL OF 11 SHEETS	



NOT REVISED
 AS CONSTRUCTED

DOUGLAS COUNTY ROAD DEPT
**DILLARD-BROCKWAY-
 LOOKINGGLASS ROAD NO. 47**
 1973 SHT 1
 GEORGE E. GRUBB COUNTY ENGR

(HAVE ON FILE - sheets 4, 5, 6) 1973
 Co. Rd. # 47 SHT. 1 OF 6 (27)

0047014C

