


HAROLD J. NICHOLS &
CYRIL H. ESTATE # 4741
5426

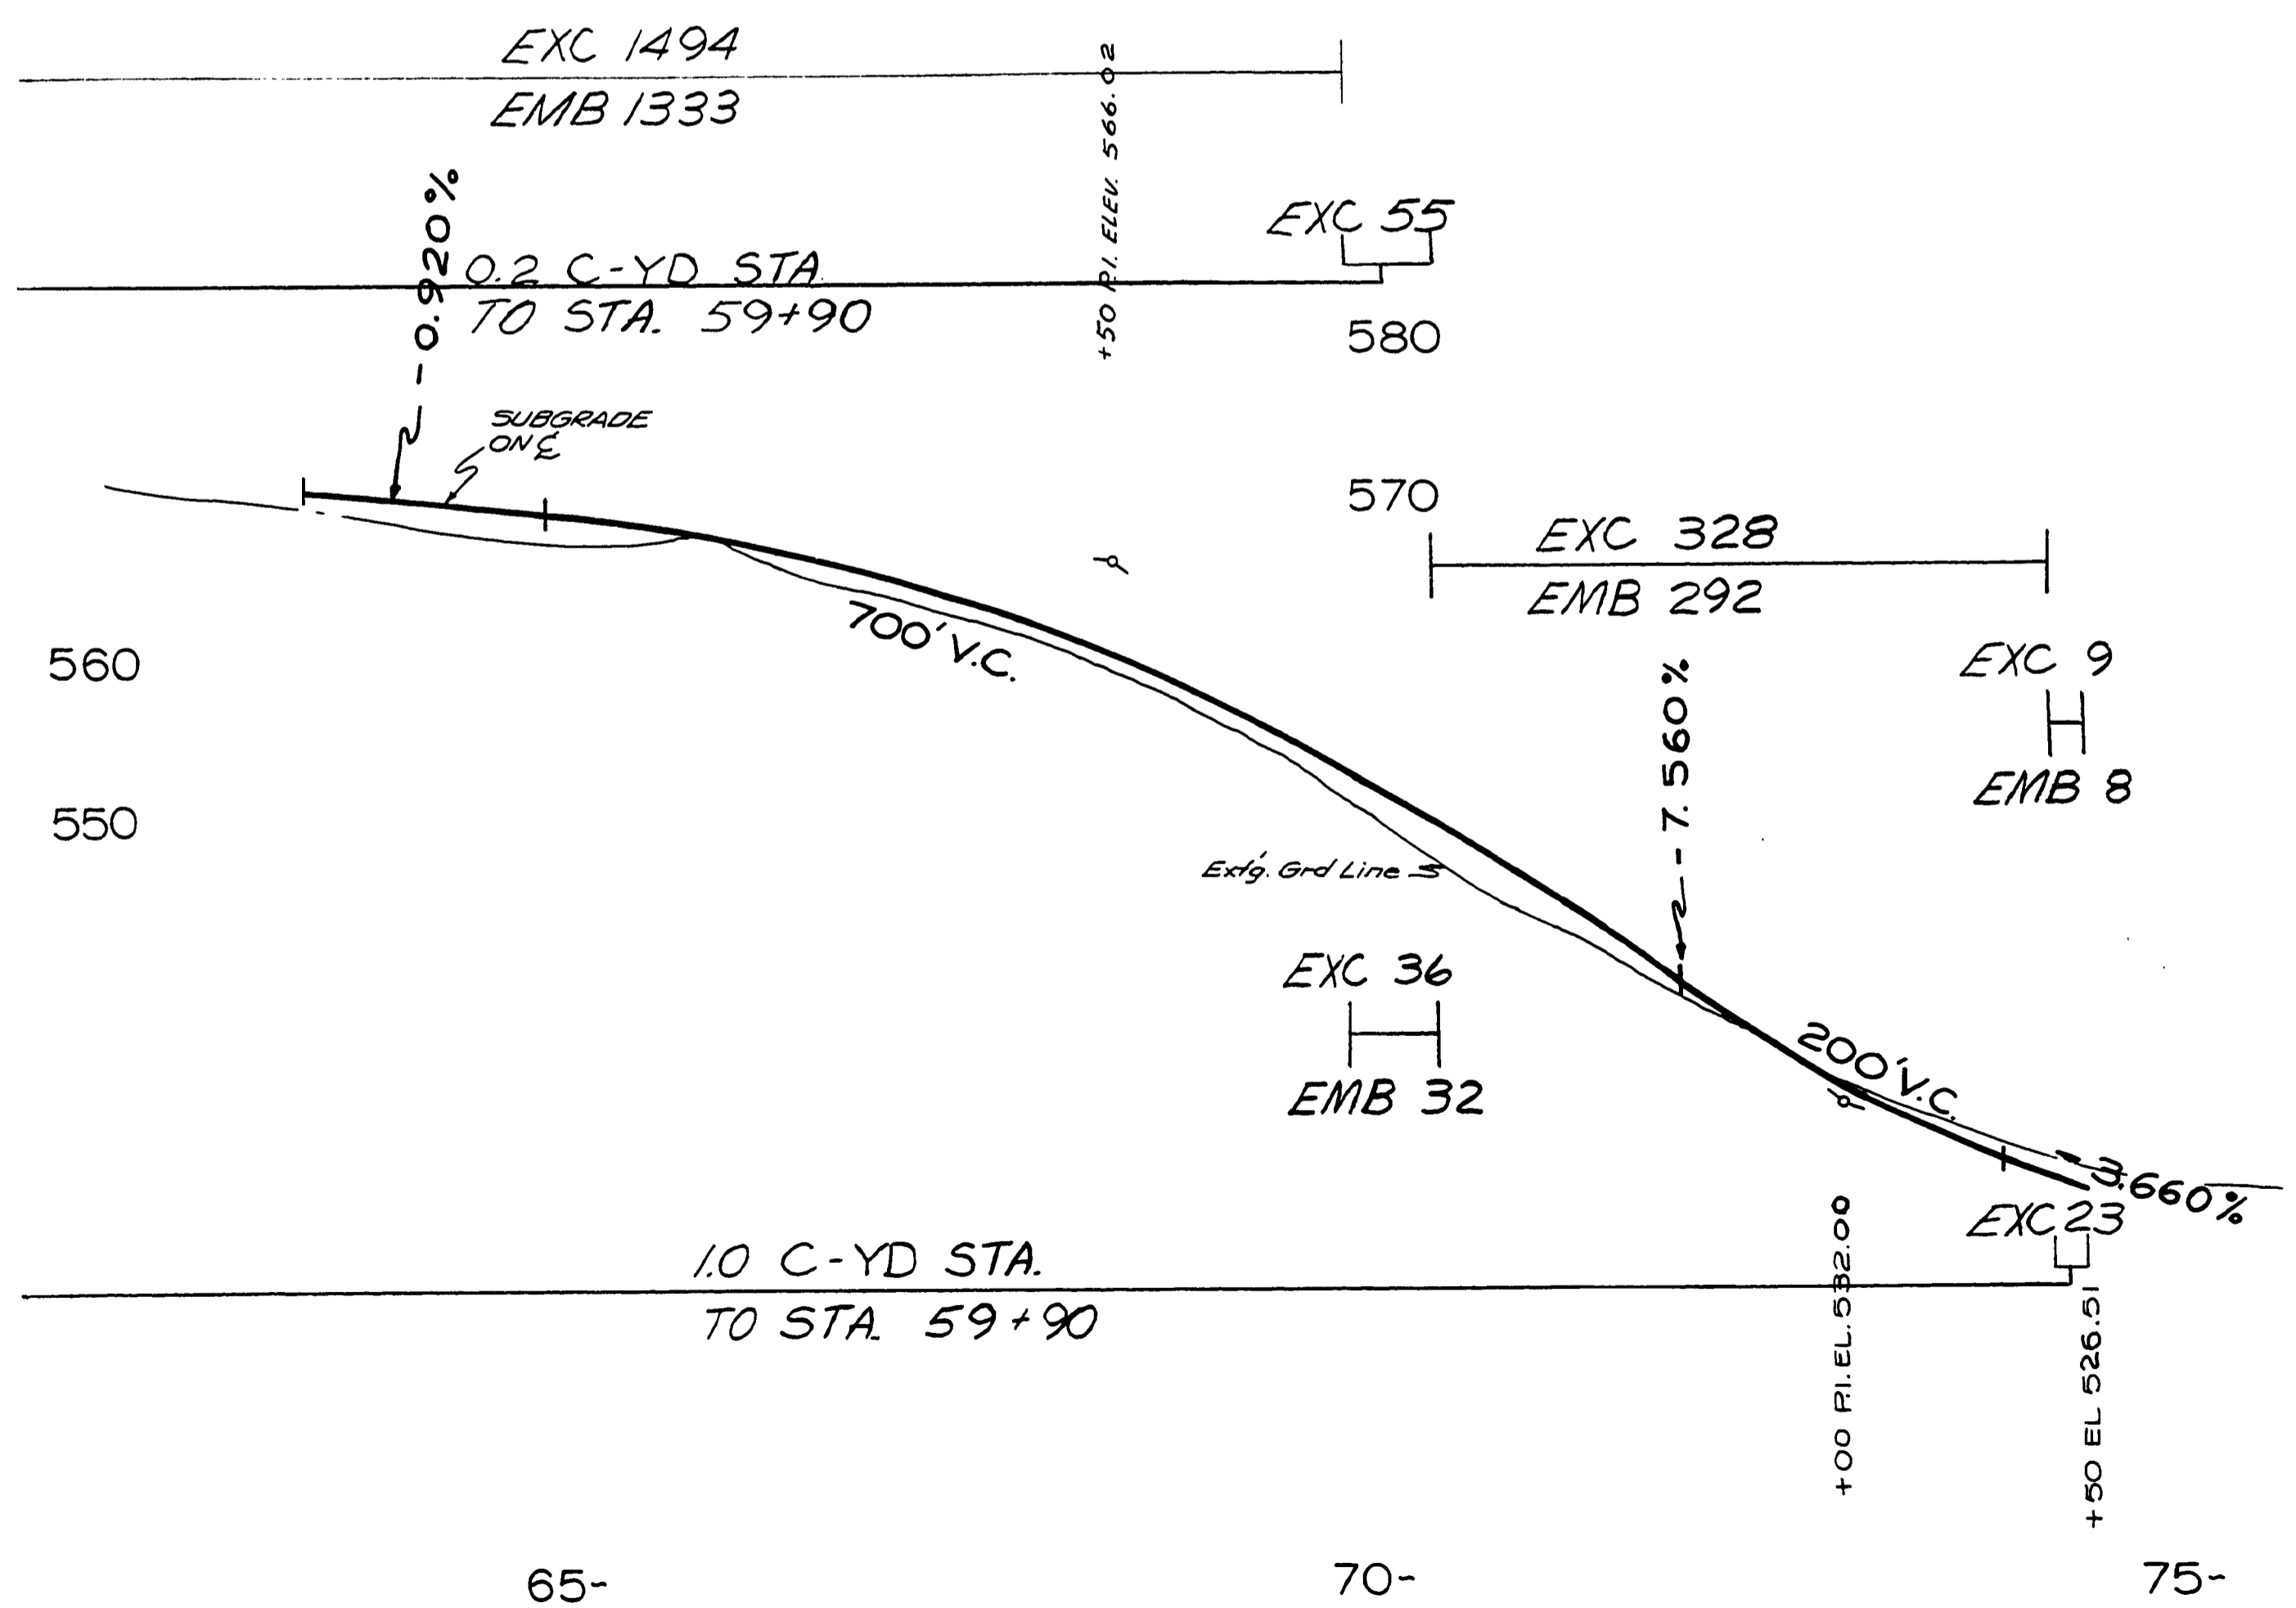

NOT REVISED
AS CONSTRUCTED

FILED
RECEIVED
COUNTY SURVEYOR
DOUGLAS COUNTY, ORE.

DOUGLAS COUNTY ROAD DEPT
DILLARD-BROCKWAY-LOOK-
INGGLASS # 47 1973 SHT 6
GEORGE E. GRUBB COUNTY ENGR.

01220142

M.P. 1.22-1.42

1973
Co. Rd. # 47 Sht. 6 of 6 (90)