
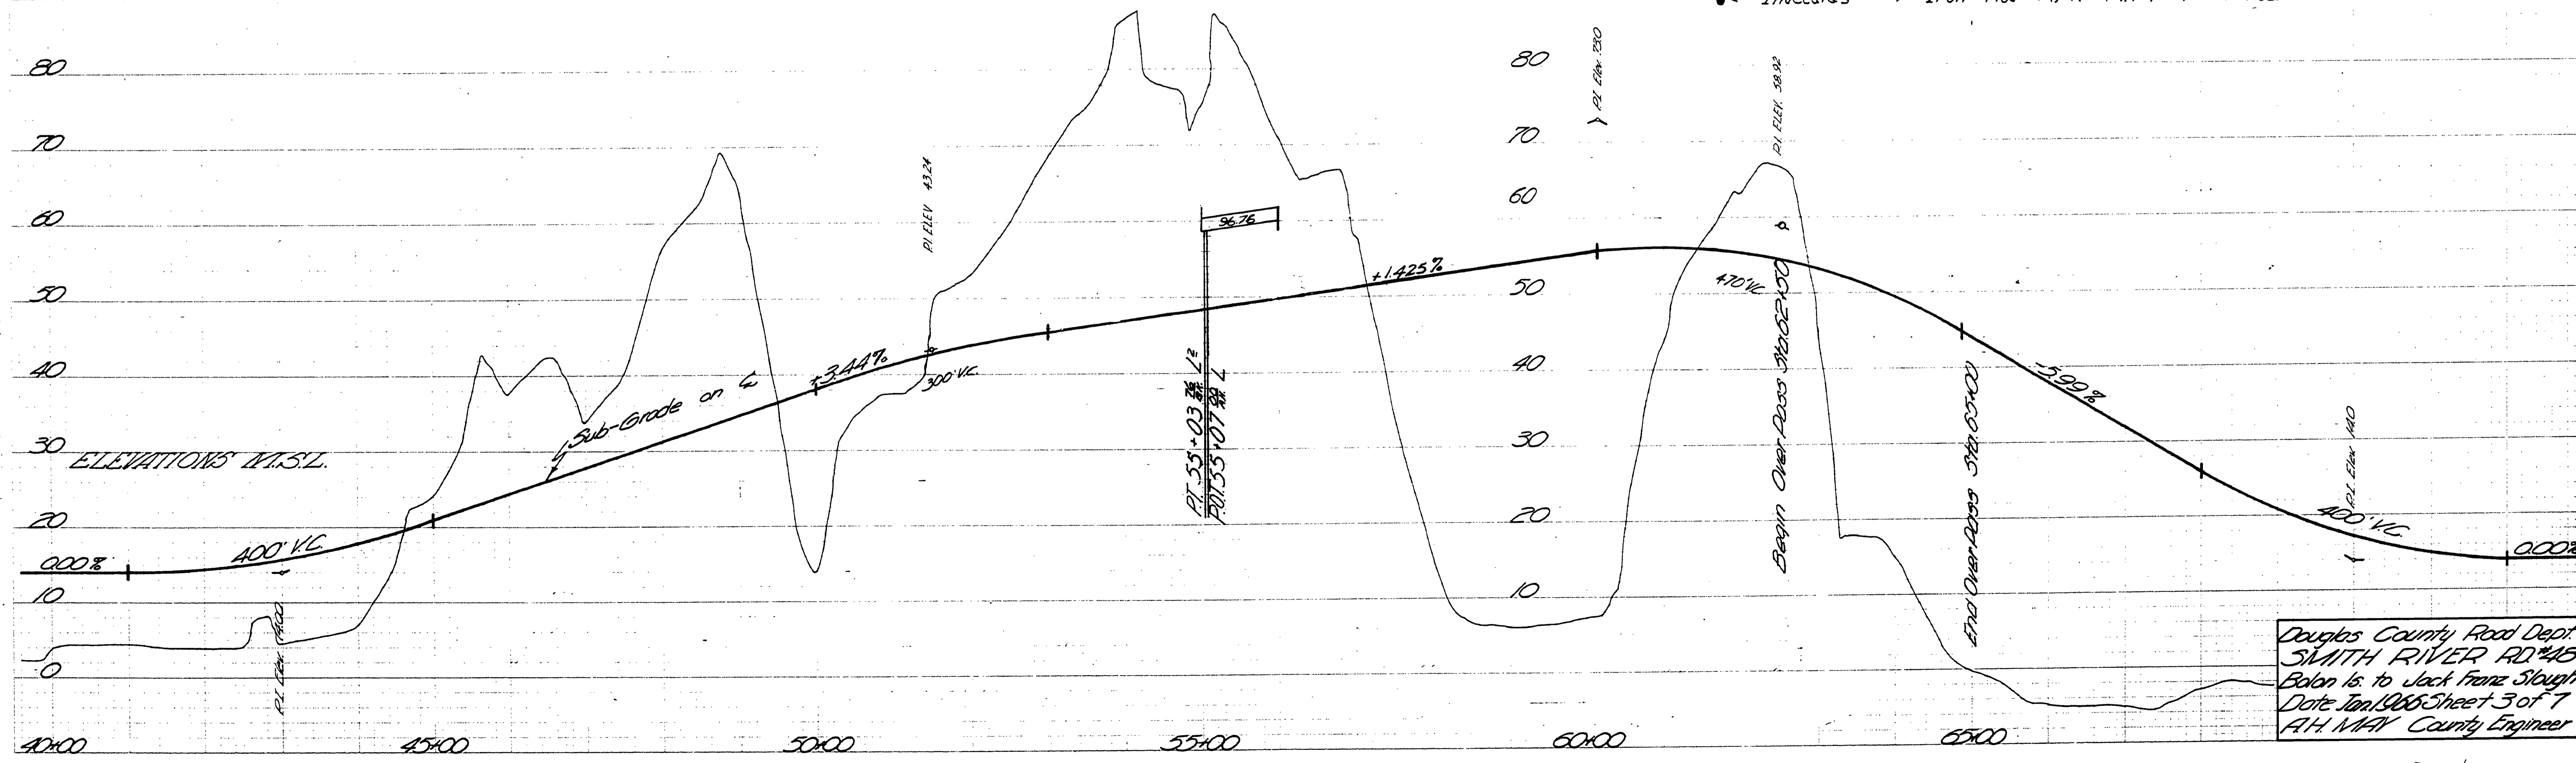


3 copies

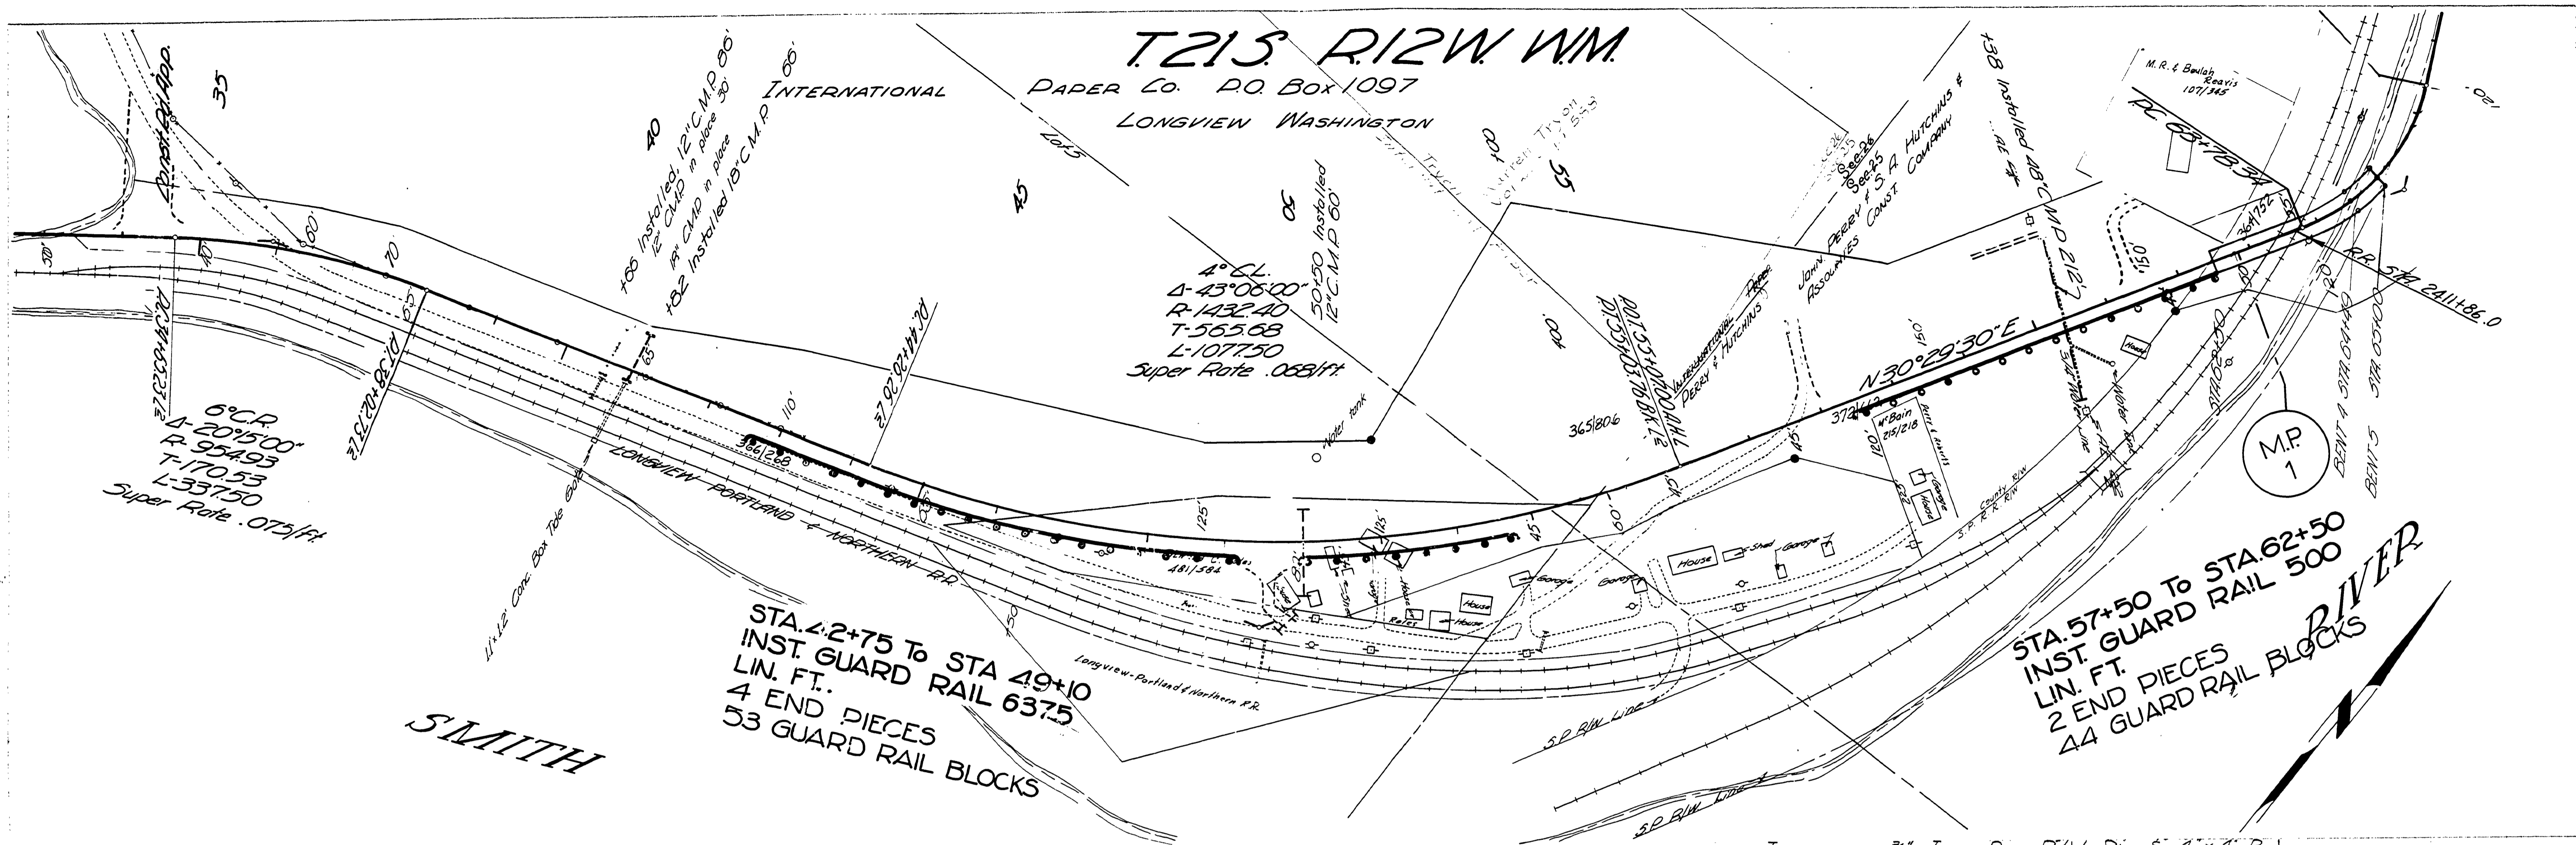

Douglas County Road Dept.  
 SMITH RIVER RD #48  
 Balon Is. to Jack Franz Slough  
 Date Jan. 1966 Sheet 3 of 7  
 A.H. WATY County Engineer

Jun '66  
 G. Rd # 48 sht 3 of 7

M.P. 0.57 - 1.03

00570103

117