
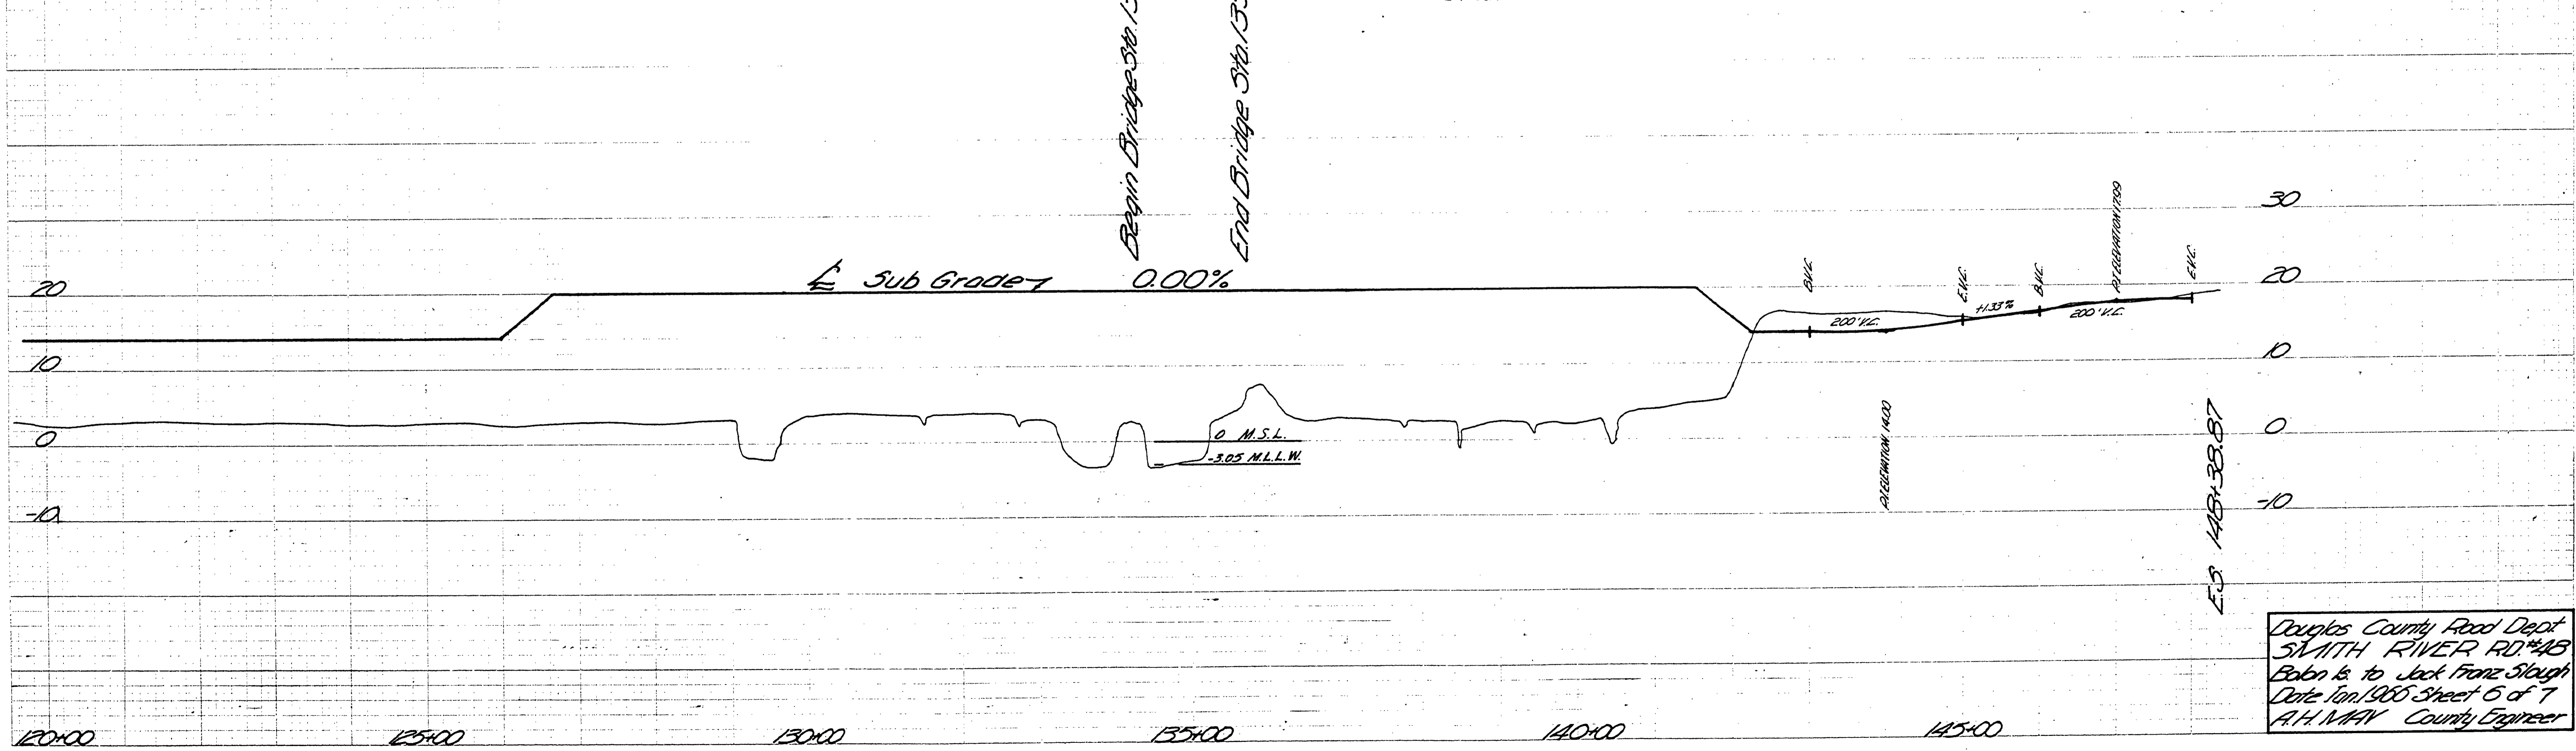


FINAL SURVEY
 DATE
 BY
 CHECKED
 APPROVED

ORIGINAL SURVEY
 DATE
 BY
 CHECKED
 APPROVED

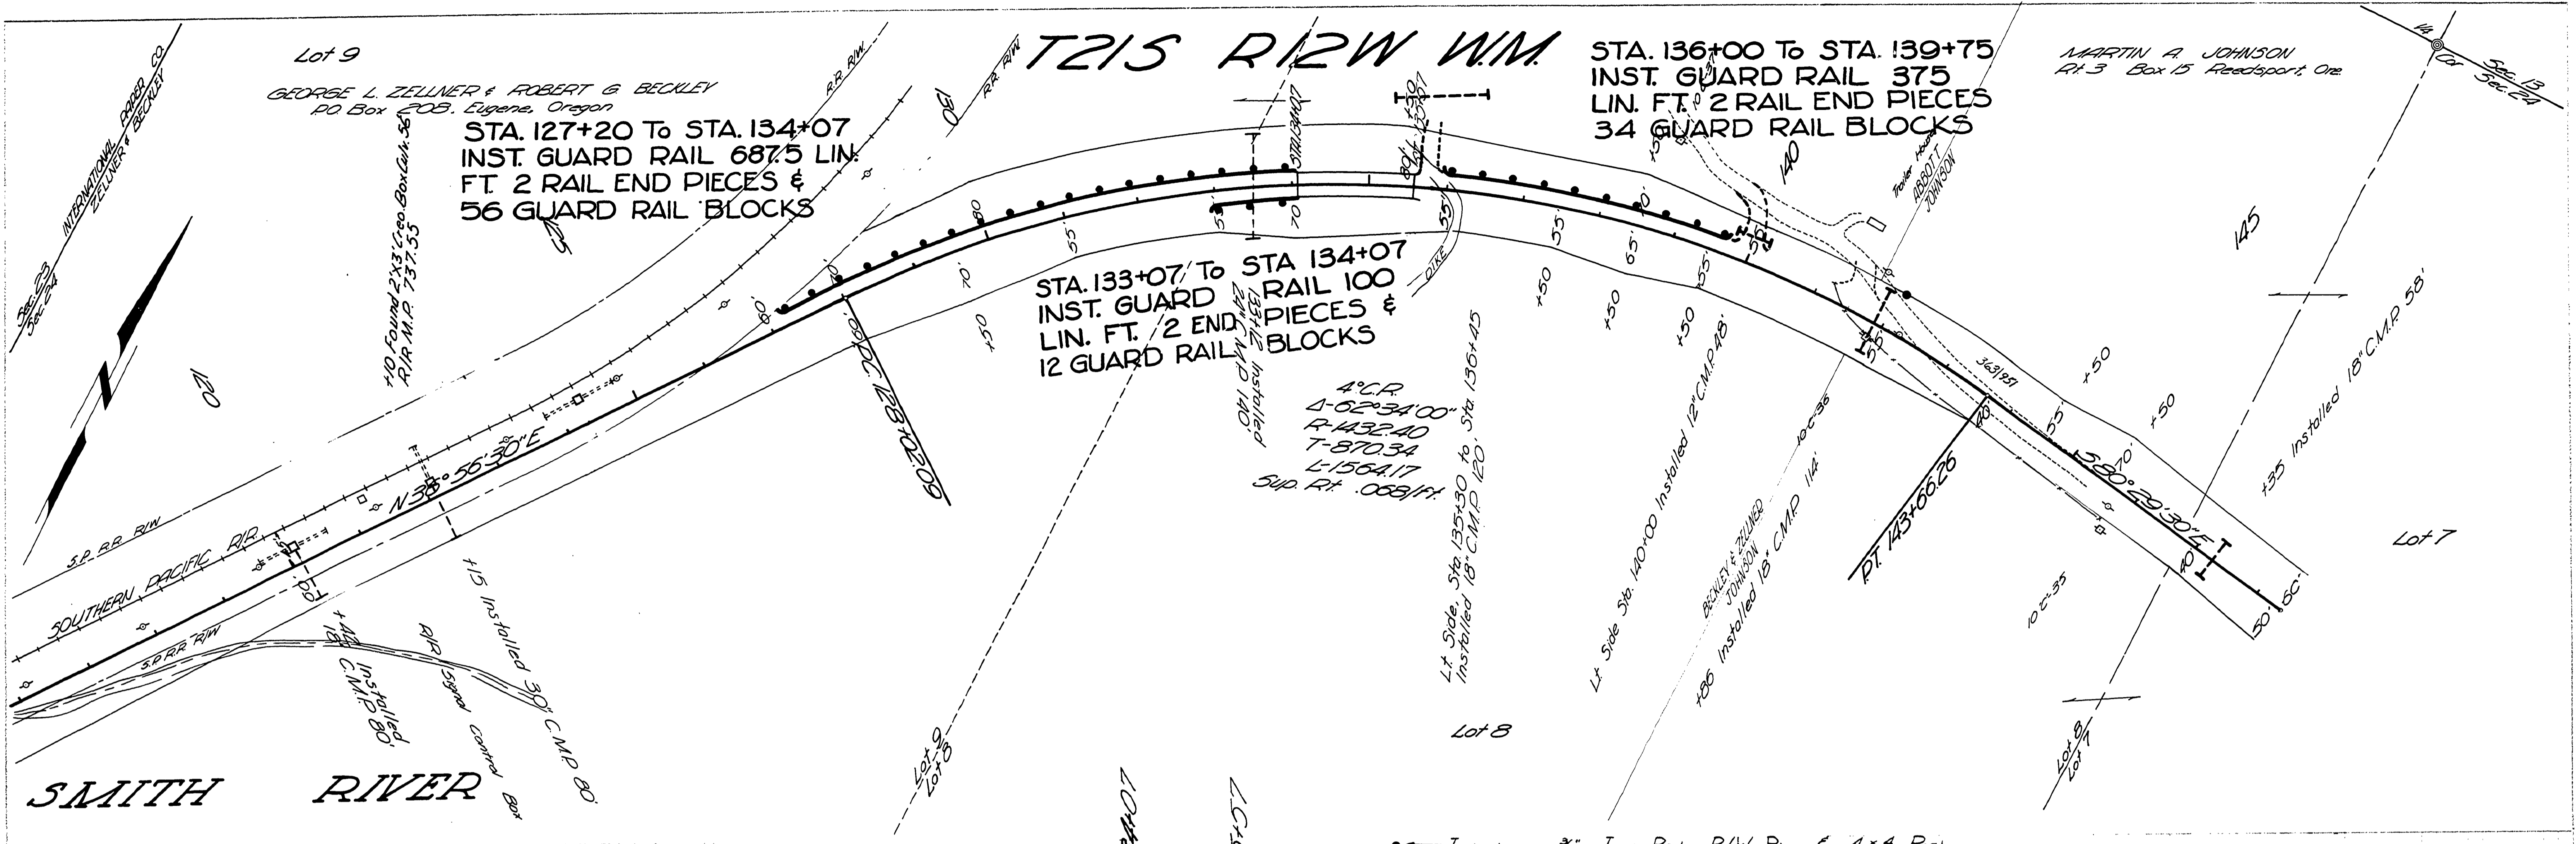

Douglas County Road Dept
 SMITH RIVER RD #48
 Babo Is. to Jack Franz Slough
 Date Jan 1985 Sheet 6 of 7
 A.H. MANN County Engineer

02090256