
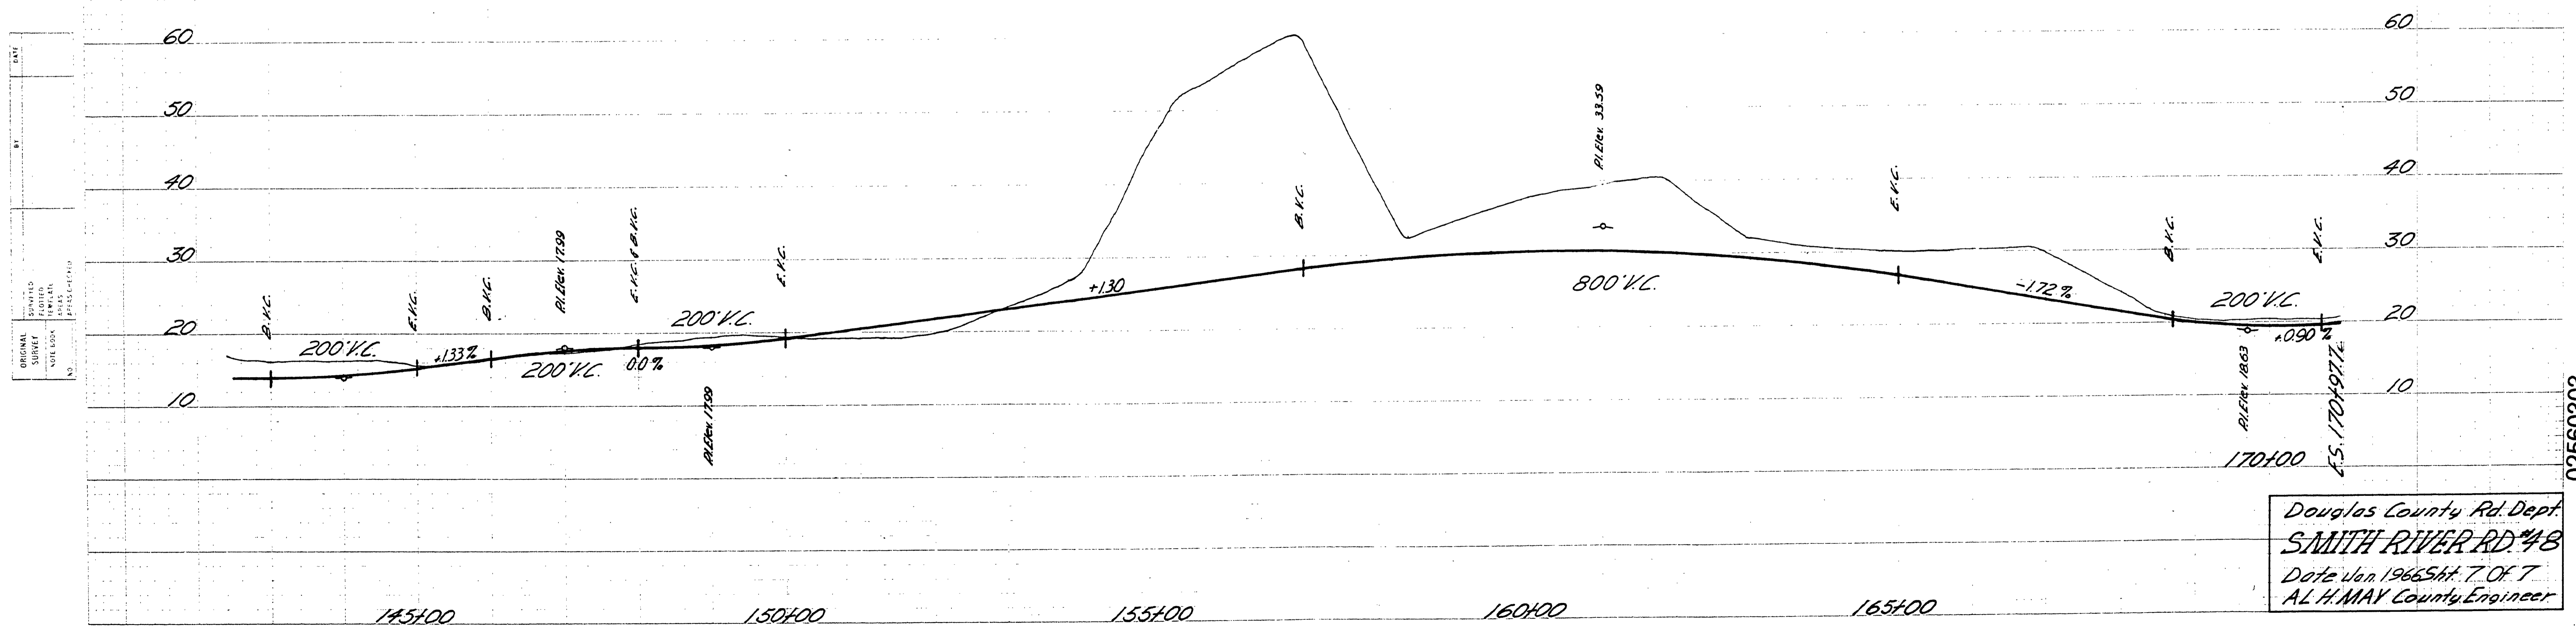


SEC. 24, T. 21 S. R. 12 W. W.M.

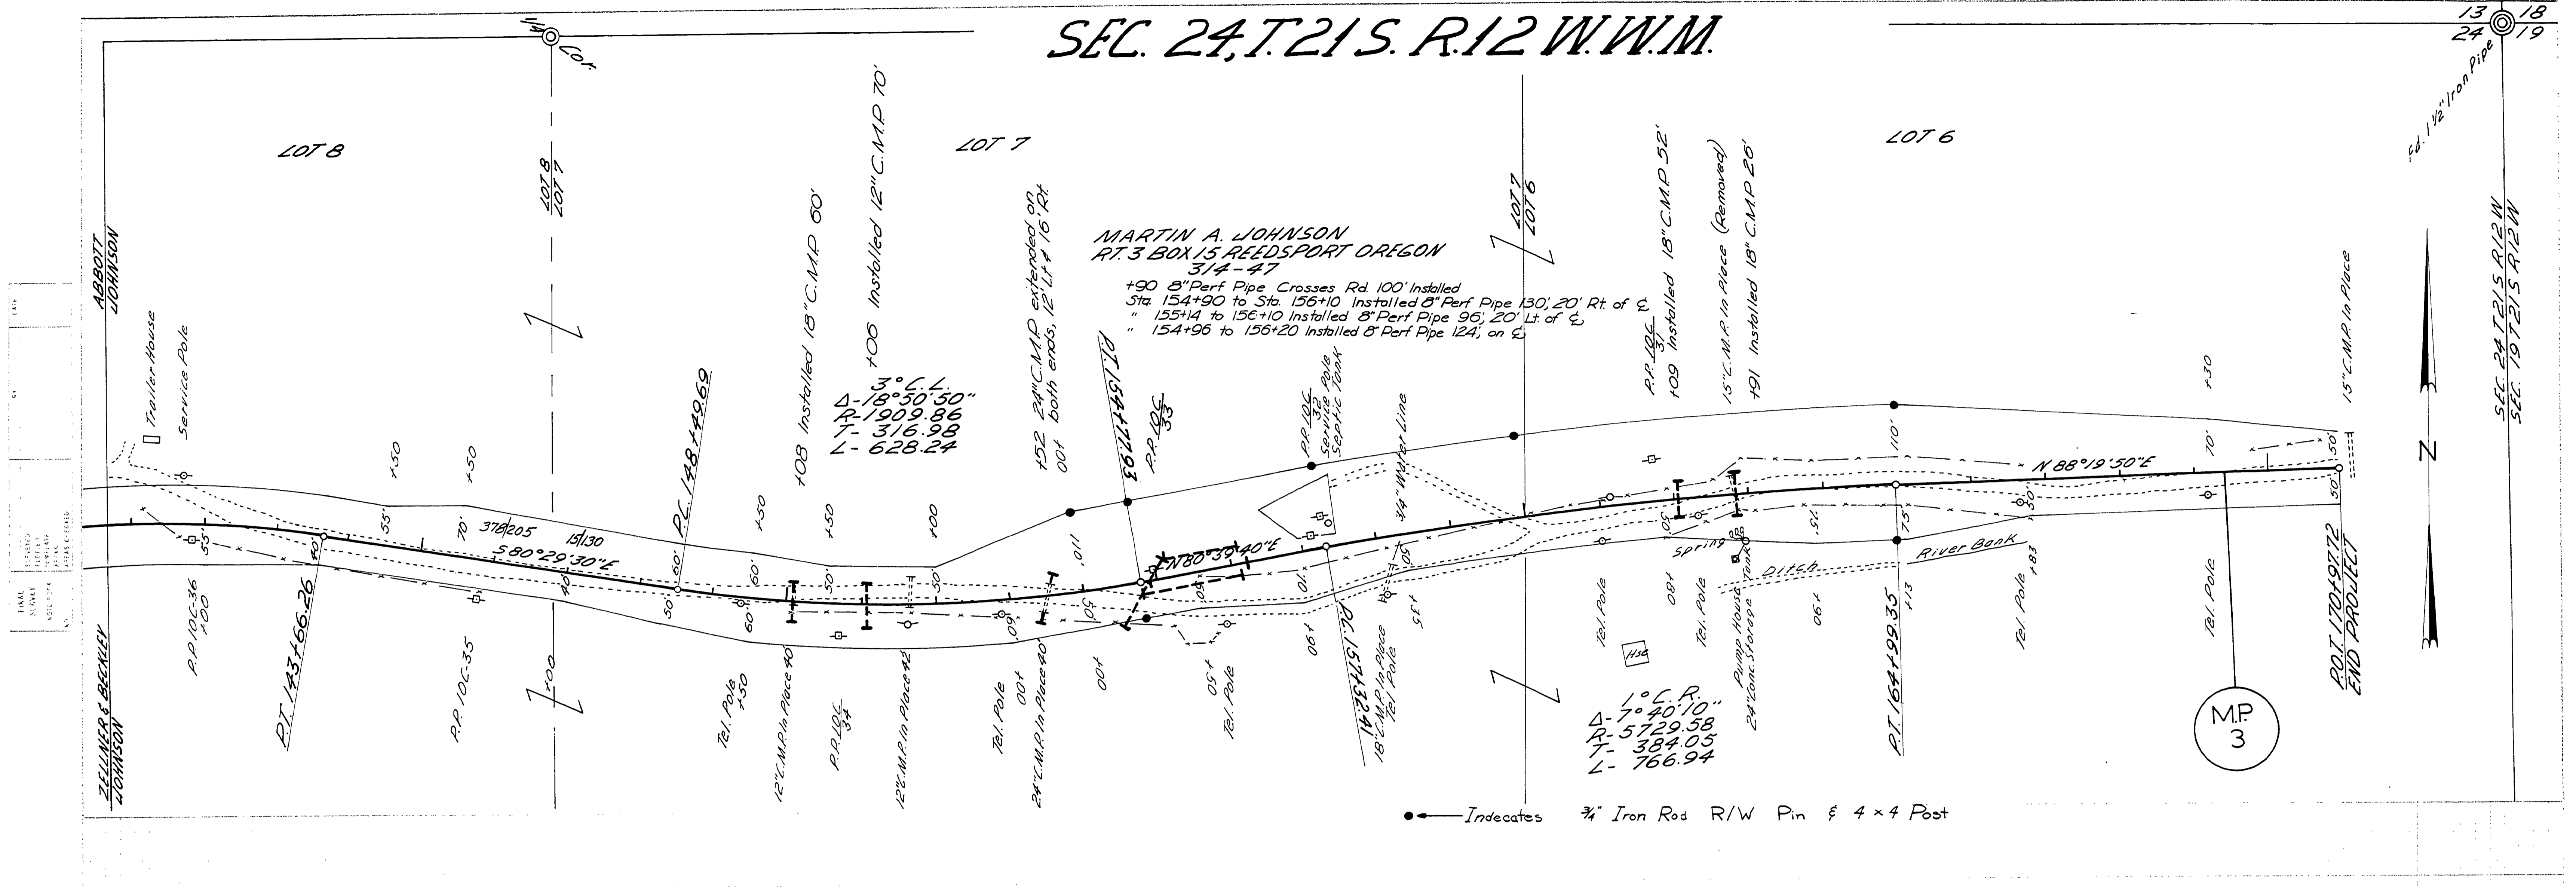

Douglas County Rd. Dept.
SMITH RIVER RD. #48
 Date Jan. 1966 Sh. 7 OF 7
 AL H. MAY County Engineer

02560303