

NW 1/4 of SW 1/4
William Wade

SE 1/4 of NE 1/4
William Wade

SW 1/4 of NW 1/4
William Wade


NE 1/4 of NE 1/4
William Wade

DOUGLAS COUNTY HIGHWAY IMPROVEMENT LOWER SMITH RIVER ROAD C-48 DAILEY SECTION

SEC 31-32 T20S R10W W.M.
SEC. 4-5-6 T21S R10W W.M.
H. LEPPSTEIN COUNTY SURVEYOR
SURVEYED JULY 1926 SCALE 1"=100'

SECTION 5
SECTION 4

SHEET 2

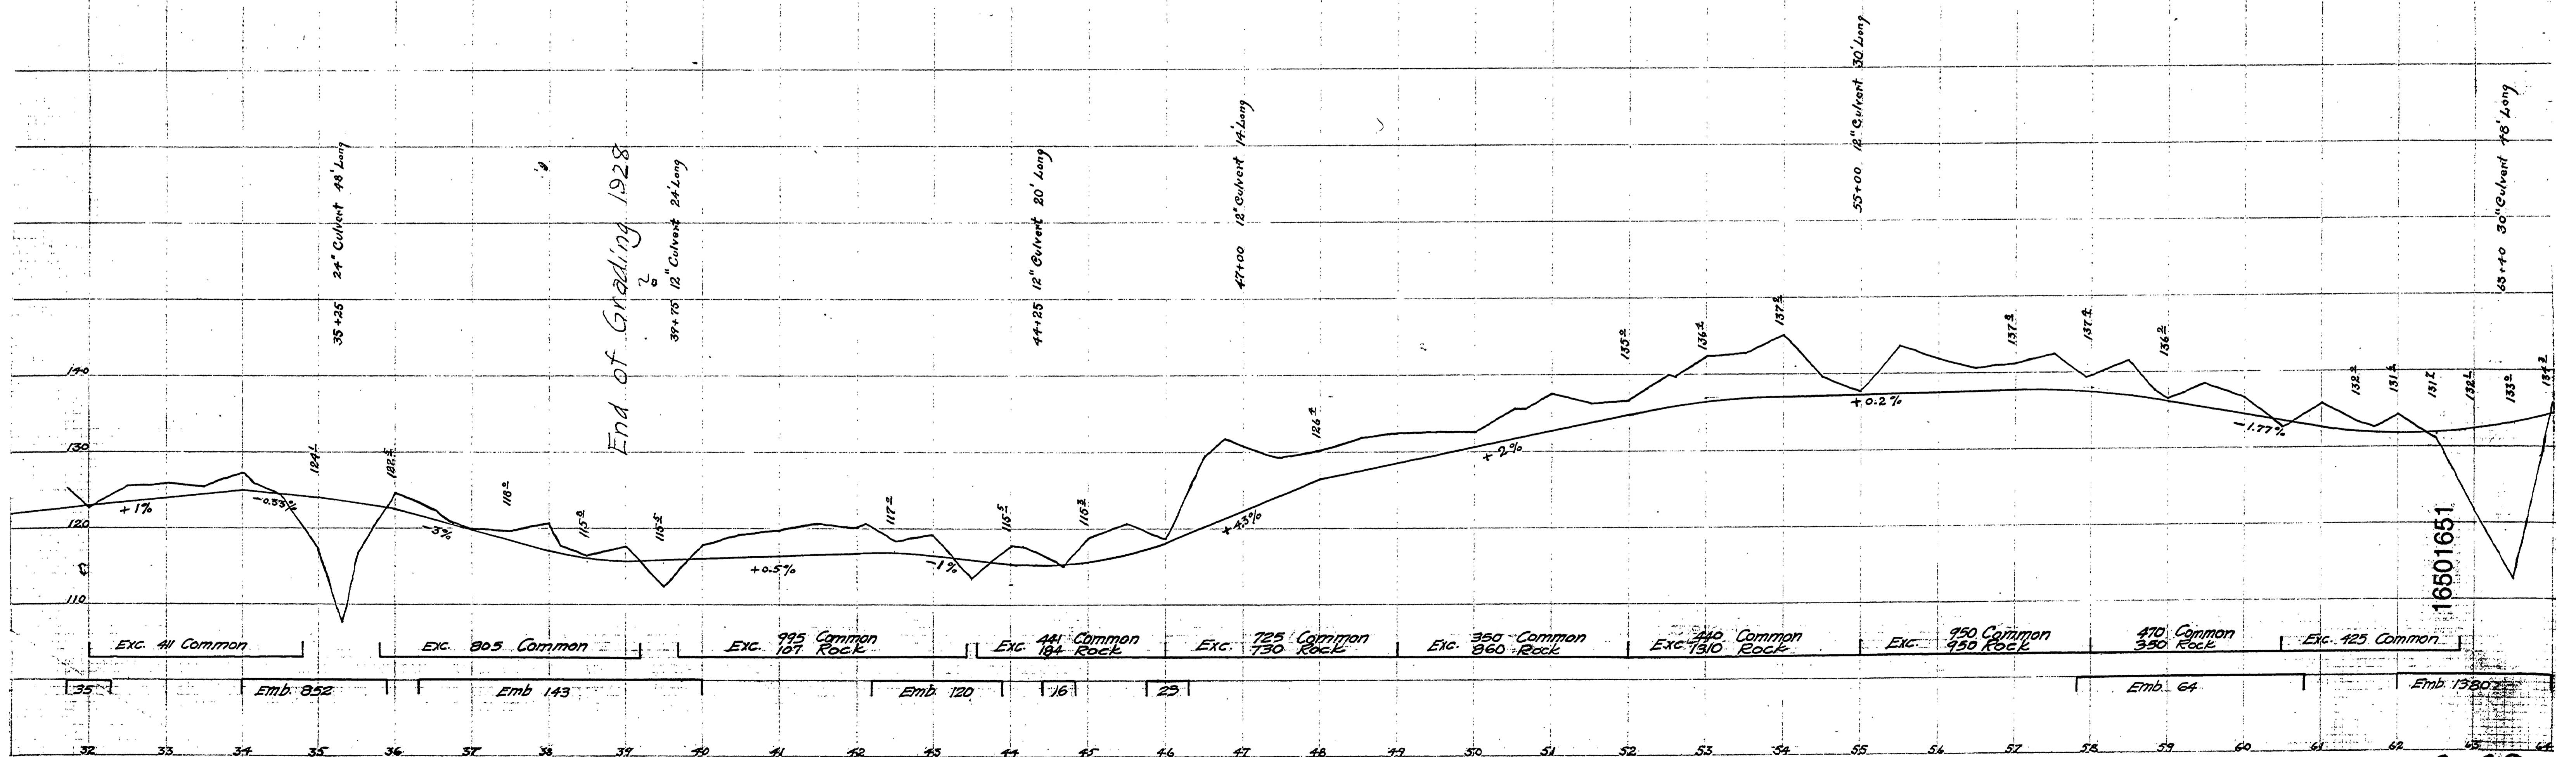

End of Grading 1928

C-48

N.M.P. 16.5

T20-10 S. 31732
T21-10 S. 41586 JULY 1926 SHEET 2 OF 10