

DOUGLAS COUNTY OREGON

AS CONSTRUCTED

Grading & Surfacing

MELROSE - ROSEBURG - UMPQUA
COUNTY ROAD NO. 13




MELROSE - FLOURNOY VALLEY
COUNTY ROAD NO. 51

ROAD NO. 51

Adopted by Resolution of
The County Court this 13
day of March 1963

V. T. Johnson
JUDGE
Commissioner
COMMISSIONER
Commissioner
COMMISSIONER

approved Al. H. May Date 4/9/63
COUNTY ENGINEER

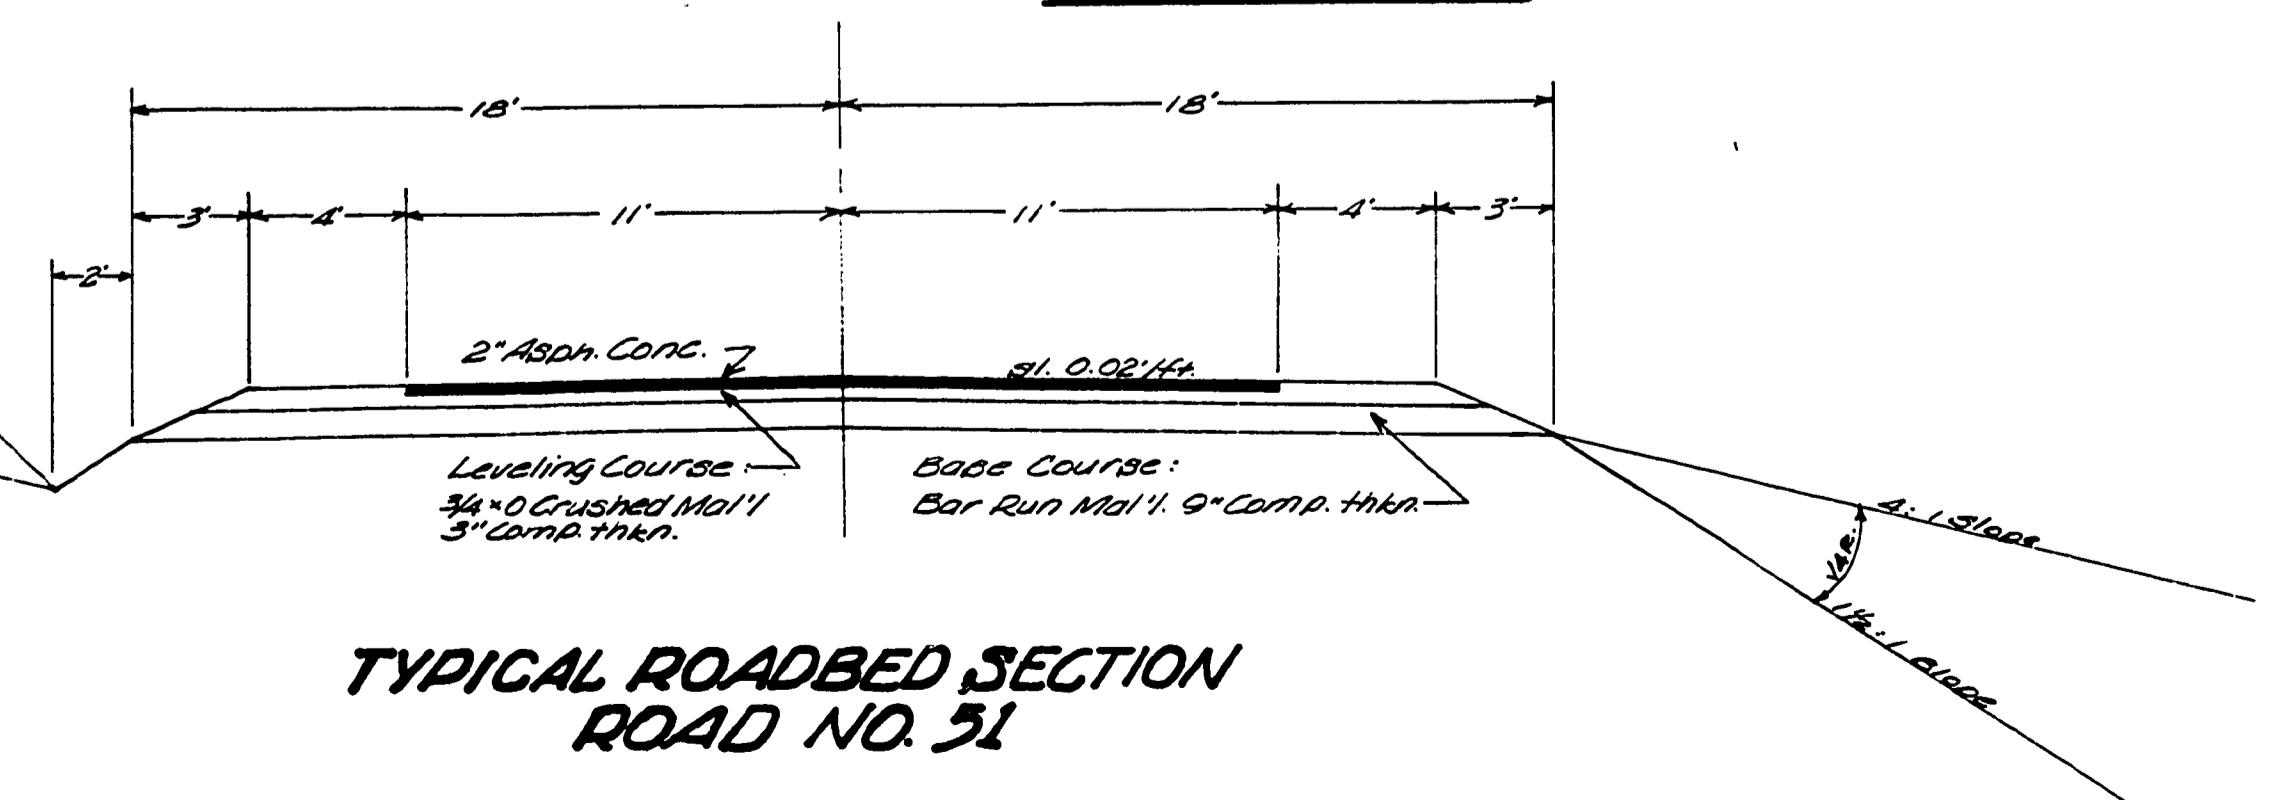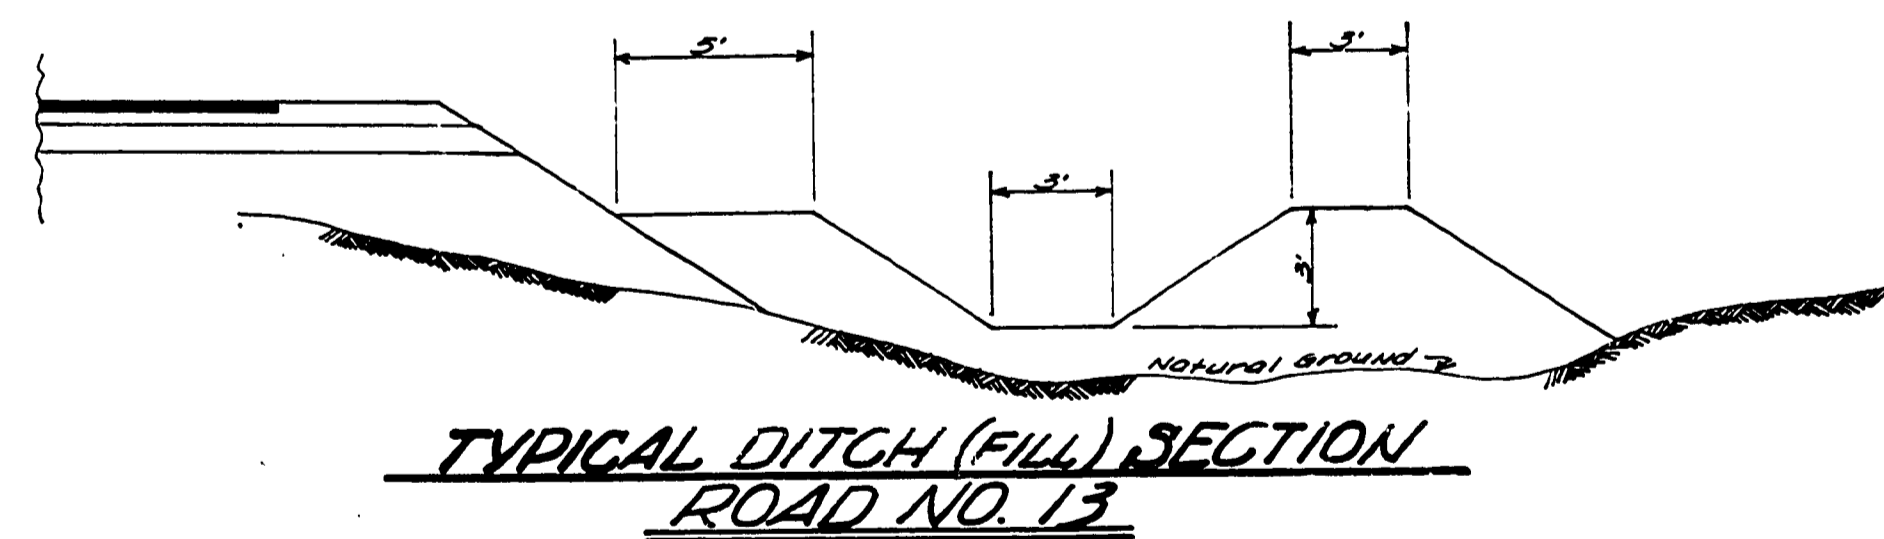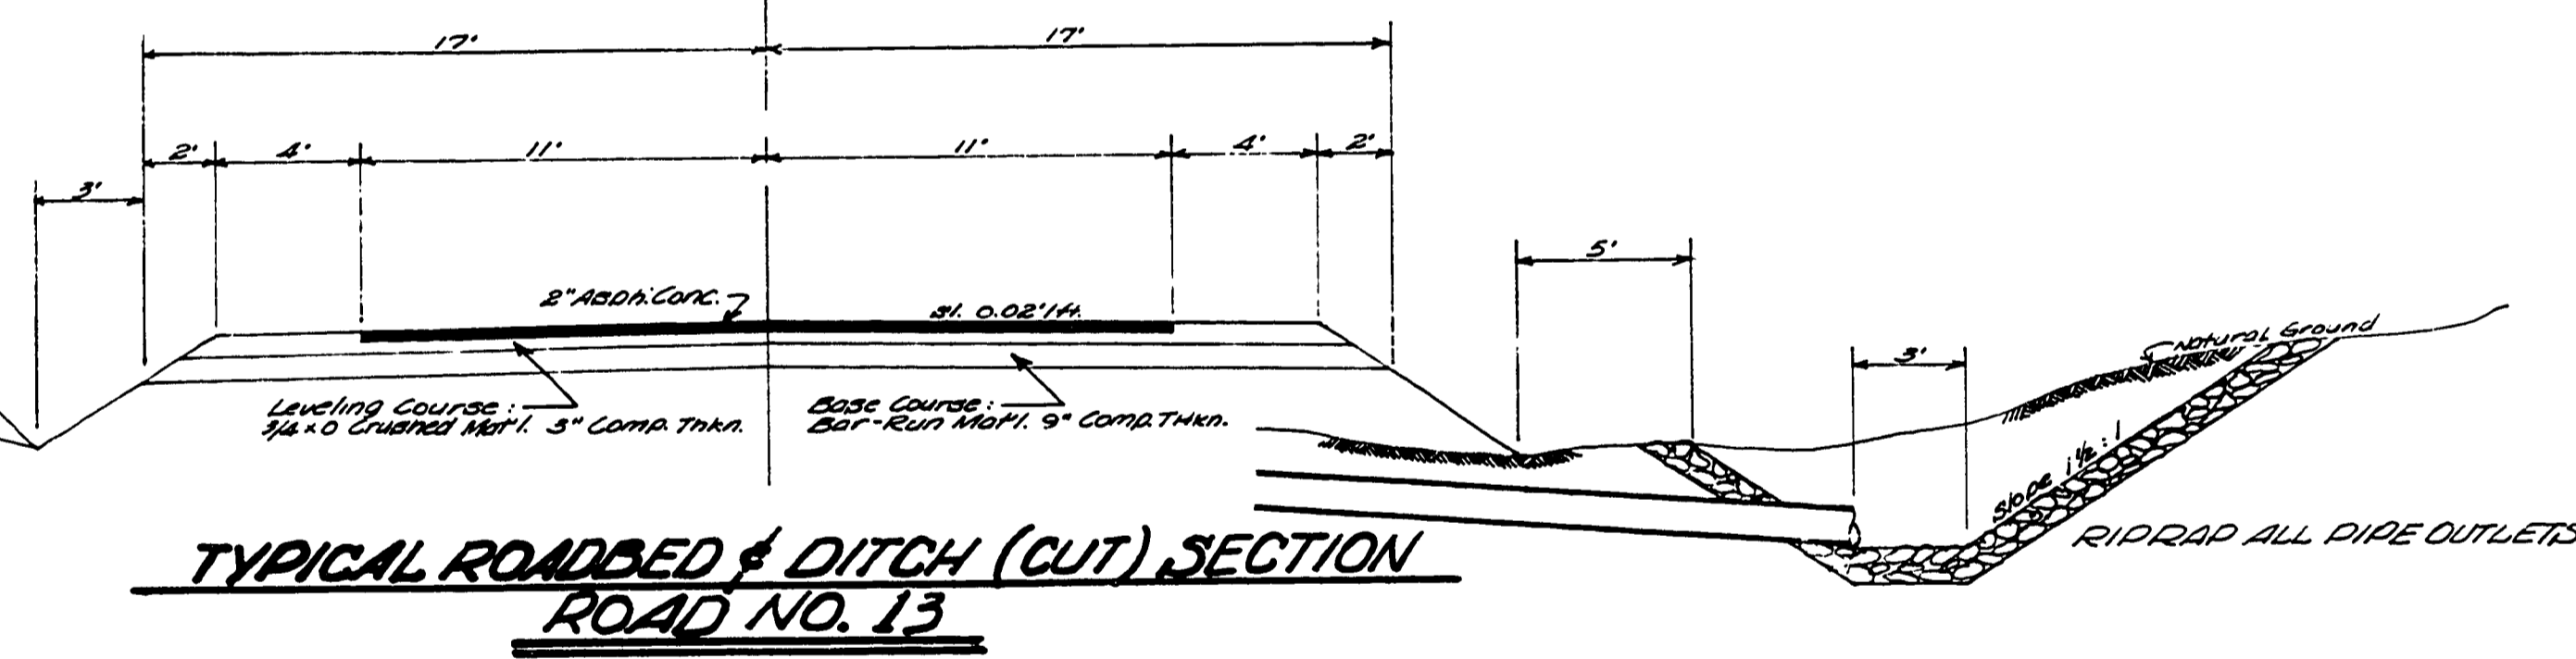

0016007C