

T26S

DOUGLAS COUNTY, OREGON


PLANS FOR PROPOSED PROJECT

GRADING & SURFACING

LOOKINGGLASS-MELROSE ROAD NO. 52

MILE POINT 0.00 TO MILE POINT 4.74

JUNE 1970

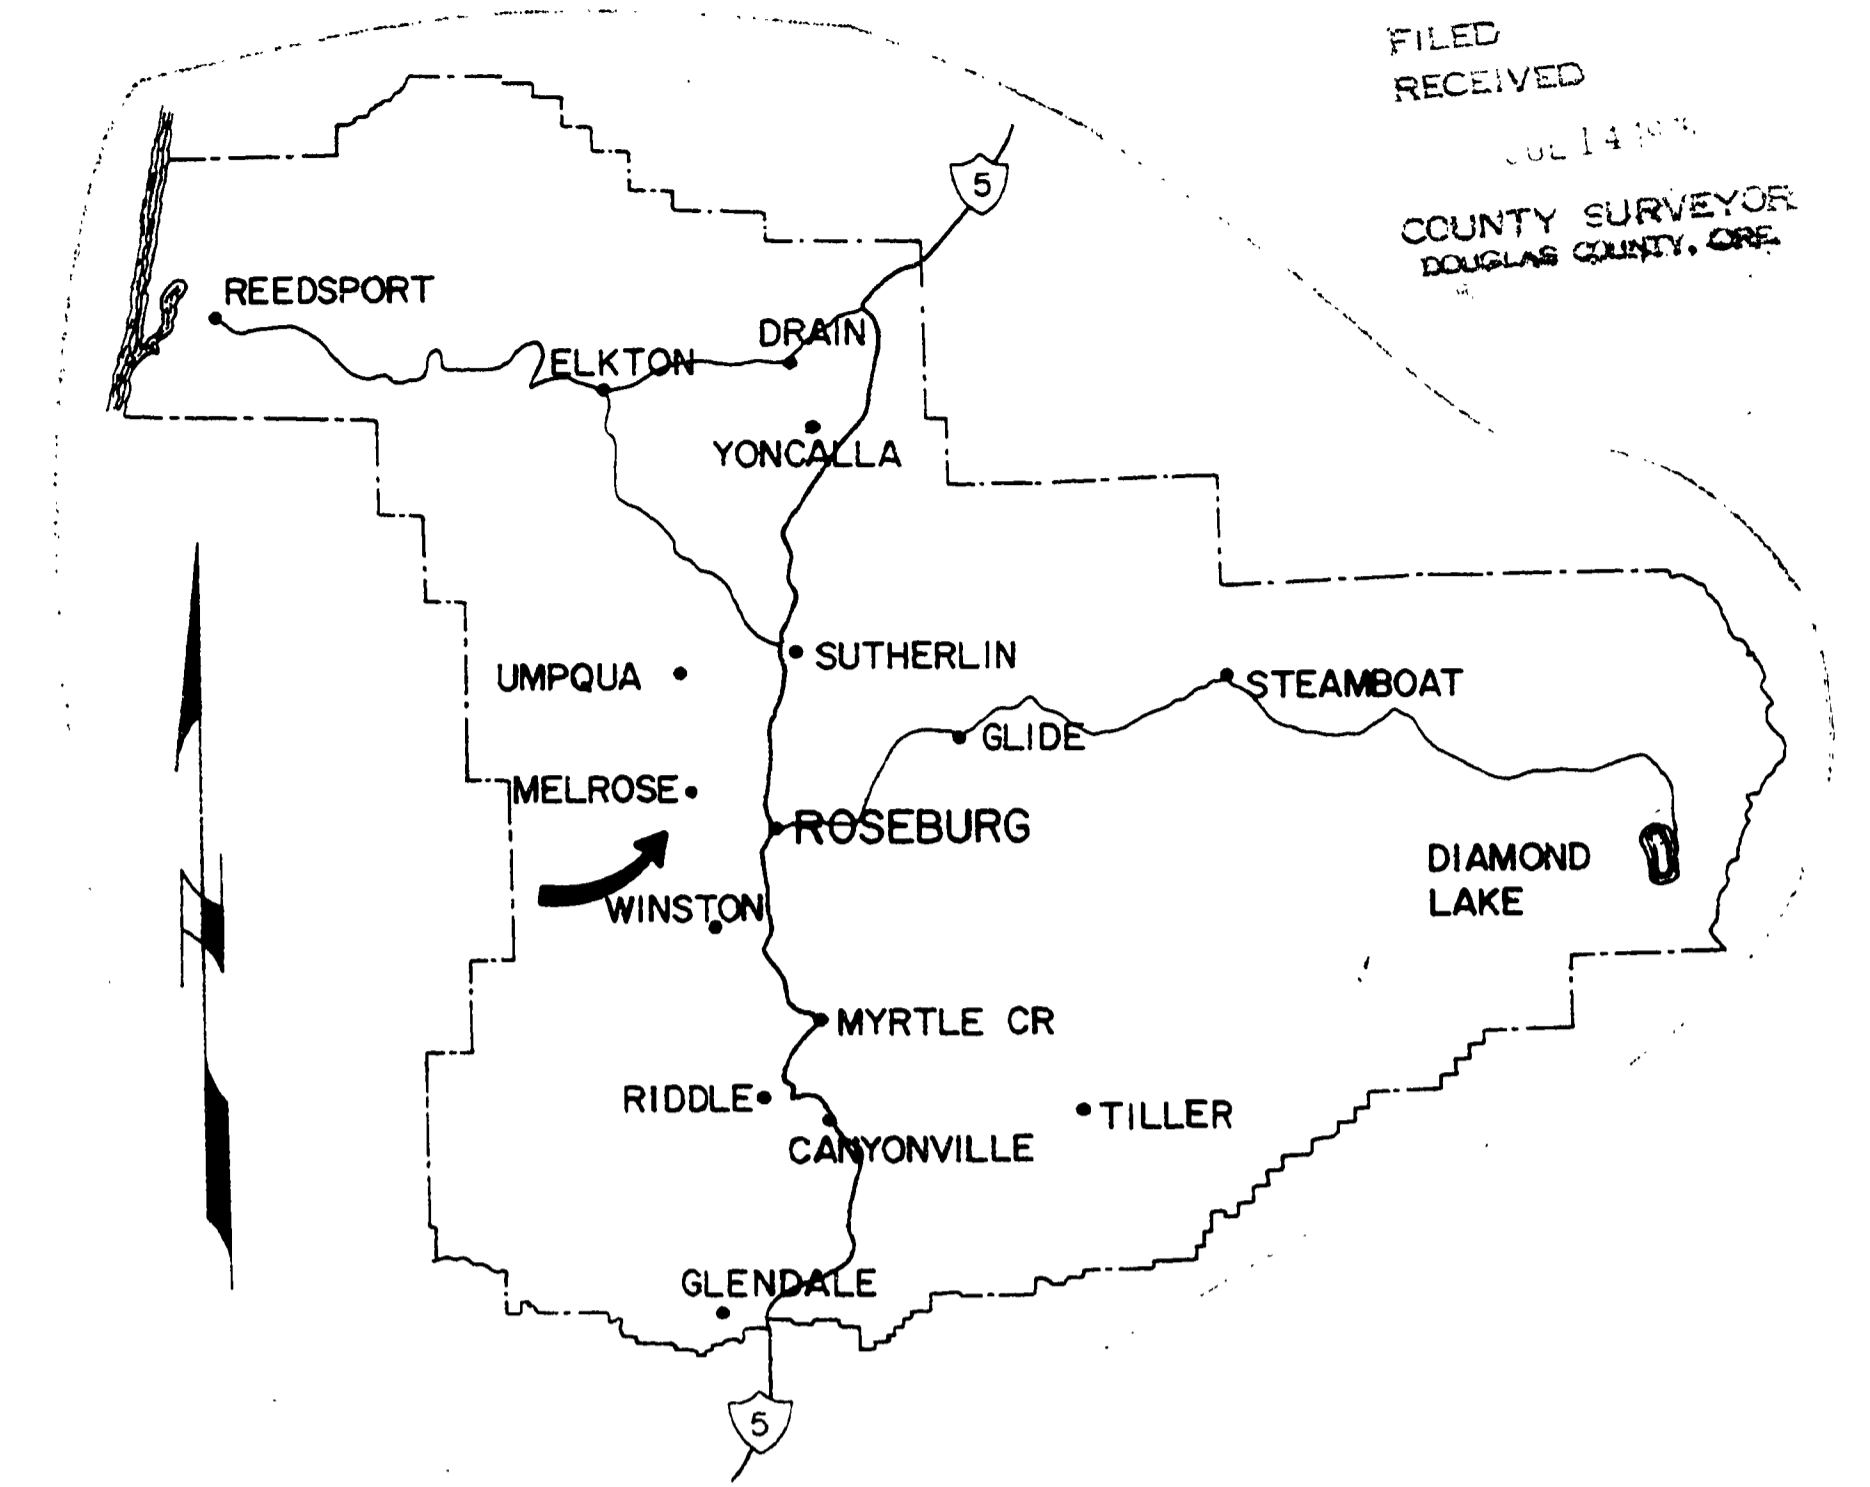

T27S

R7W

RD 47


R6W

R5W

LOOKINGGLASS-MELROSE ROAD
LENGTH OF PROJECT 4.74 MILES

END PROJECT
STA. 259+10.00

BEGIN PROJECT
STA. 23+14.74

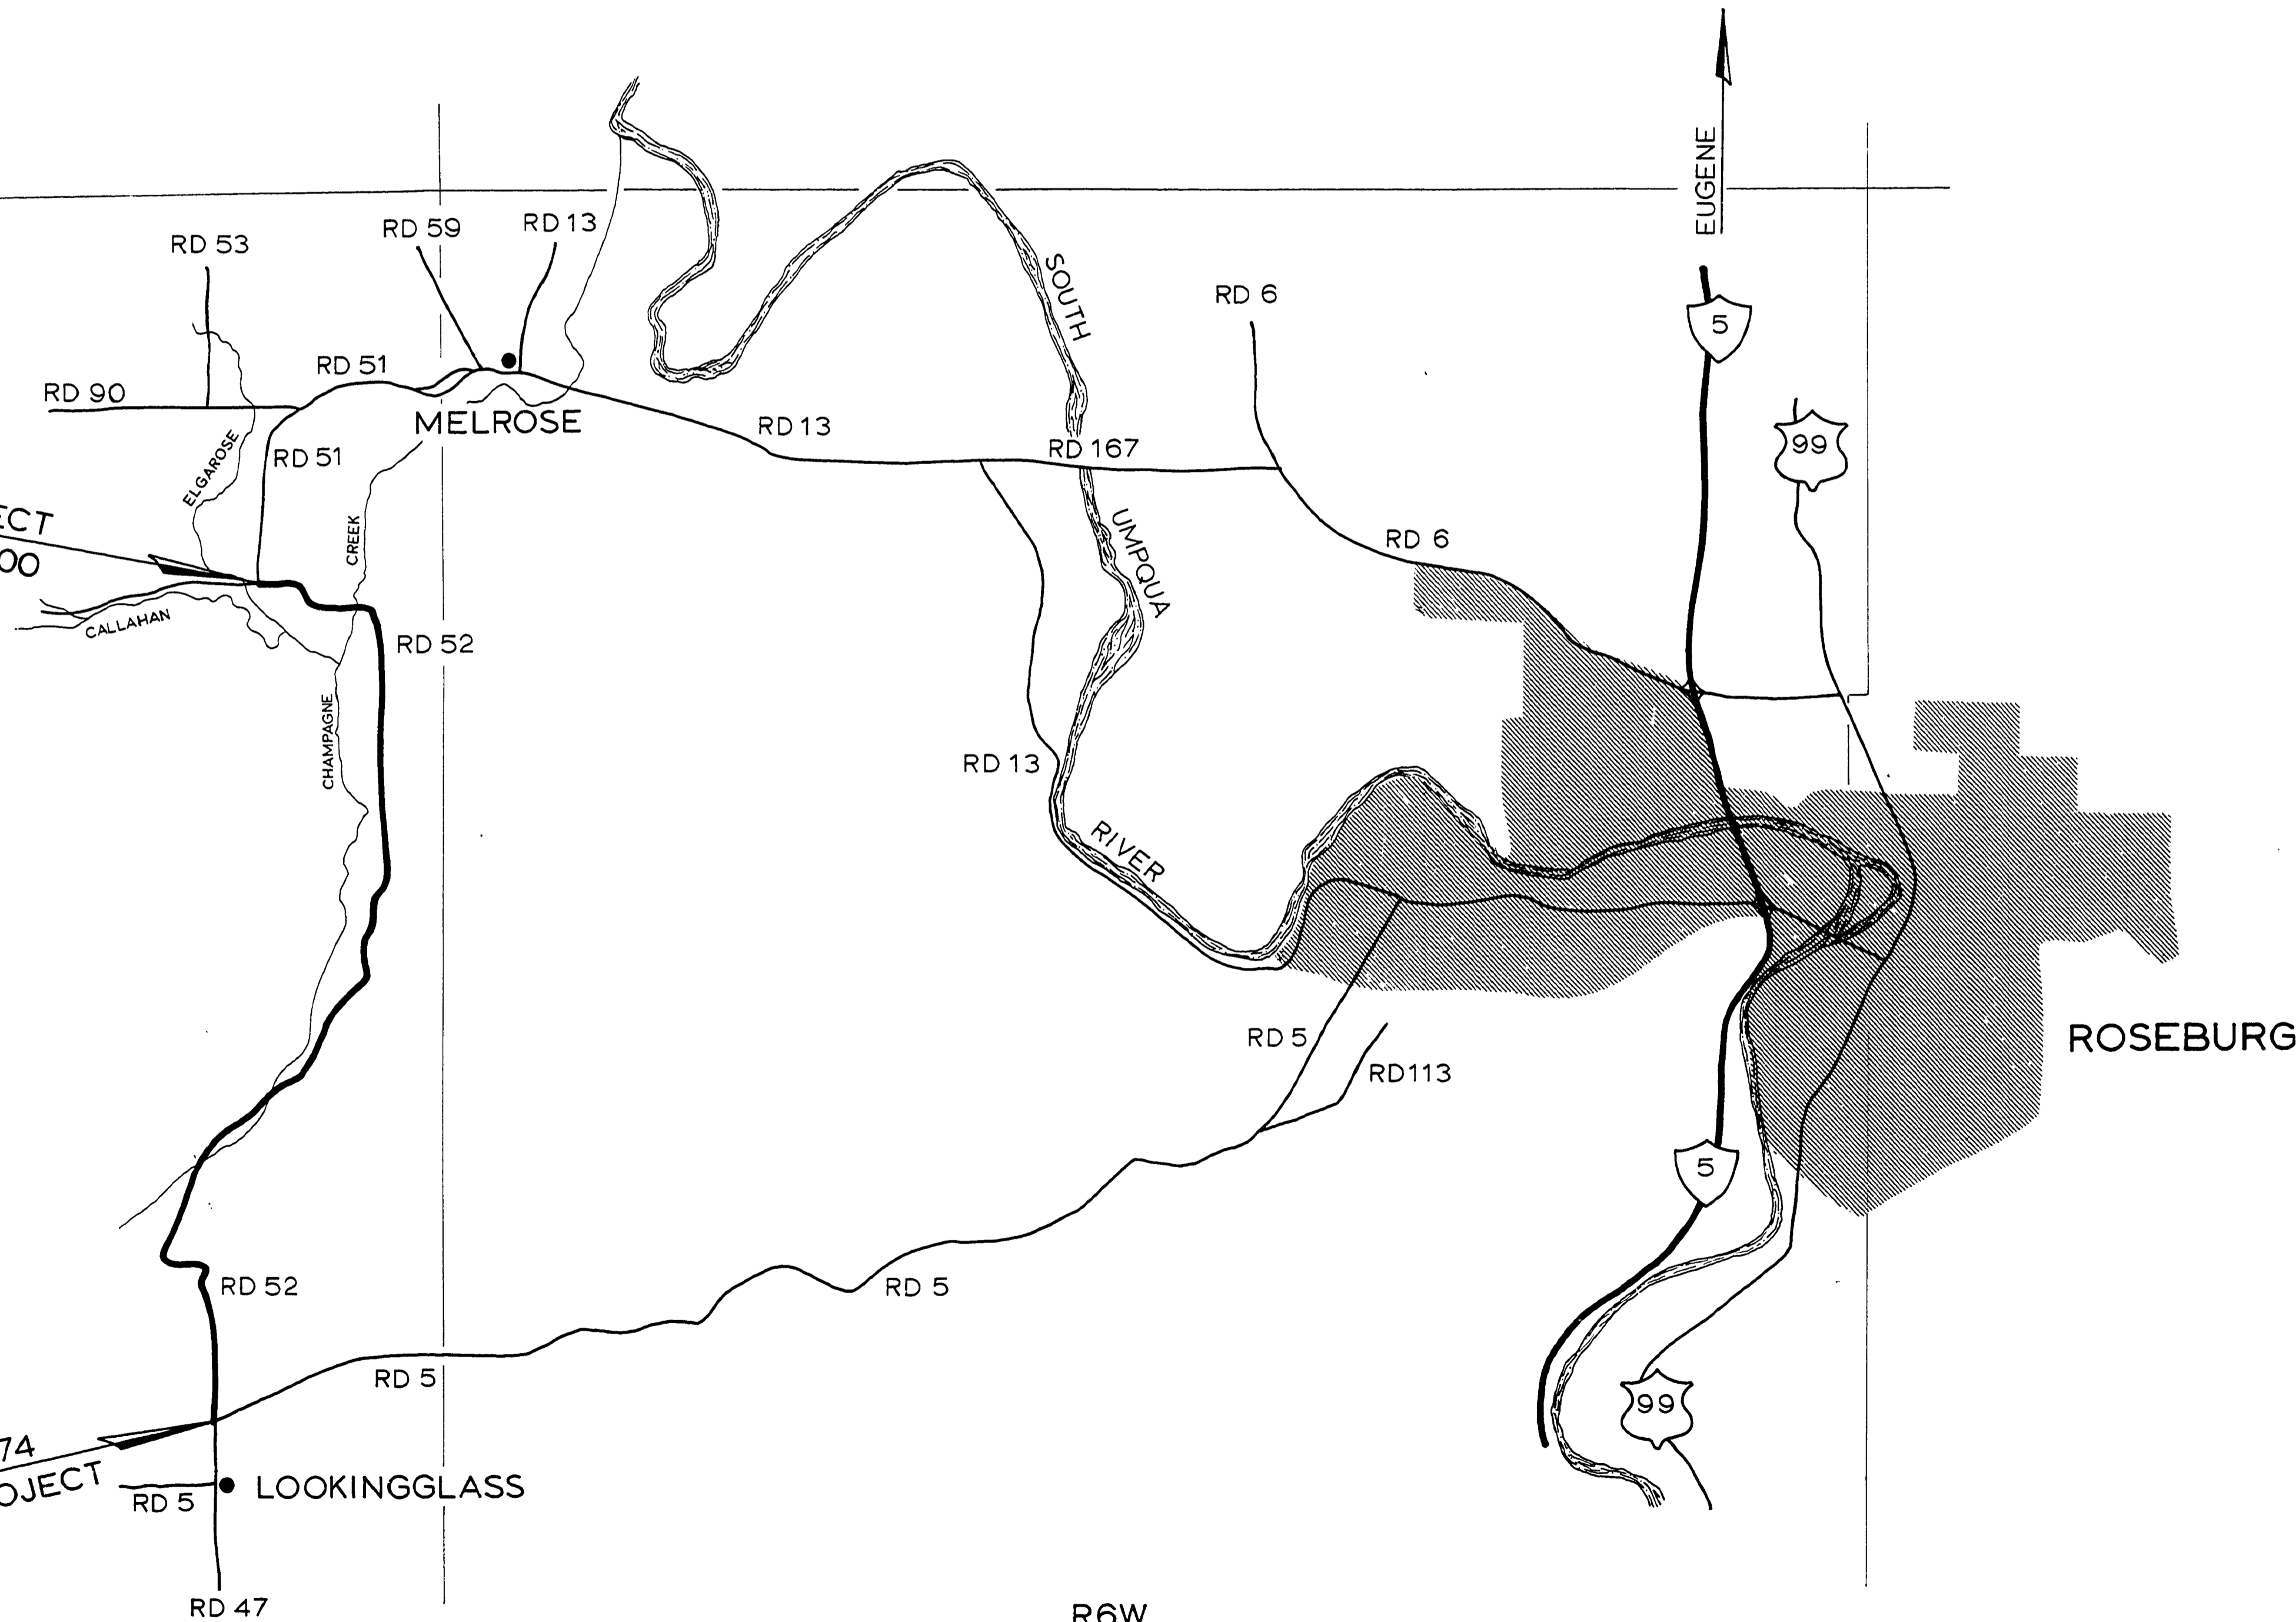

INDEX OF DRAWINGS

SHEET NUMBER	TITLE
1	TITLE SHEET
2	QUANTITY SUMMARY
3	TYPICAL SECTIONS
4 & 5	PIPE LIST
6 THRU 14	ROAD PLANS

STANDARD DRAWINGS
9

TOTAL OF 15 SHEETS



NOT REVISED
AS CONSTRUCTED

DOUGLAS COUNTY ROAD DEPT.
LOOKINGGLASS-MELROSE RD.# 52
DATE: JUNE 1970 SHT 1
GEORGE E. GRUBB COUNTY ENG.

0000045C