


**DOUGLAS COUNTY HIGHWAY
IMPROVEMENT
PROFILE AND ALIGNMENT
CRITESER ROAD
SHEET No 2
SECTIONS 12 & 13, TWP. 27 S., RANGE 7 W.W.M.
STA. 0+00 TO STA. 52+86.7
OFFICE OF
F. C. FREAR
COUNTY ROADMASTER
AUGUST 1922
SCALE: Hor. 1 in. = 100 ft. VERTICAL 1 in. = 10 ft.**

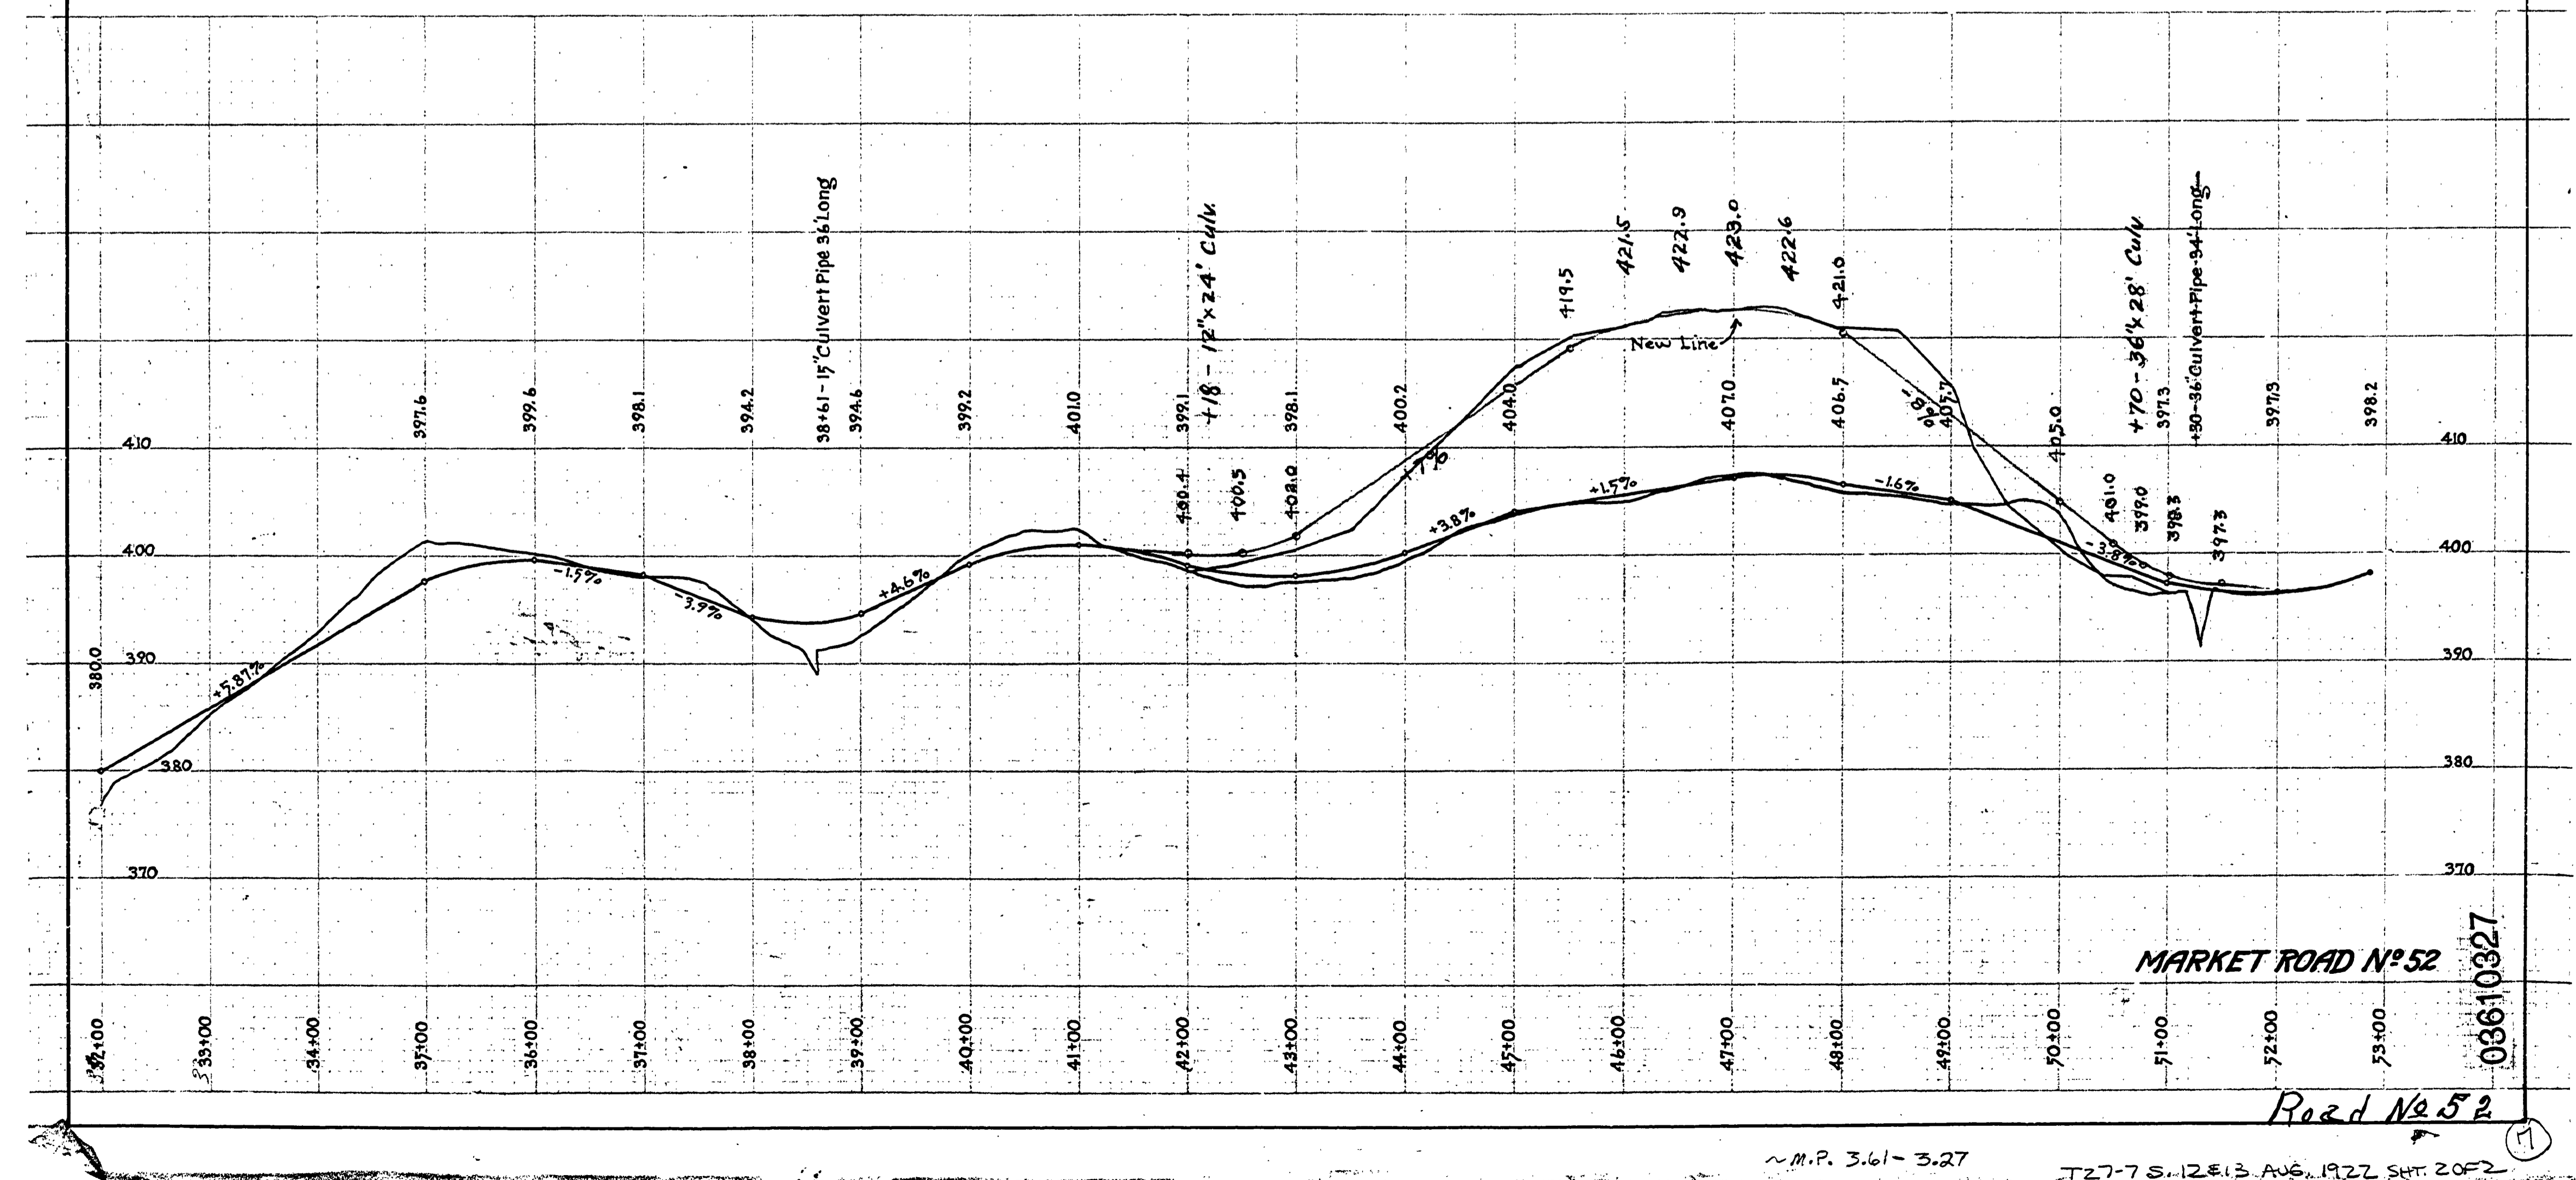

MARKET ROAD No 52

Road No 52

03610327