



TYPICAL SECTIONS RD. 53

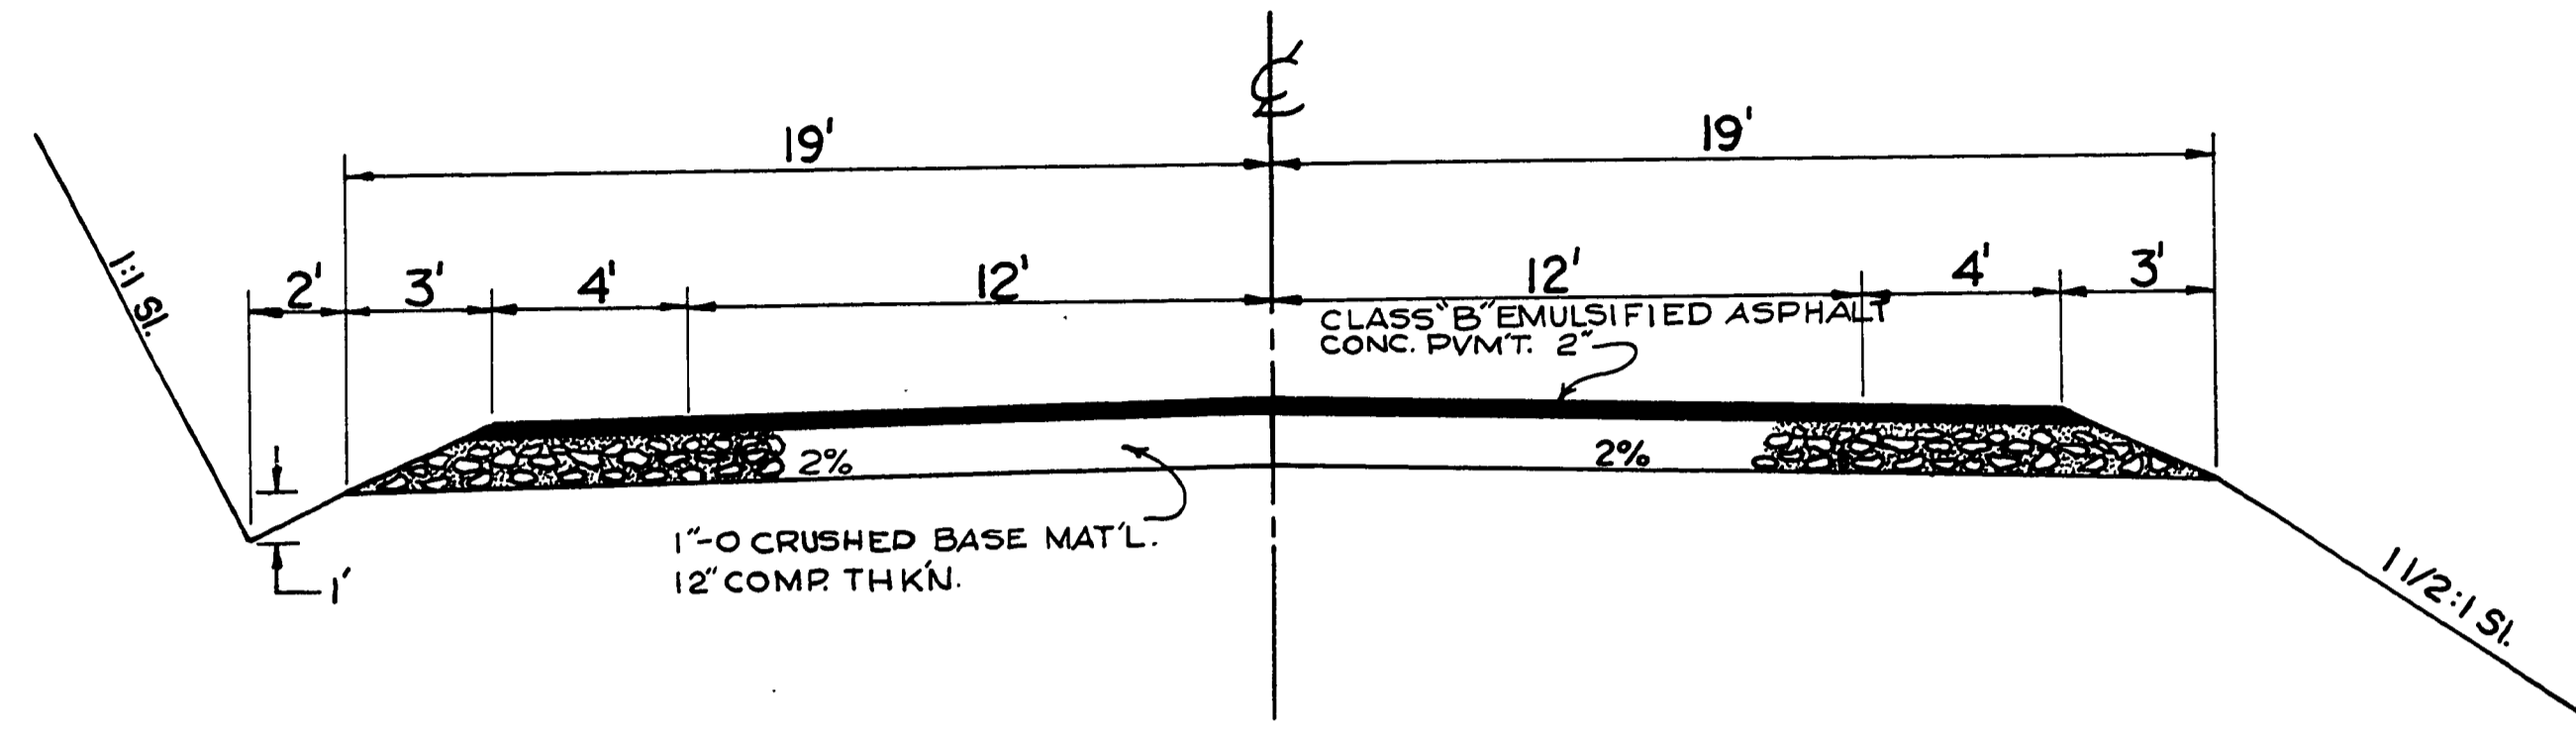


TYPICAL ROADBED SECTION

NOTE:

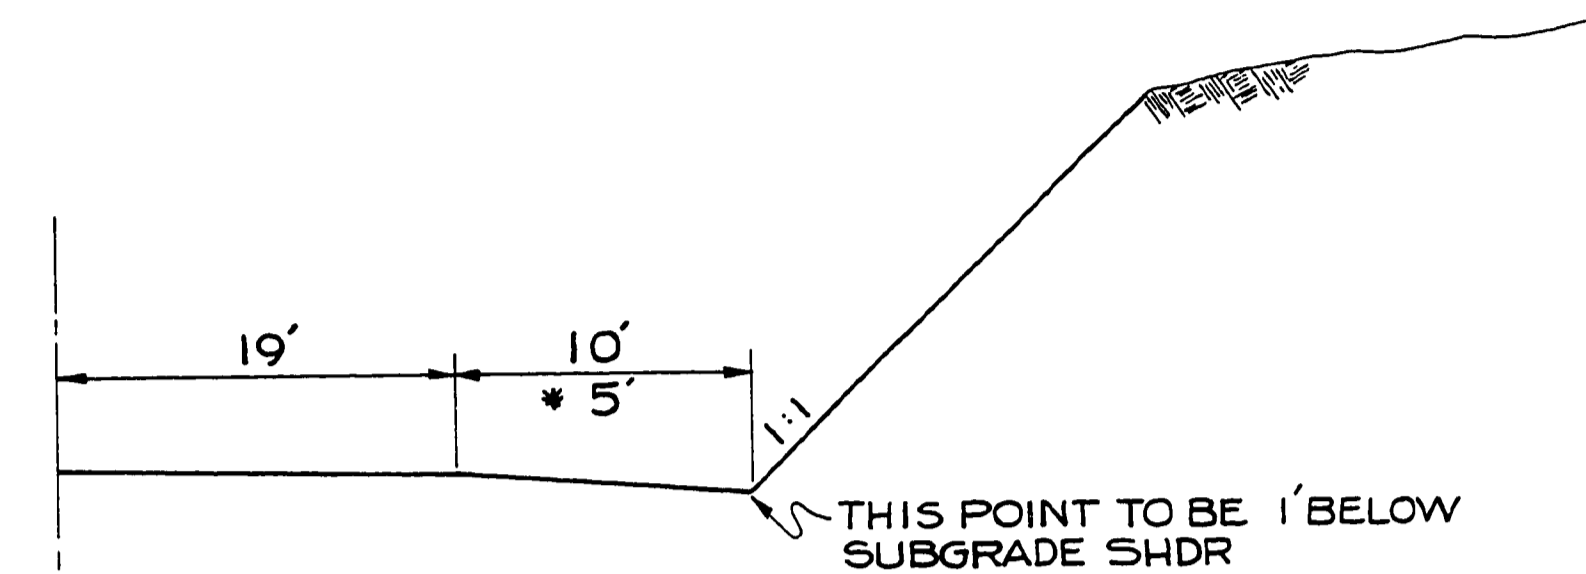


FALLOUT AREA

- STA 117+50 - 118+50 TAPER SECTION
- 118+50 - 126+50 10' WIDE
- 126+50 - 127+00 TAPER FROM 10' TO 5'
- 127+00 - 129+50 5' BOTTOM WIDTH
- 129+50 - 130+00 TAPER SECTION

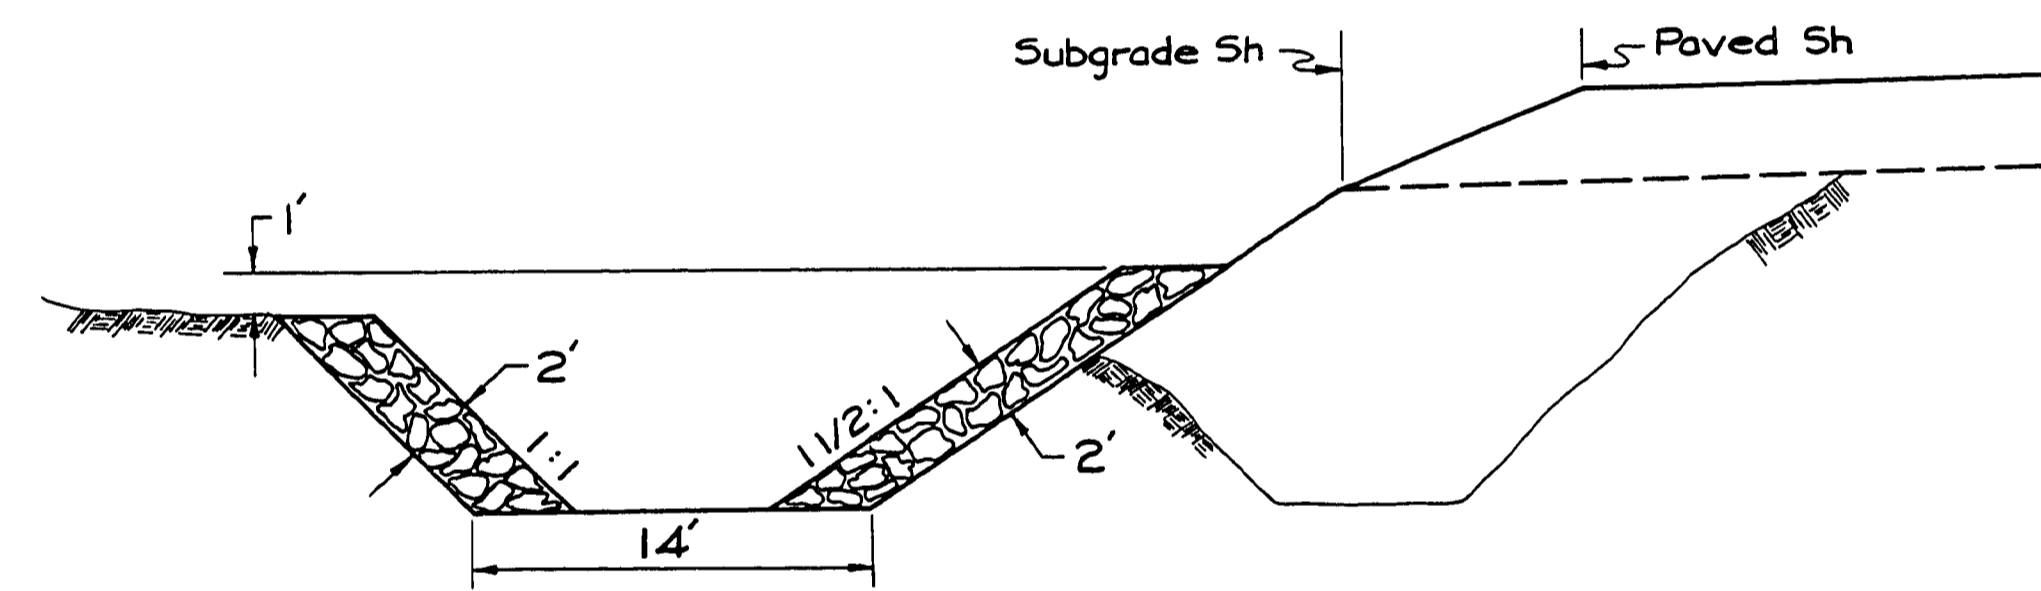


CHANNEL CHANGE

STA 132+30 - 133+80

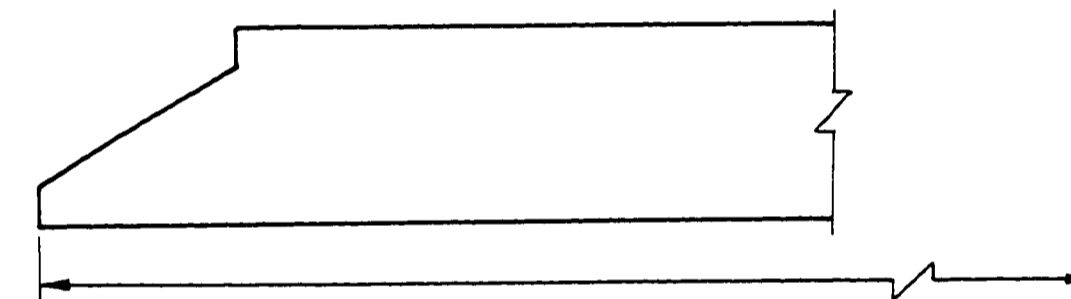

PLAN & PAY LENGTH

LONGITUDINAL SECTION
SLOPED ENDS FOR METAL PIPES
AS PER O.S.H.D. STD DWG # 2112

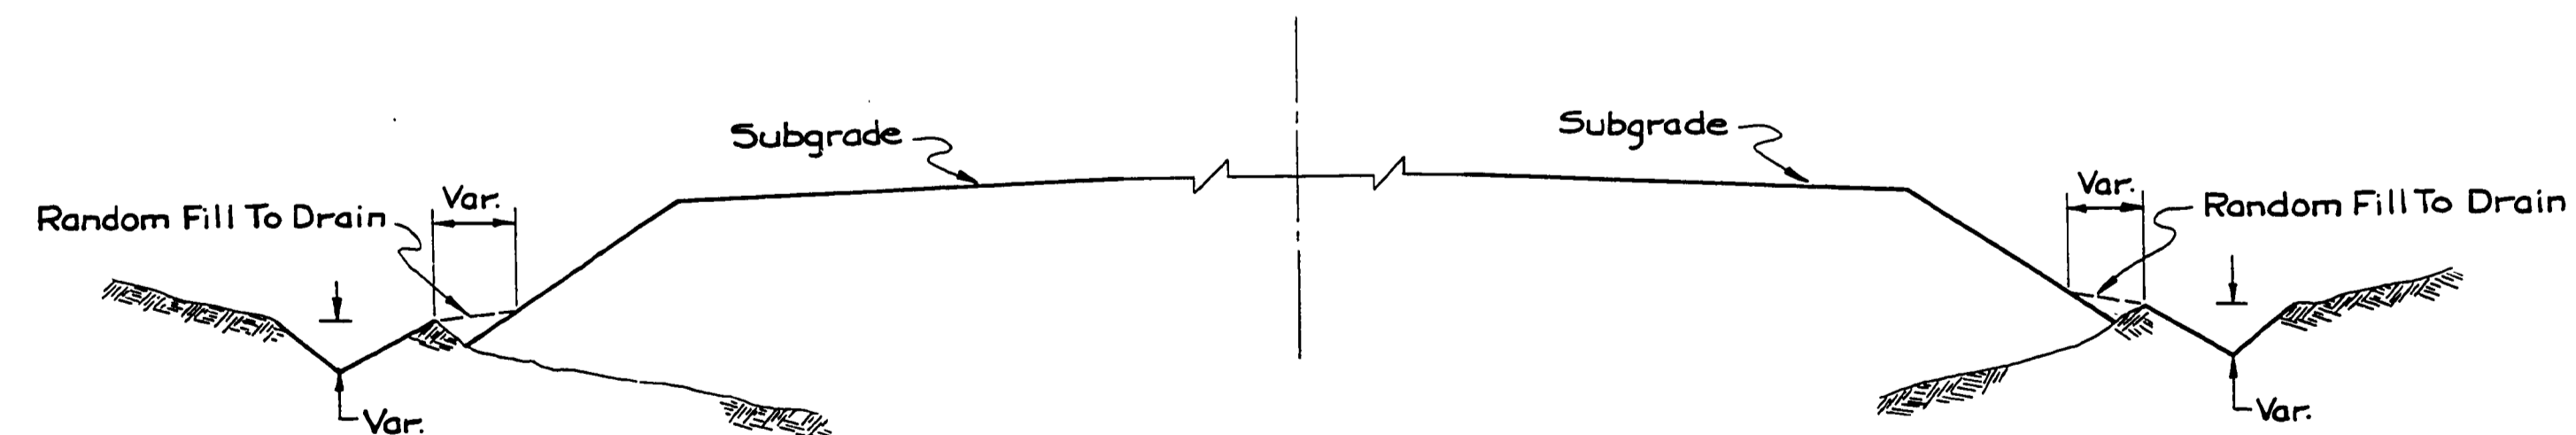

SPECIAL DITCH

LEFT
STA 71+00 - 71+70
72+10 - 72+80
211+75 - 213+80

RIGHT
STA 60+50 - 63+70
194+70 - 196+00
196+70 - 198+00
236+50 - 240+50

NOT REVISED
AS CONSTRUCTED

DOUGLAS COUNTY ROAD DEPT.
ELGAROSE ROAD NO. 53
MAY 1971 SHT 3
GEORGE E. GRUBB COUNTY ENG.

0000TYPI