
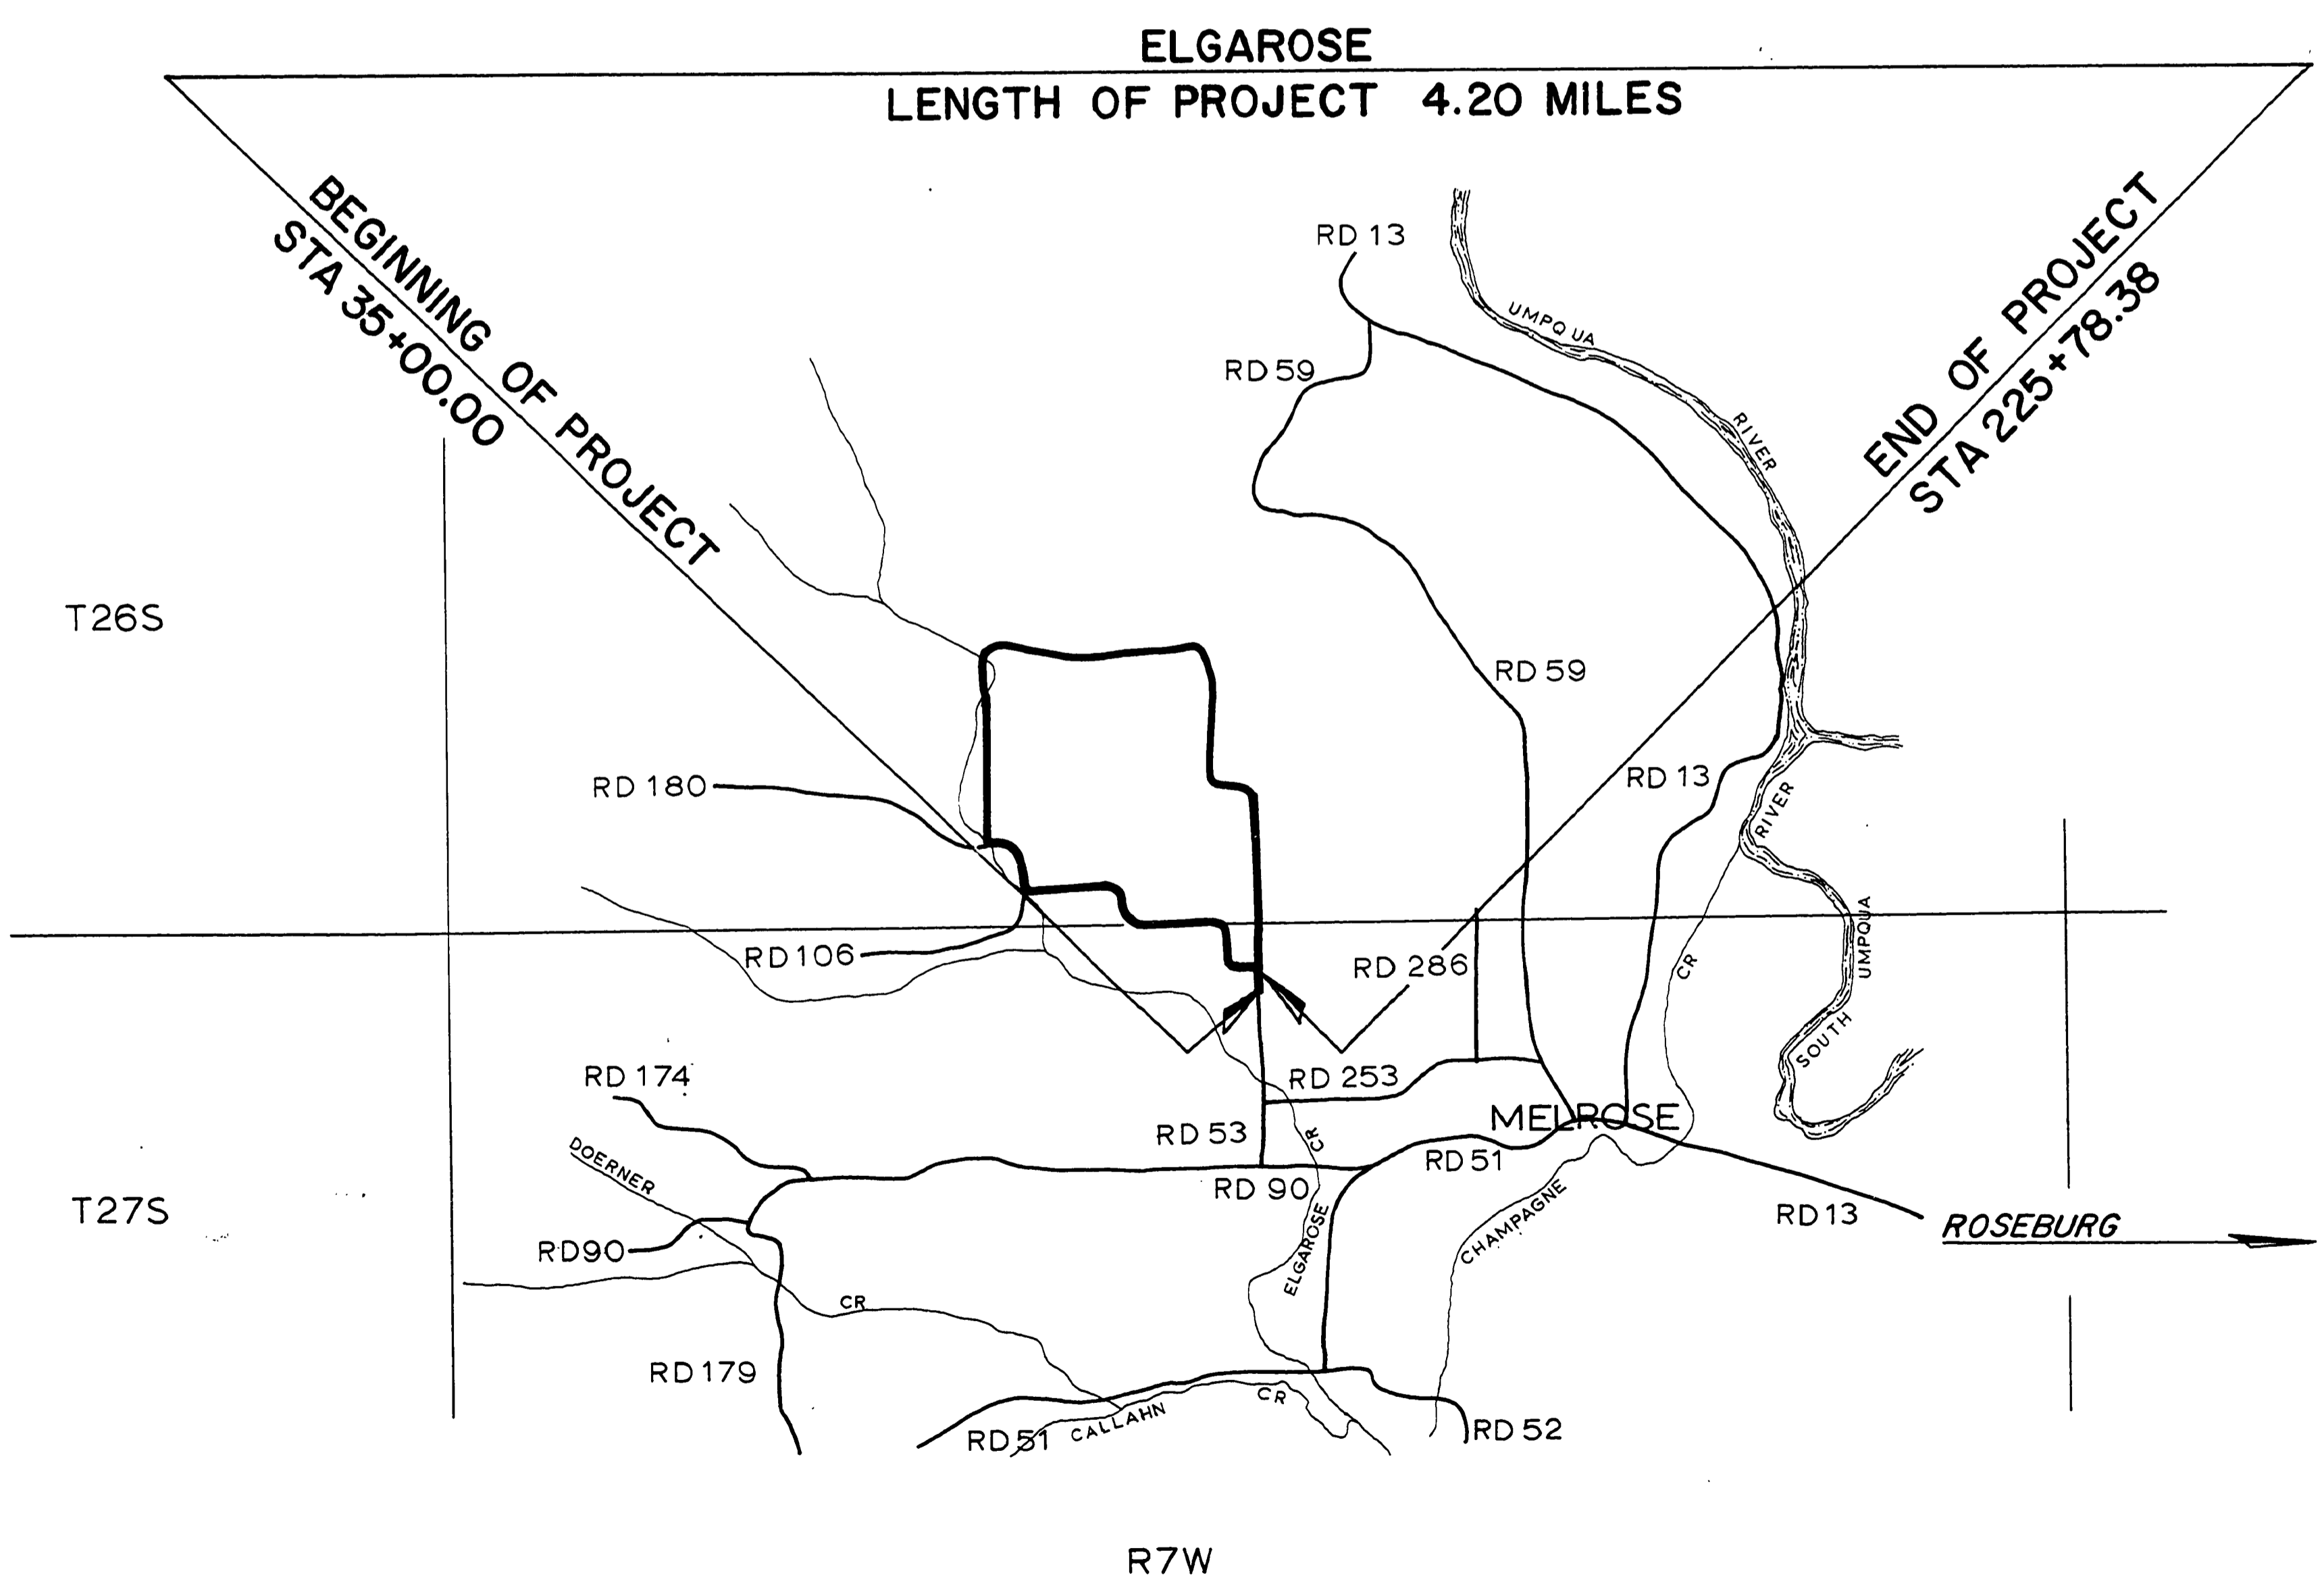


DOUGLAS COUNTY, OREGON  
 PLANS FOR PROPOSED PROJECT  
 GRADING & SURFACING  
**ELGAROSE COUNTY ROAD NO. 53**  
 MILE POINT 0.72 TO MILE POINT 5.05  
 MAY 1971

FILED  
 RECEIVED  
 JUN 1 1971  
 COUNTY SURVEYOR  
 DOUGLAS COUNTY, OREG.

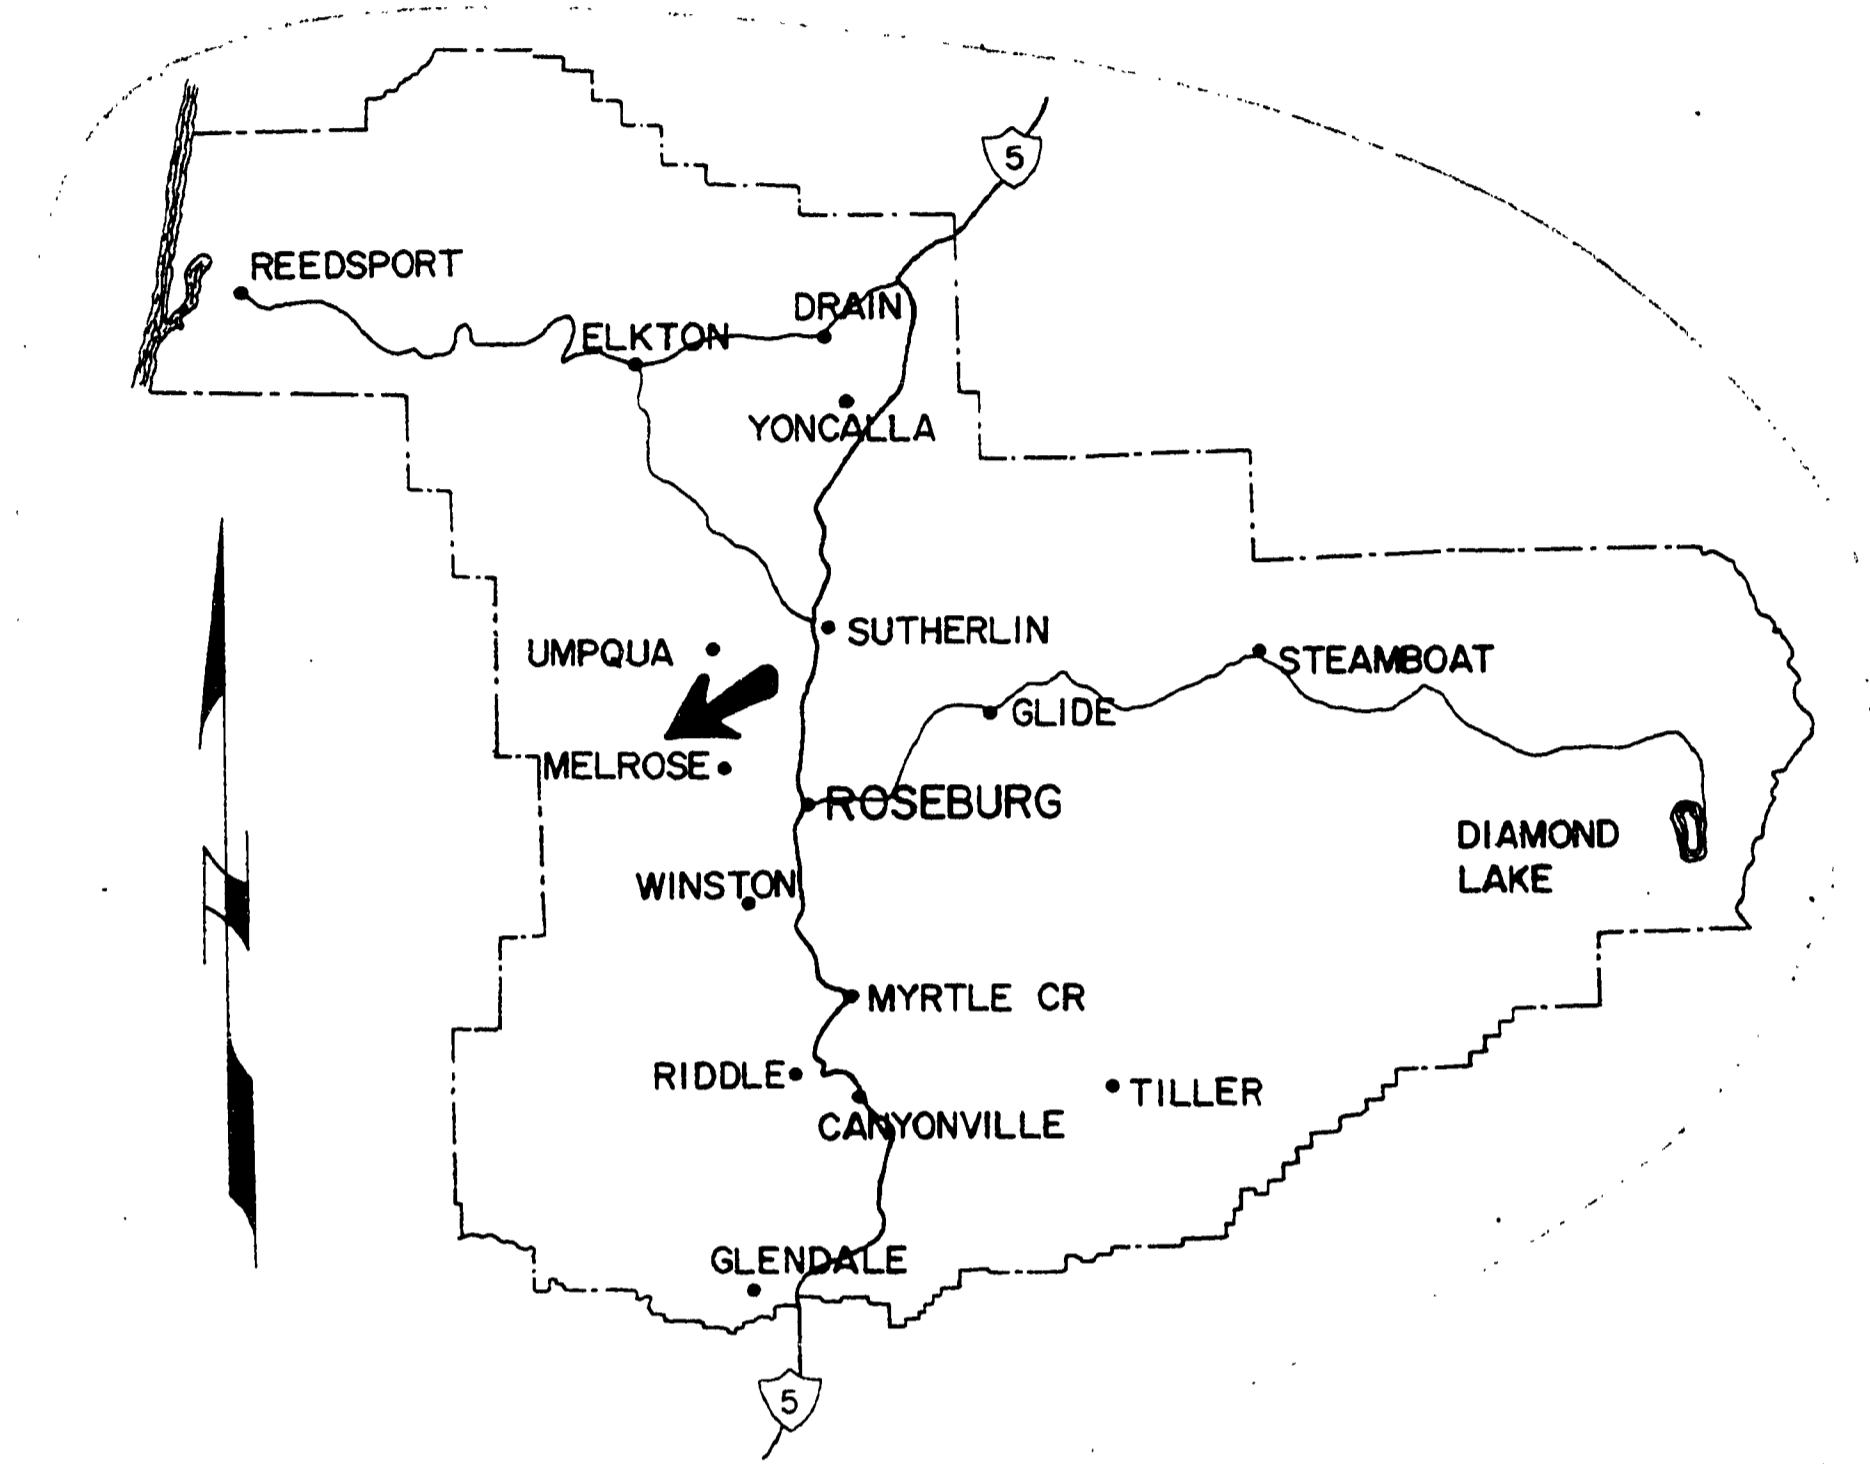

INDEX OF DRAWINGS

SHEET NUMBER	TITLE
1	TITLE SHEET
2	QUANTITY SUMMARY
3	TYPICAL SECTIONS
4 & 5	PIPE LIST
6 THRU 14	ROAD PLANS

STANDARD DRAWINGS  
 #3

TOTAL OF 16 SHEETS

NOT REVISED  
 AS CONSTRUCTED



DOUGLAS COUNTY ROAD DEPT.  
 ELGAROSE ROAD NO. 53  
 MAY 1971 SHT 1  
 GEORGE E. GRUBB COUNTY ENG.

0072049C