


DOUGLAS COUNTY  
OREGON  
BULLOCK ROAD NO. 57  
Sheet No. 5 of 20 sheets  
F.C. Frear County Engineer February 1936

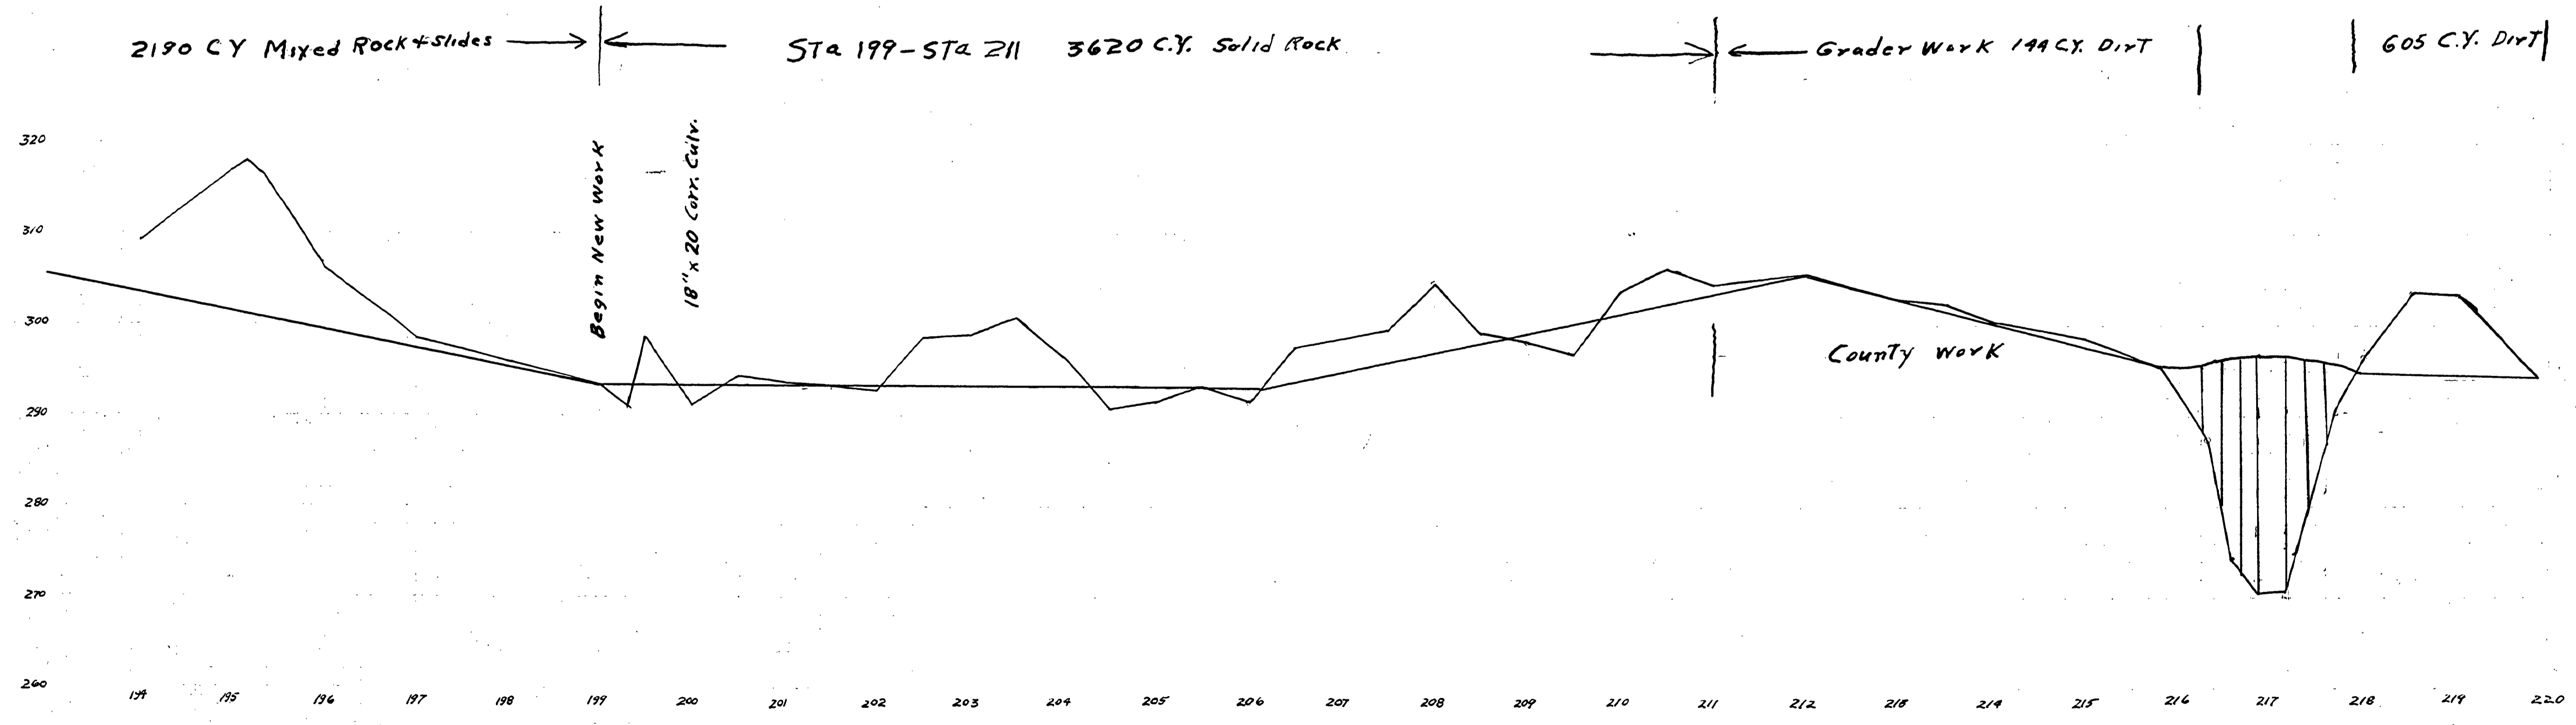

69780441