
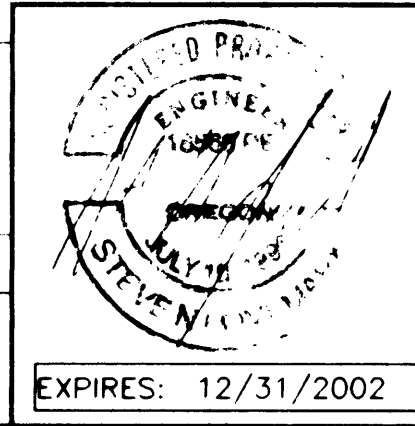


CALL BEFORE YOU DIG!
 ONE CALL: (800) 332-2344
 OAR 952-001-0010 THROUGH
 OAR 952-001-0090

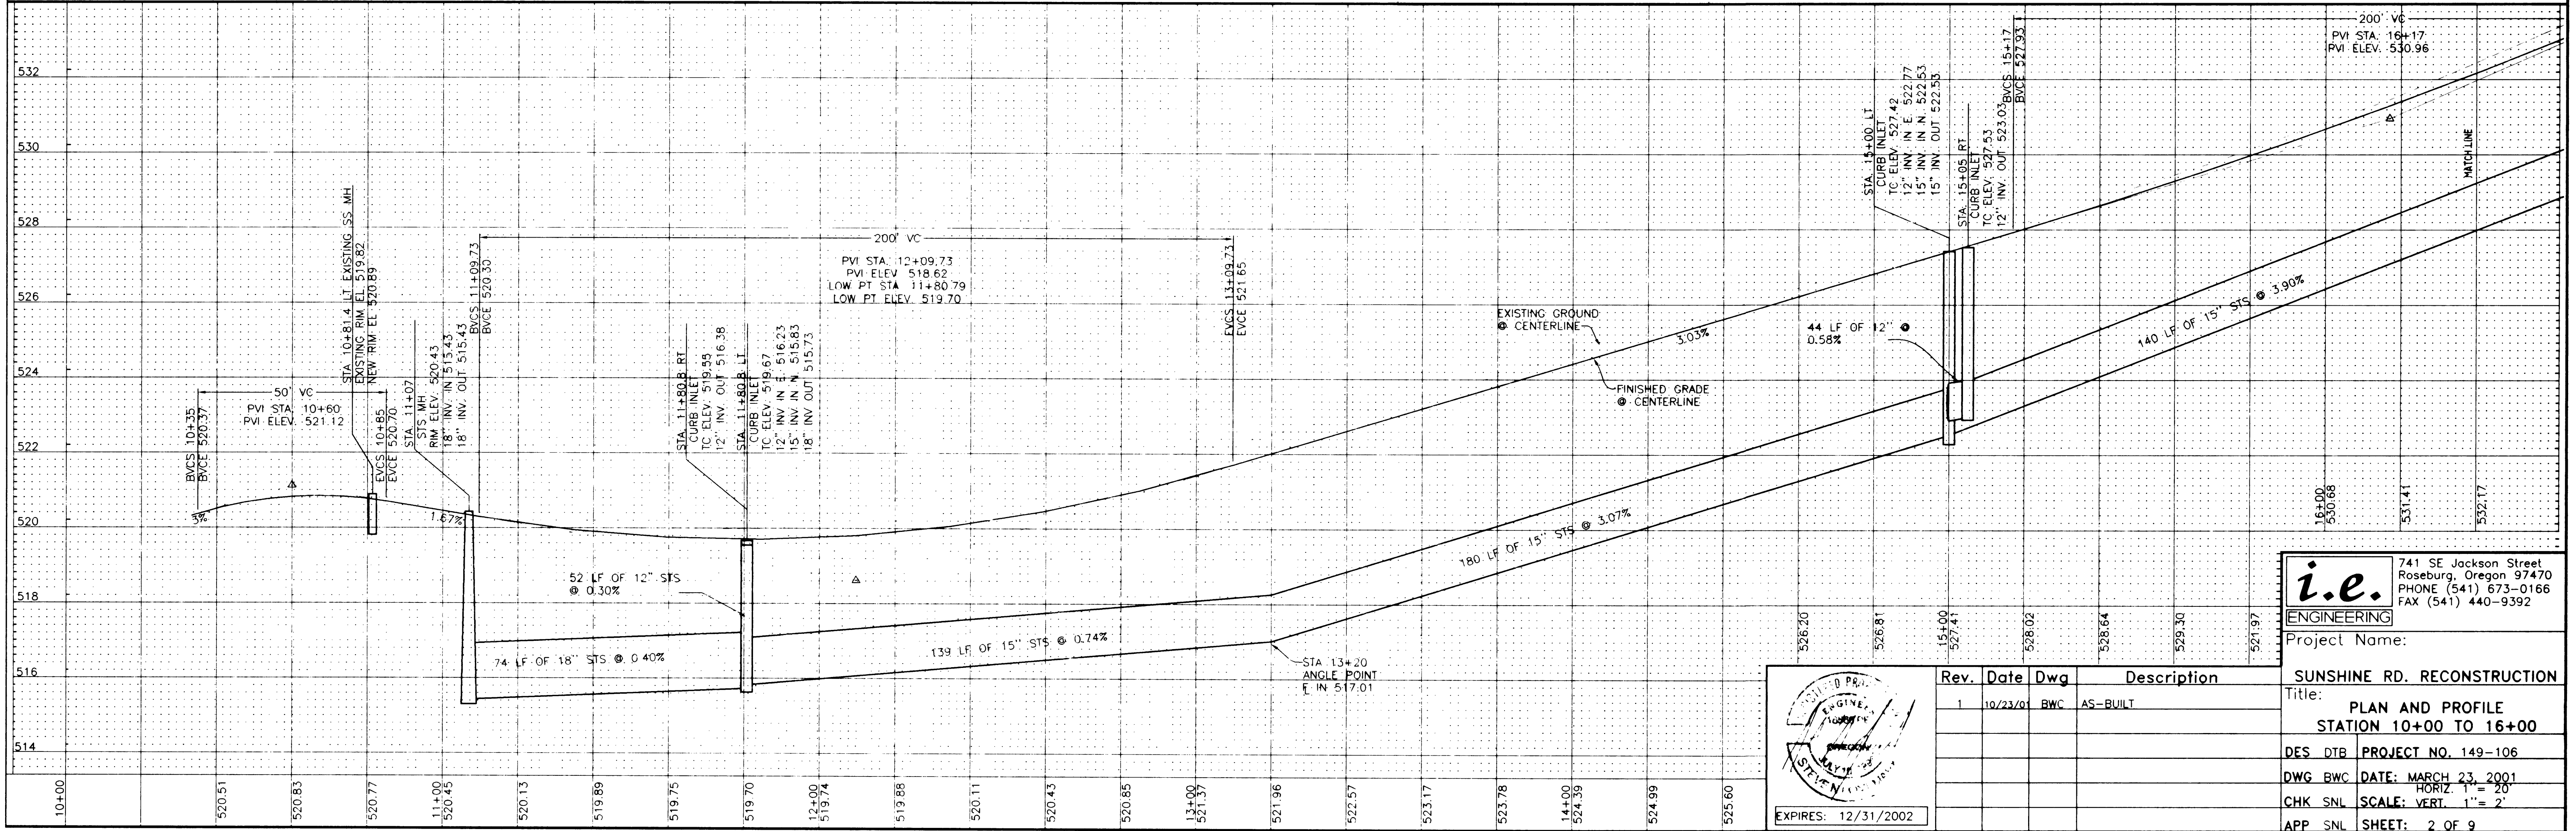

Rev.	Date	Dwg	Description
1	10/23/01	BWC	AS-BUILT

i.e. ENGINEERING
 741 SE Jackson Street
 Roseburg, Oregon 97470
 PHONE (541) 673-0166
 FAX (541) 440-9392

Project Name: **SUNSHINE RD. RECONSTRUCTION**
 Title: **PLAN AND PROFILE STATION 10+00 TO 16+00**
 DES. DTB: **PROJECT NO. 149-106**
 DWG BWC: **DATE: MARCH 23, 2001**
 CHK SNL: **HORIZ. 1" = 20'**
 APP SNL: **SCALE: VERT. 1" = 2'**
 SHEET: **2 OF 9**

Co. Rd. # 58 M.P. 0.00 - 0.12

CO. RD. # 58 PLAN & PROFILE

00000012

DO NOT DUPLICATE