
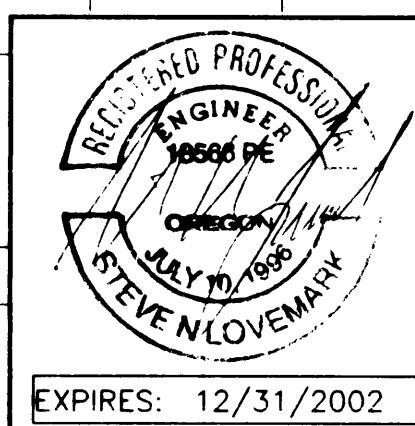


CALL BEFORE YOU DIG I
ONE CALL (800) 332-2344
OAR 952-001-0010 THROUGH
OAR 952-001-0090

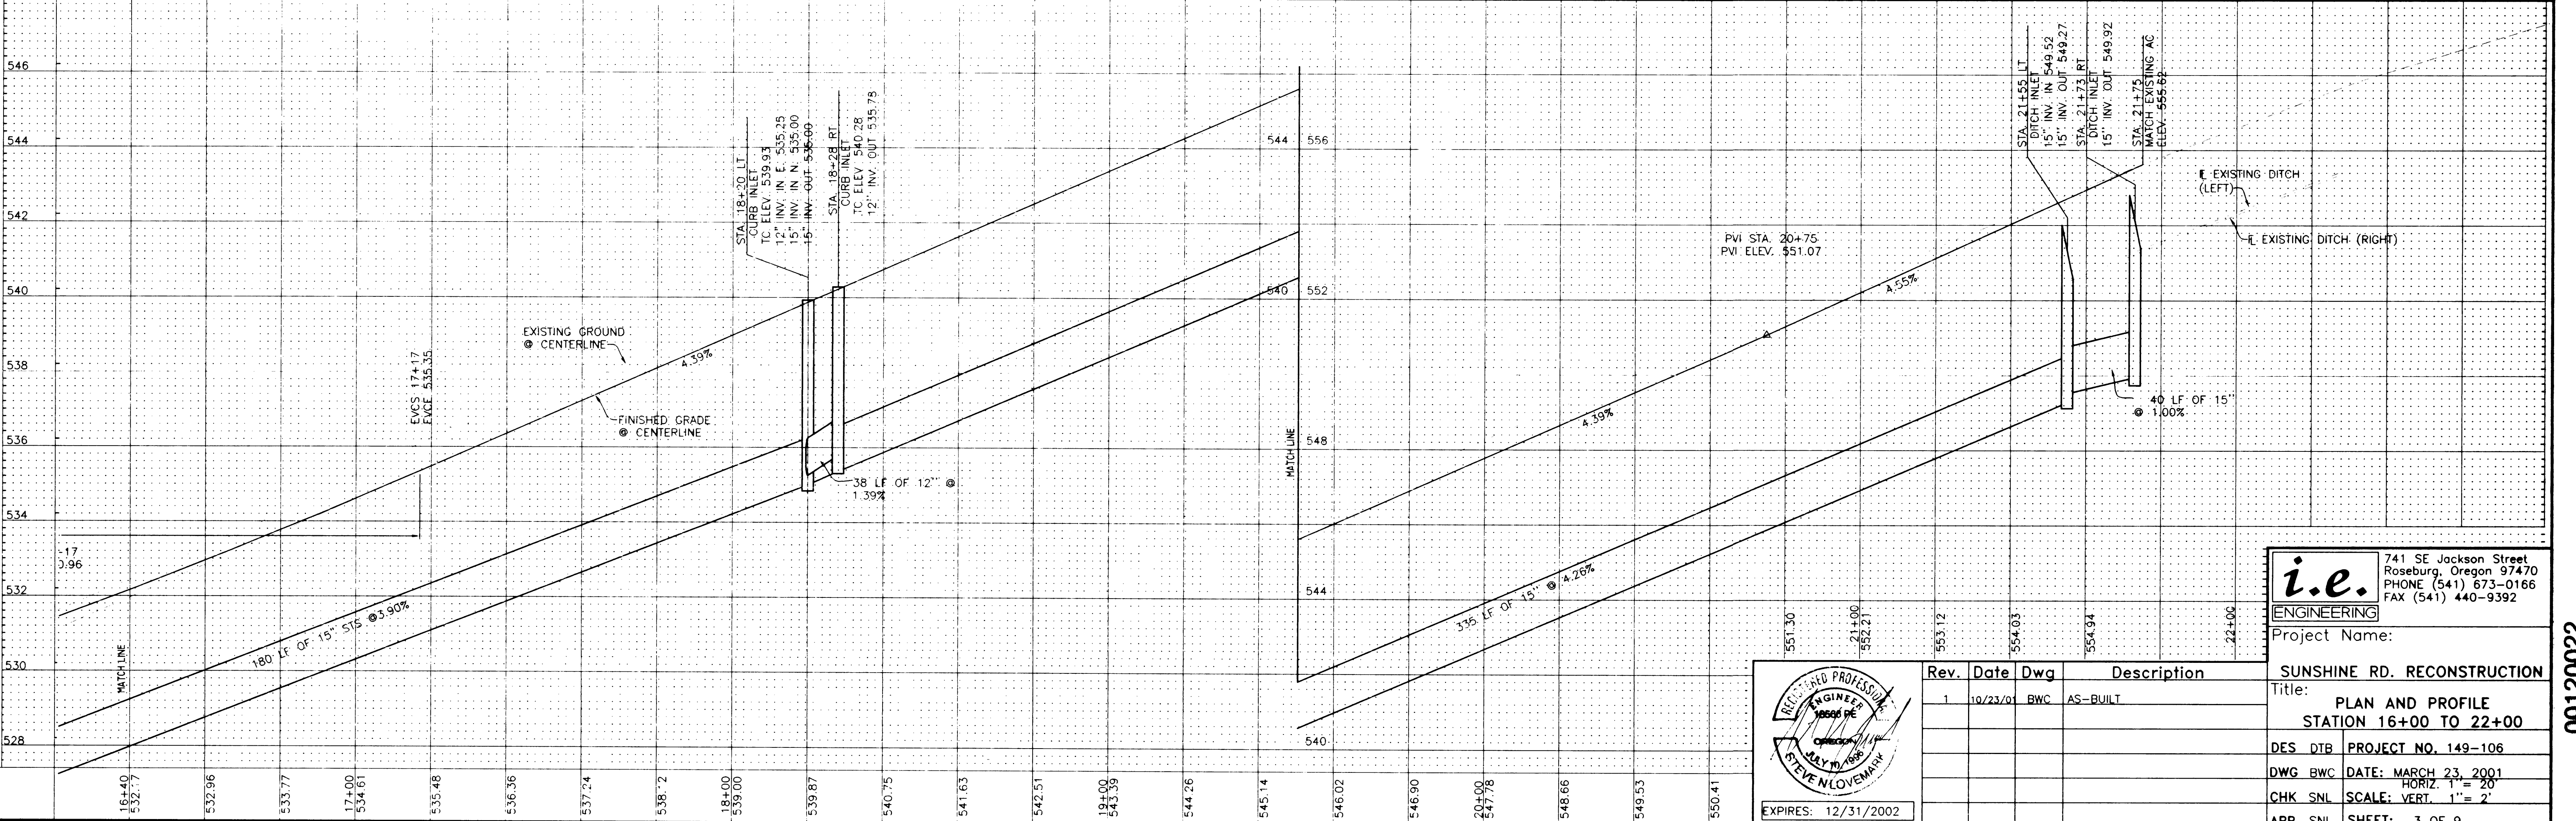

Rev.	Date	Dwg	Description
1	10/23/01	BWC	AS-BUILT

i.e. ENGINEERING
741 SE Jackson Street
Roseburg, Oregon 97470
PHONE (541) 673-0166
FAX (541) 440-9392

Project Name: SUNSHINE RD. RECONSTRUCTION
Title: PLAN AND PROFILE STATION 16+00 TO 22+00
DES. DTB: PROJECT NO. 149-106
DWG. BWC: DATE: MARCH 23, 2001
CHK. SNL: SCALE: HORIZ. 1" = 20'
APP. SNL: SHEET: 3 OF 9

Co. Rd. #58 M.P. 0.12-0.22

CO. RD. # 58 PLAN & PROFILE

00120022

DO NOT DUPLICATE