


CALL BEFORE YOU DIG!  
ONE CALL: (800) 332-2344  
OAR 952-001-0010 THROUGH  
OAR 952-001-0090

**i.e.**  
741 SE Jackson Street  
Roseburg, Oregon 97470  
PHONE (541) 673-0166  
FAX (541) 440-9392

Project Name:		SUNSHINE RD. RECONSTRUCTION	
Title:		STORM OUTLET AND EROSION CONTROL PLAN	
DES DTB	PROJECT NO.	149-106	
DWG BWC	DATE:	MARCH 23, 2001	
CHK SNL	SCALE:	1" = 30'	
APP SNL	SHEET:	4 OF 9	

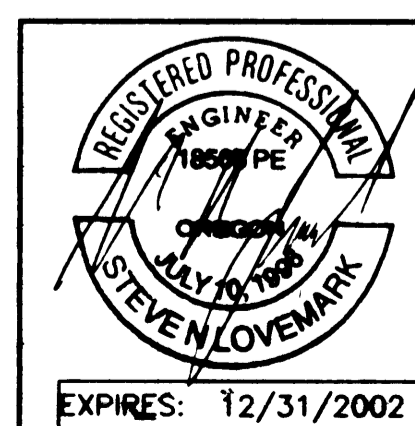

Rev.	Date	Dwg	Description
1	10/23/01	BWC	AS-BUILT

Co. Rd. #58

CO. RD. # 58 STORM OUTLET & EROSION CONTROL

DO NOT DUPLICATE