



FILED
RECORDED
COUNTY CLERK
JUN 15 1959

DOUGLAS COUNTY, OREGON
PLANS FOR CONSTRUCTED PROJECT
GRADING AND SURFACING
CLEVELAND HILL
COUNTY ROAD NO. 59
JUNE 1959

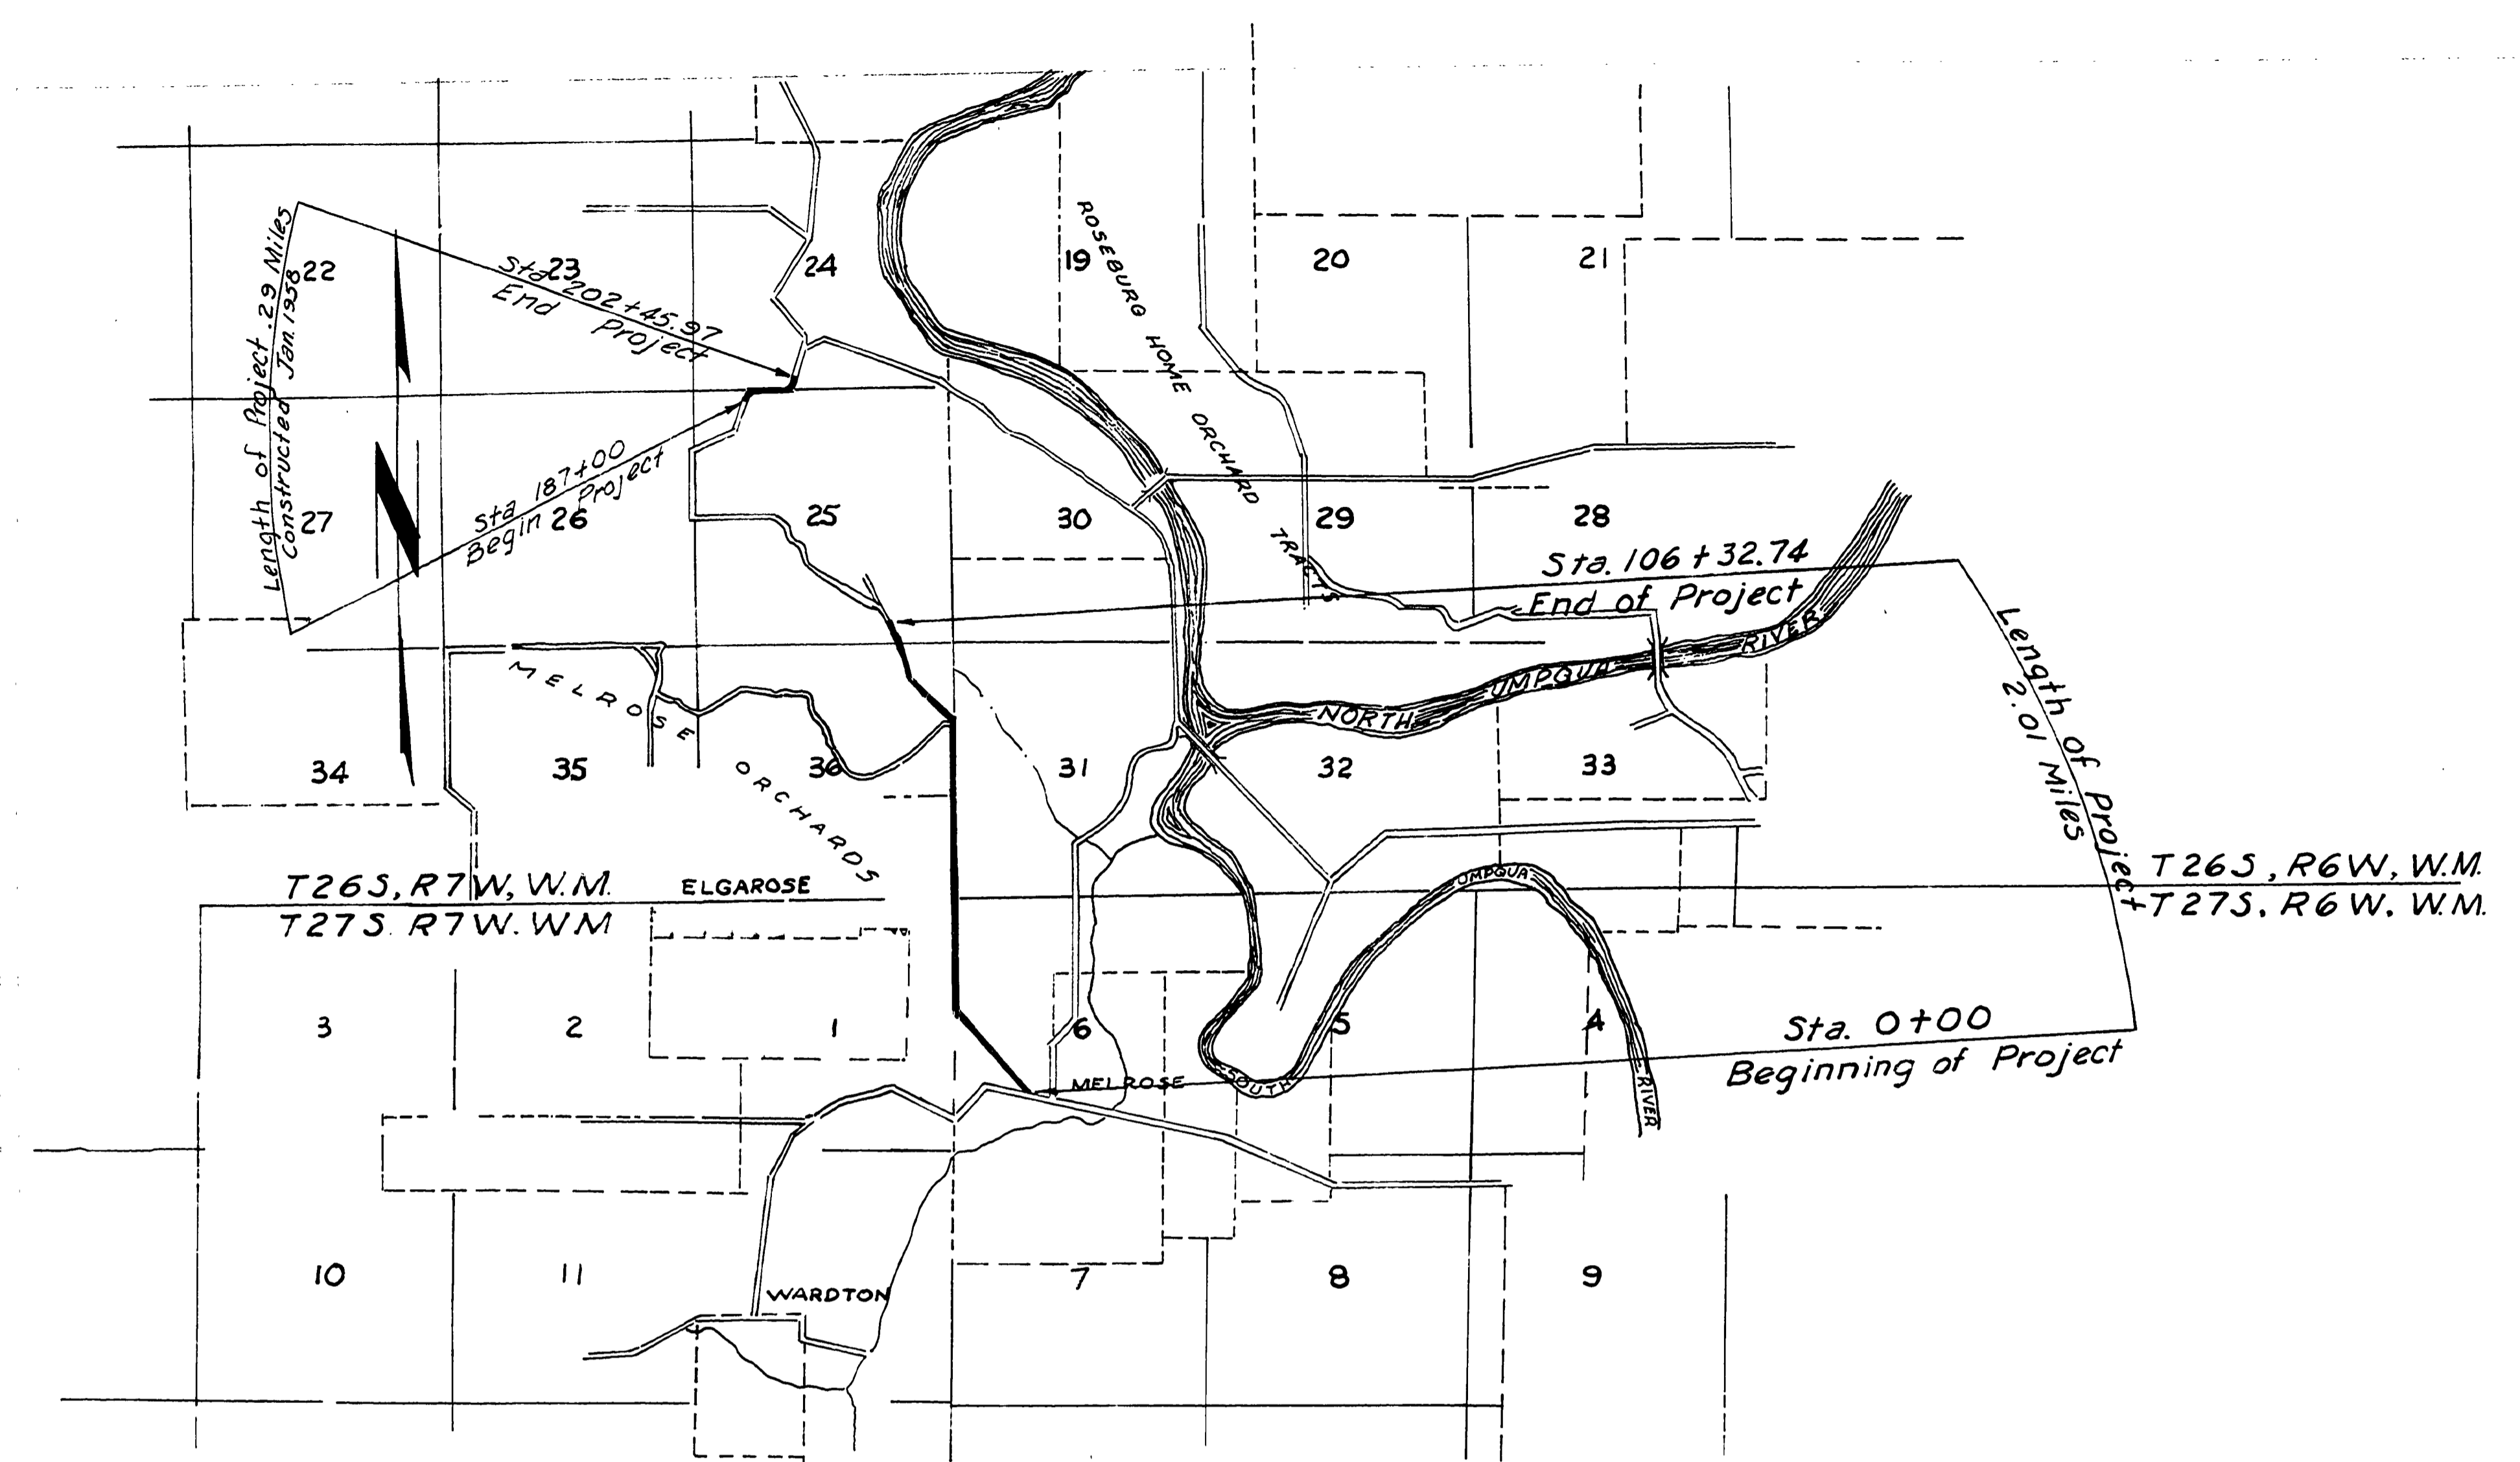

TYPICAL SECTION

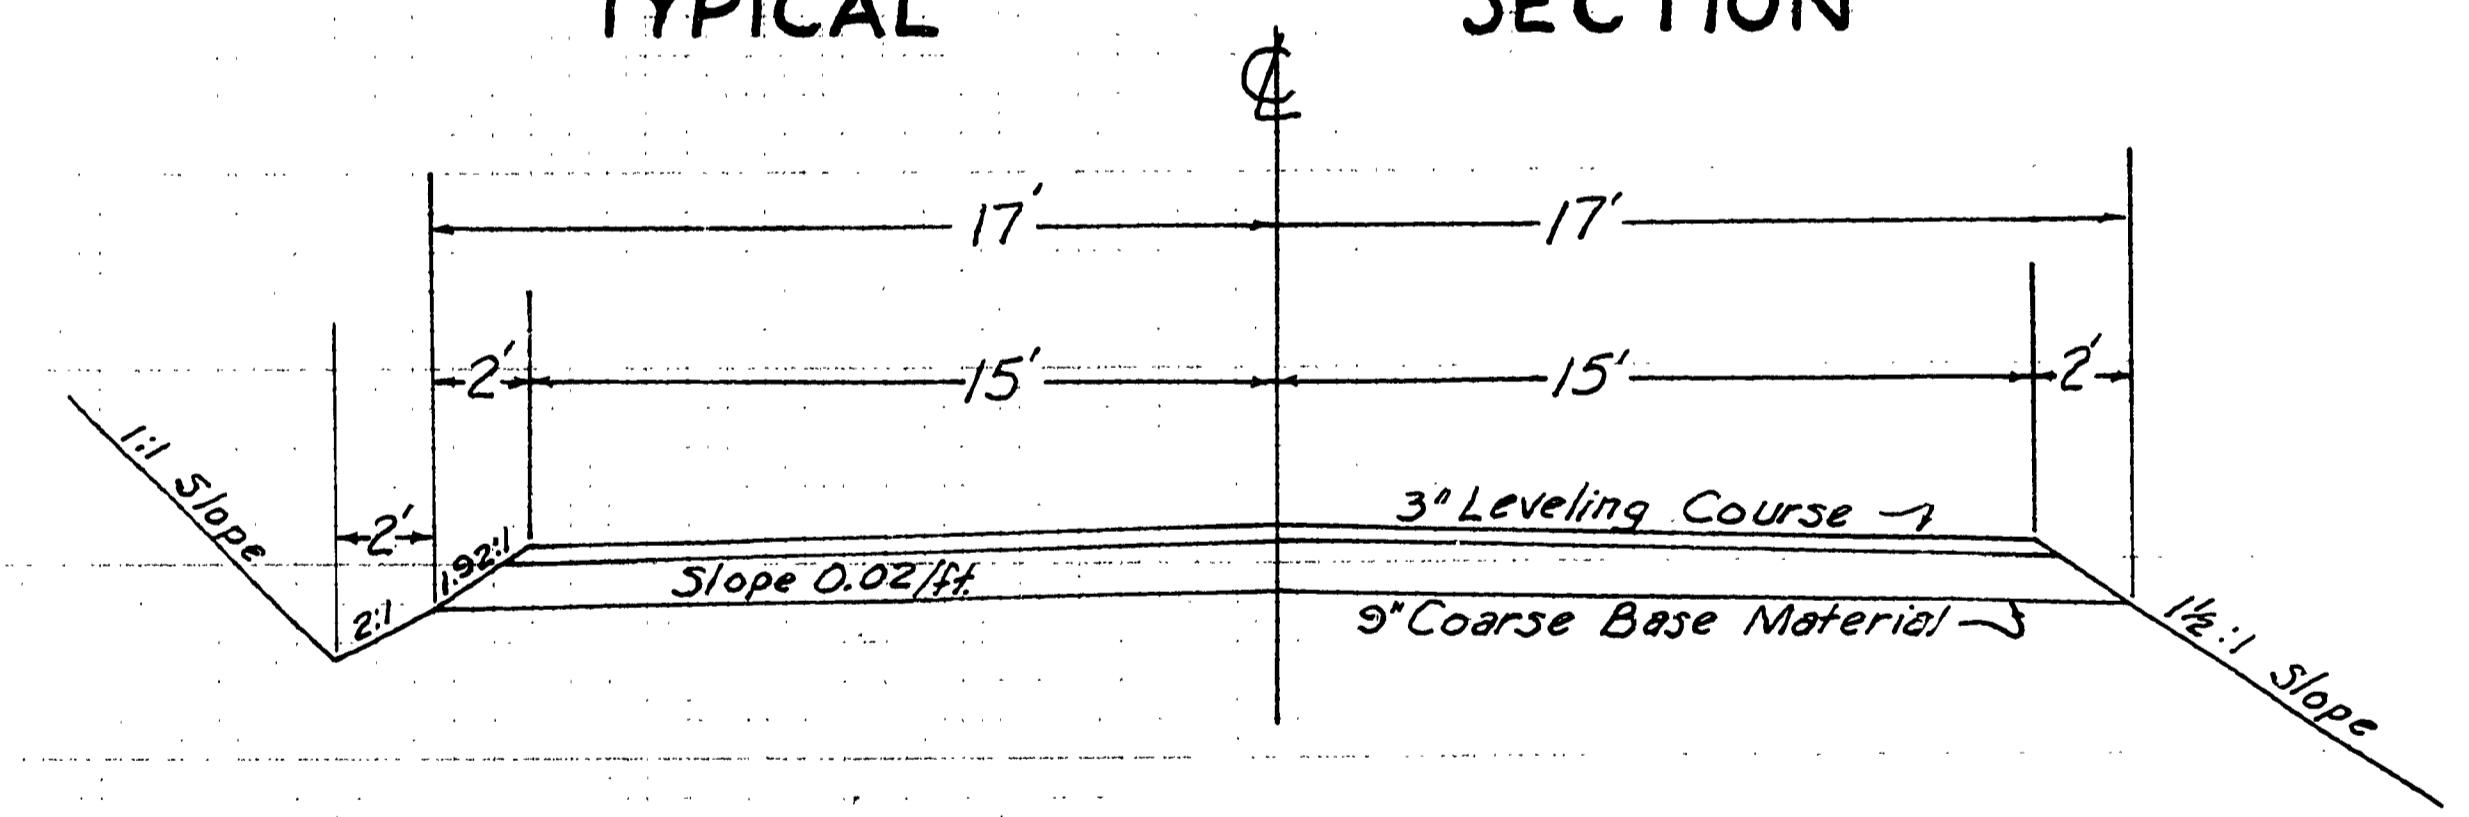

FINAL SURVEY
 ORIGINAL SURVEY
 1958
 1959

000037C