


DOUGLAS COUNTY OREGON
 PLANS FOR PROPOSED PROJECT
 AS CONSTRUCTED
PLAT "I" & "K" ROADS
 COUNTY ROADS No. 70 & 75
 APRIL 1961

TYPICAL SECTION

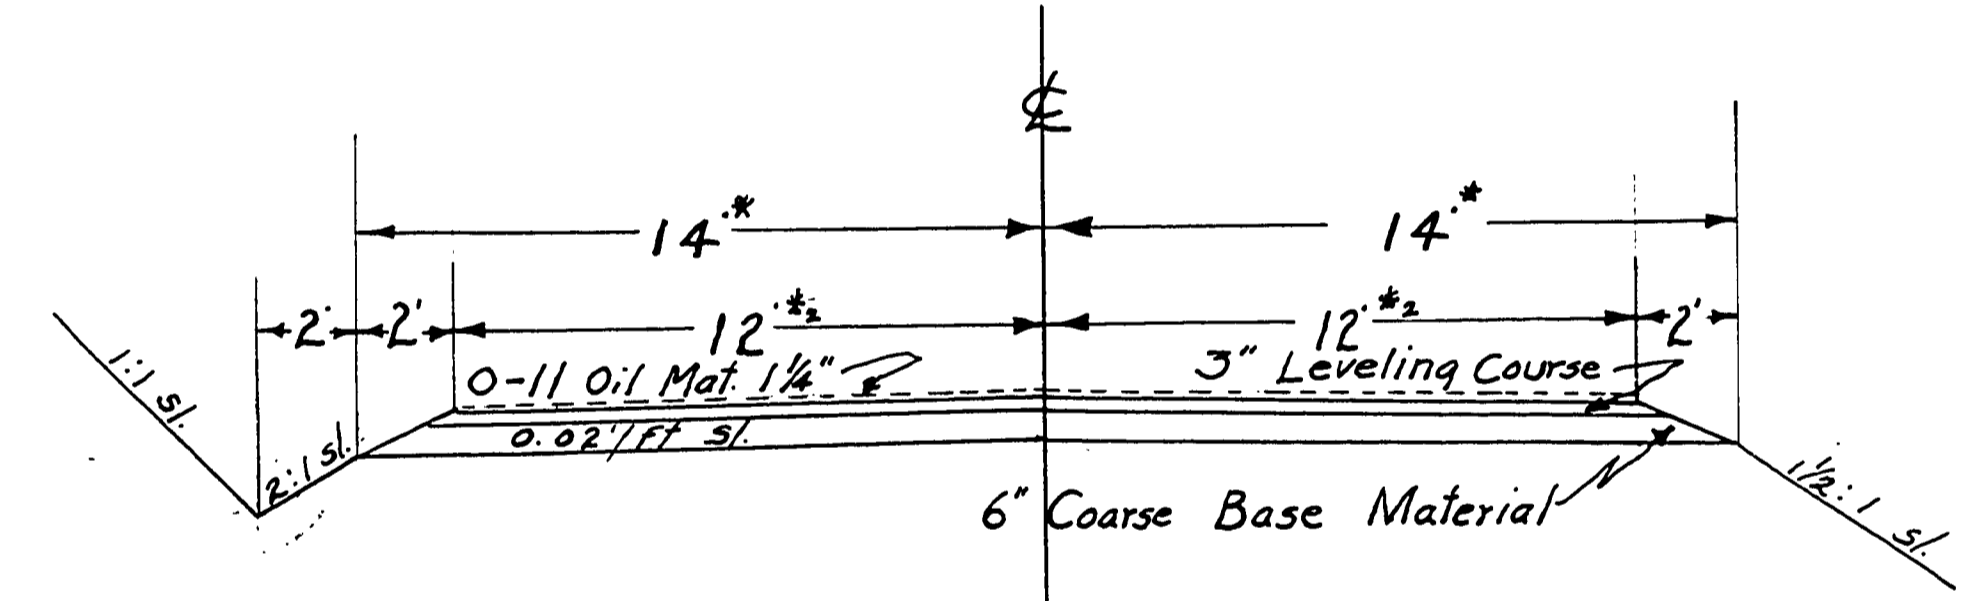

Plat "I" Sta. 0+00 to Sta. 118+15.02
 Plat "K" Sta. Equation 13+30.54 BK to Sta. 62+50
 Sta. 95+00.00 to Sta. 115+50.00

* Plat "K" 18'
 *2 Plat "K" 15'



Approved by *George E. Gruib* Nov 24, 1964
 ASSIST. CO. ENGINEER

Adopted by Resolution of the County
 Court, this 13th day of July 1961

V. J. Jackson
 CLERK
 COMMISSIONER
Russell
 COMMISSIONER

0000022C