
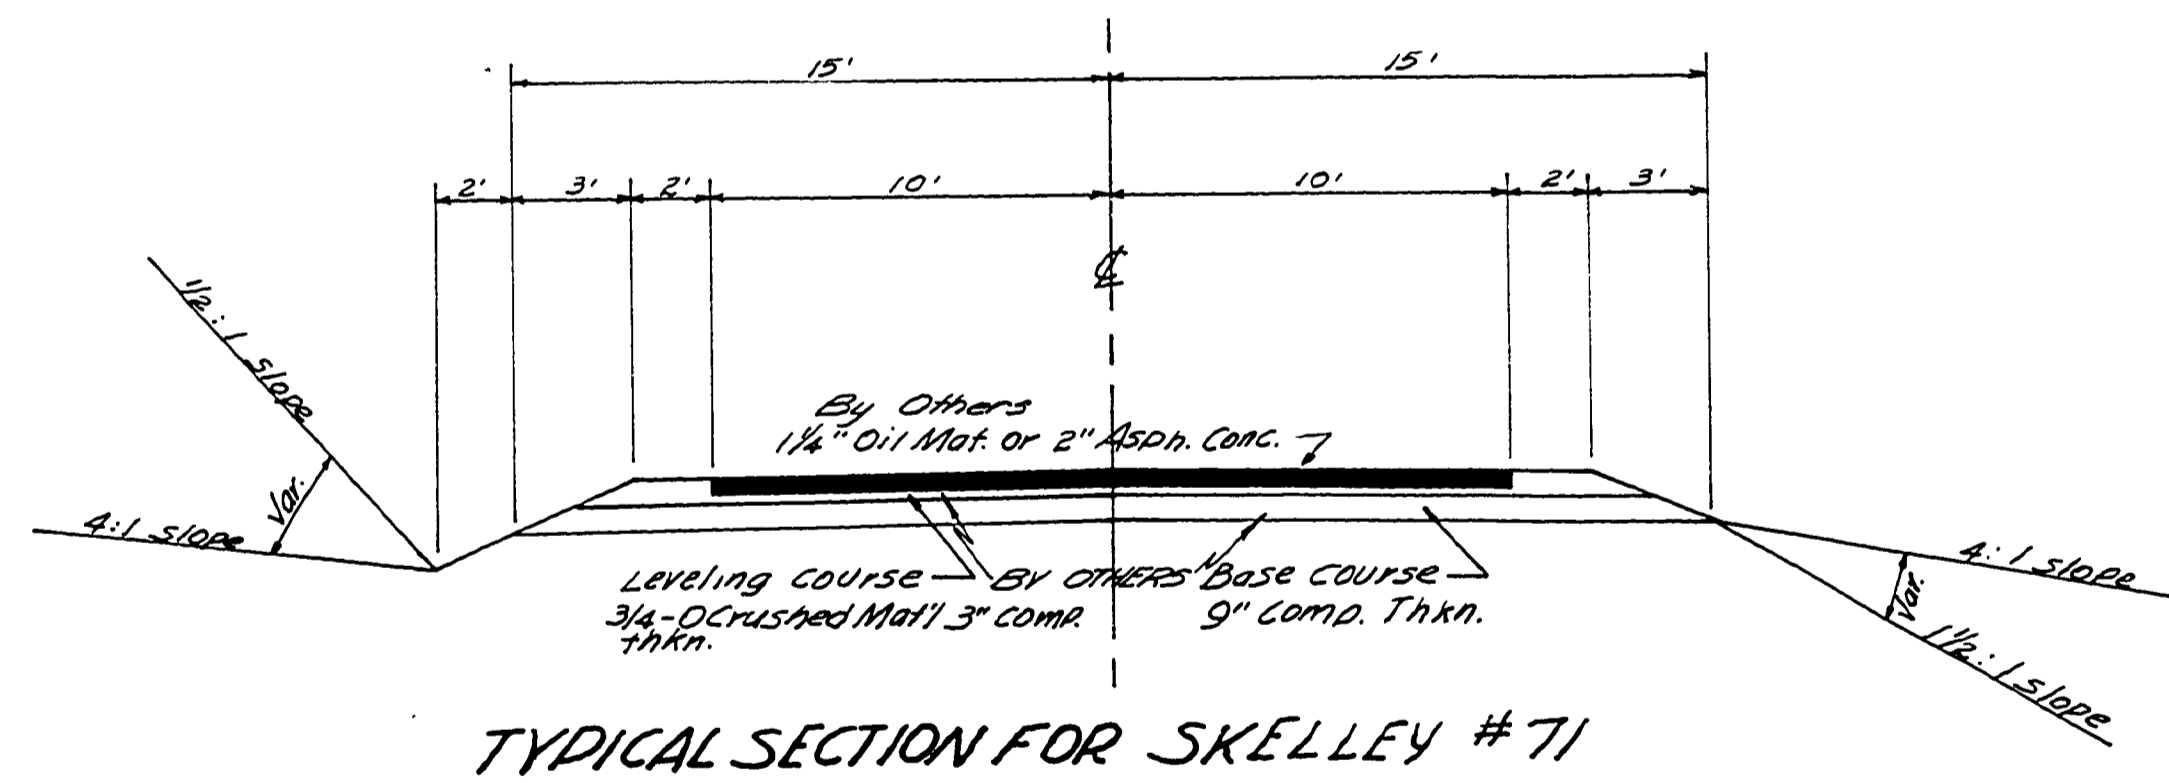


DOUGLAS COUNTY OREGON
 AS CONSTRUCTED
 GRADING
 SKELLEY ROAD
 CO. ROAD #71
 HAYHURST TO BILLY CR. SECTION
 JUNE 1965

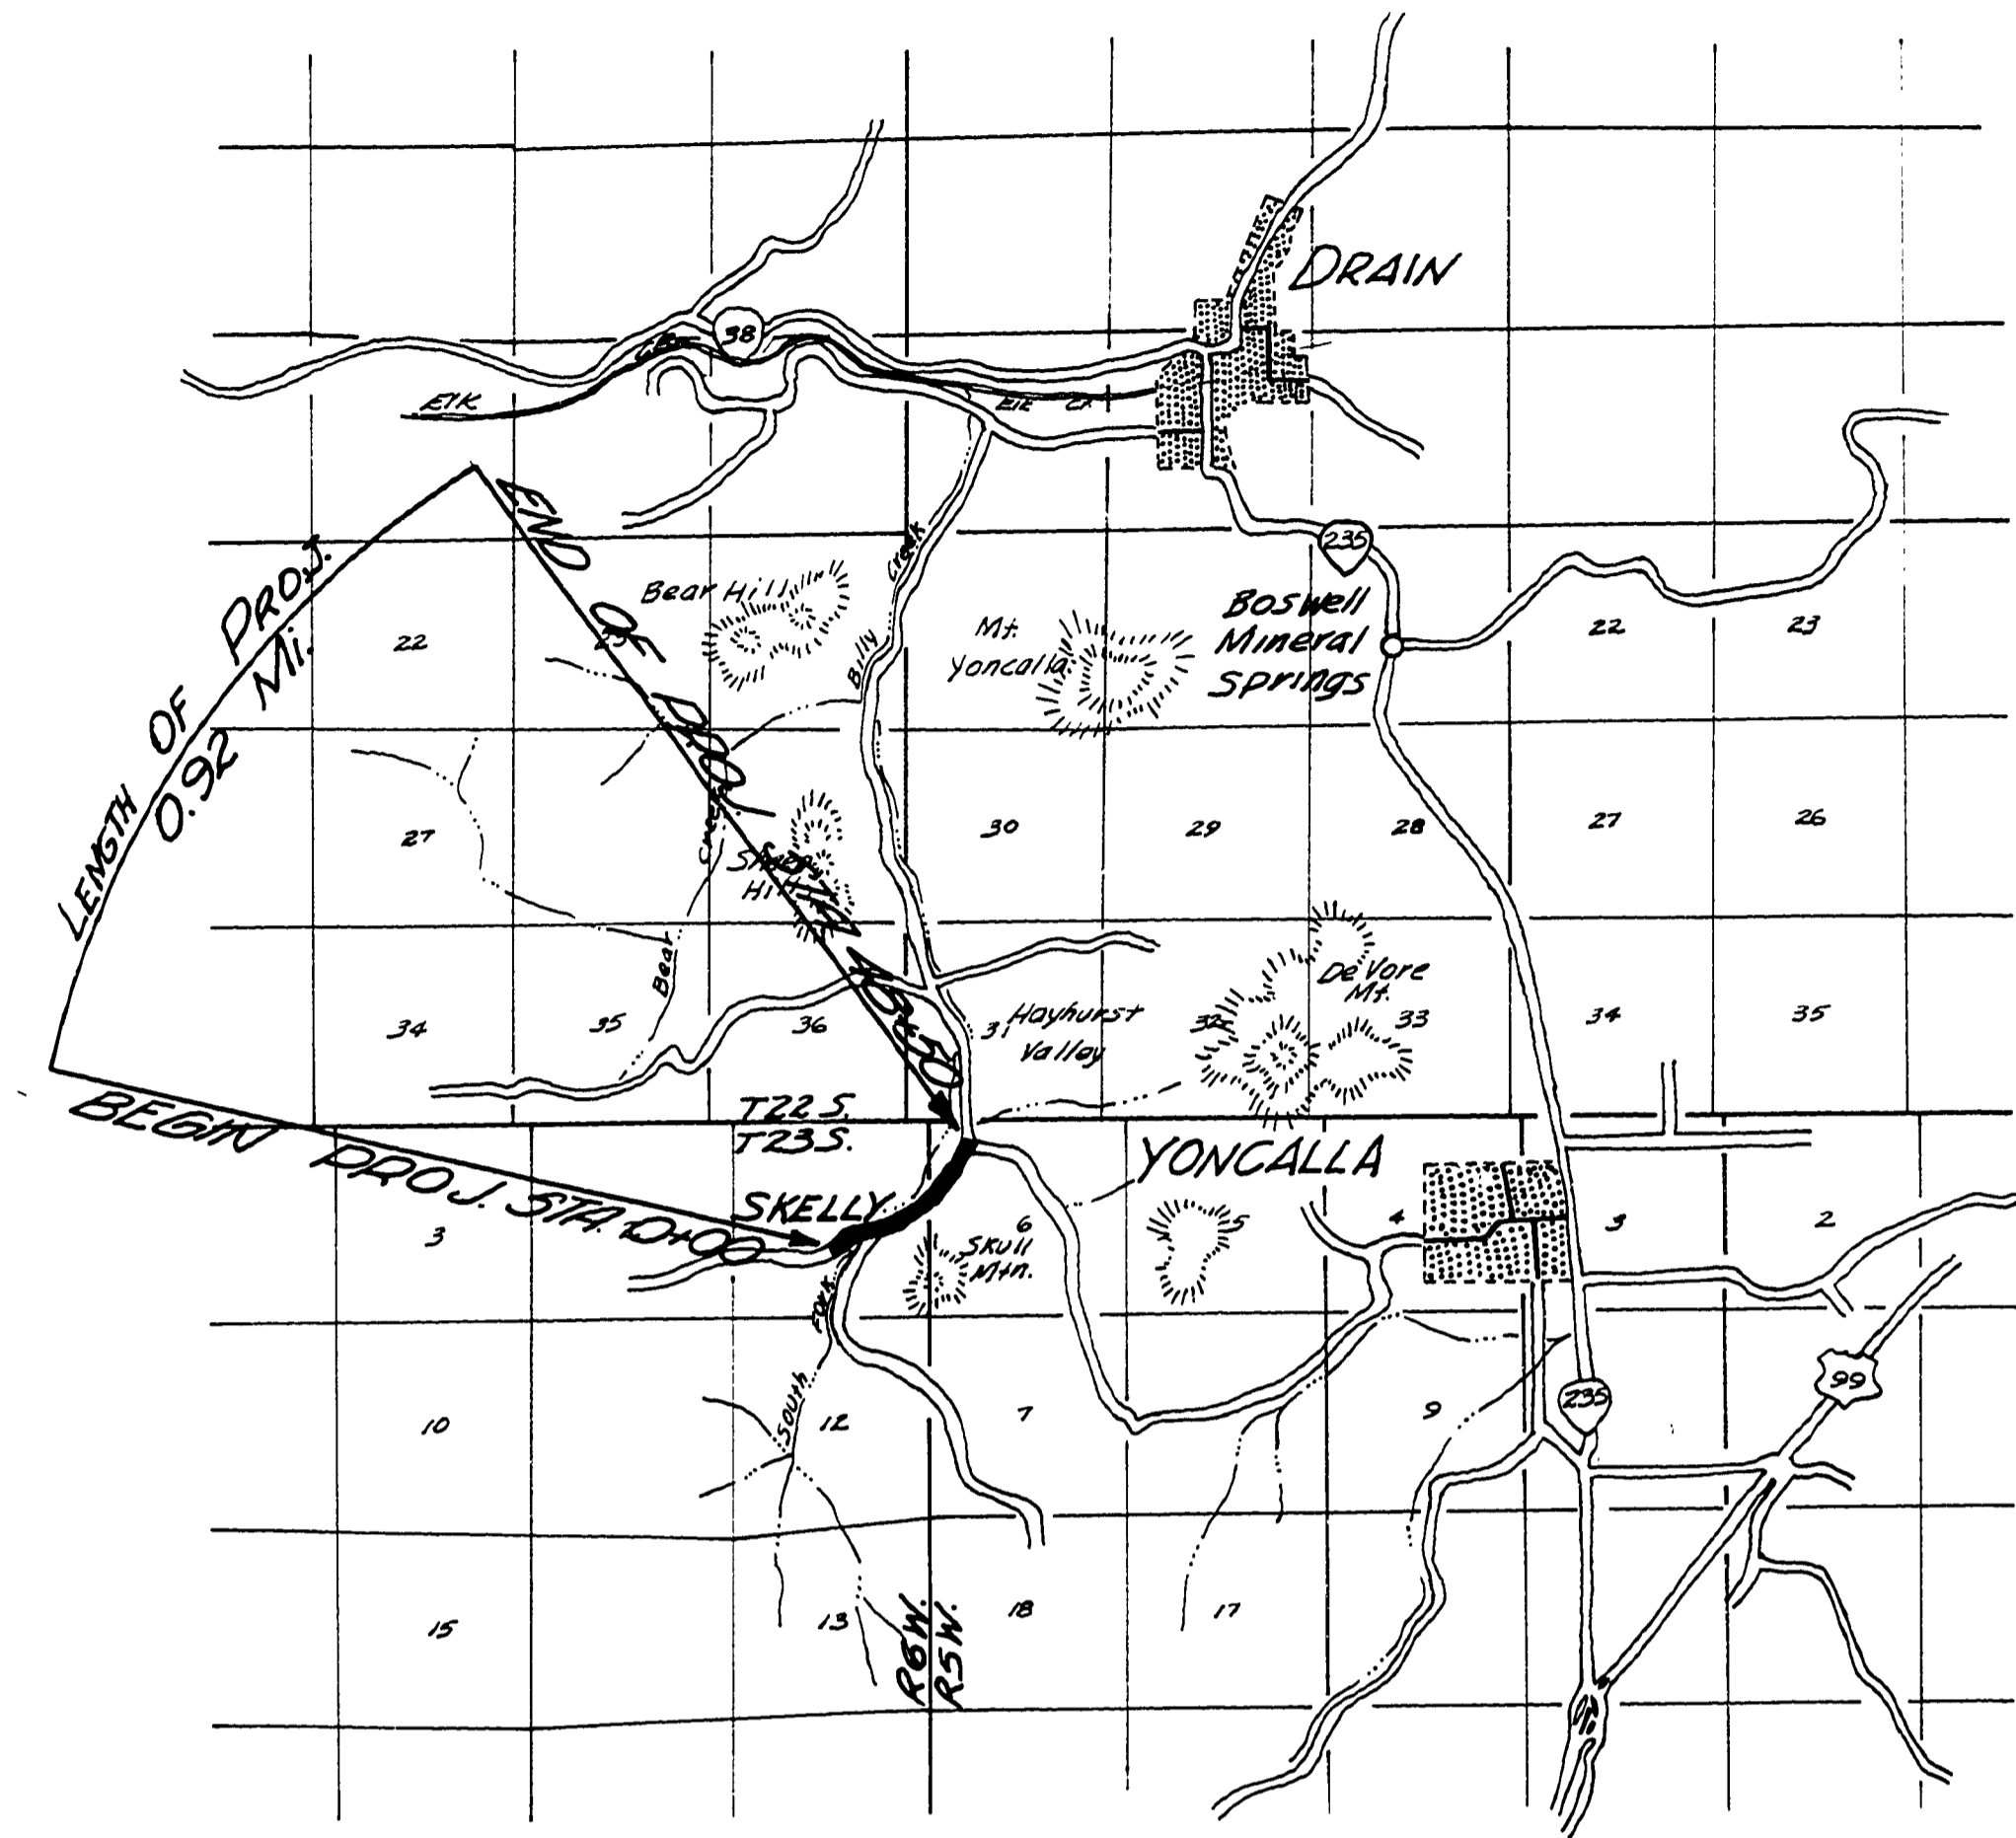

NOT
 RECORDED
 FILED

JUNE '65
 3-7-62

Co. Rd. #71
 sheet 1 of 3

0000009C