


# DOUGLAS COUNTY OREGON

AS CONSTRUCTED

## GRADING & SURFACING METZ HILL ROAD

COUNTY ROAD NUMBER 74

March 1963

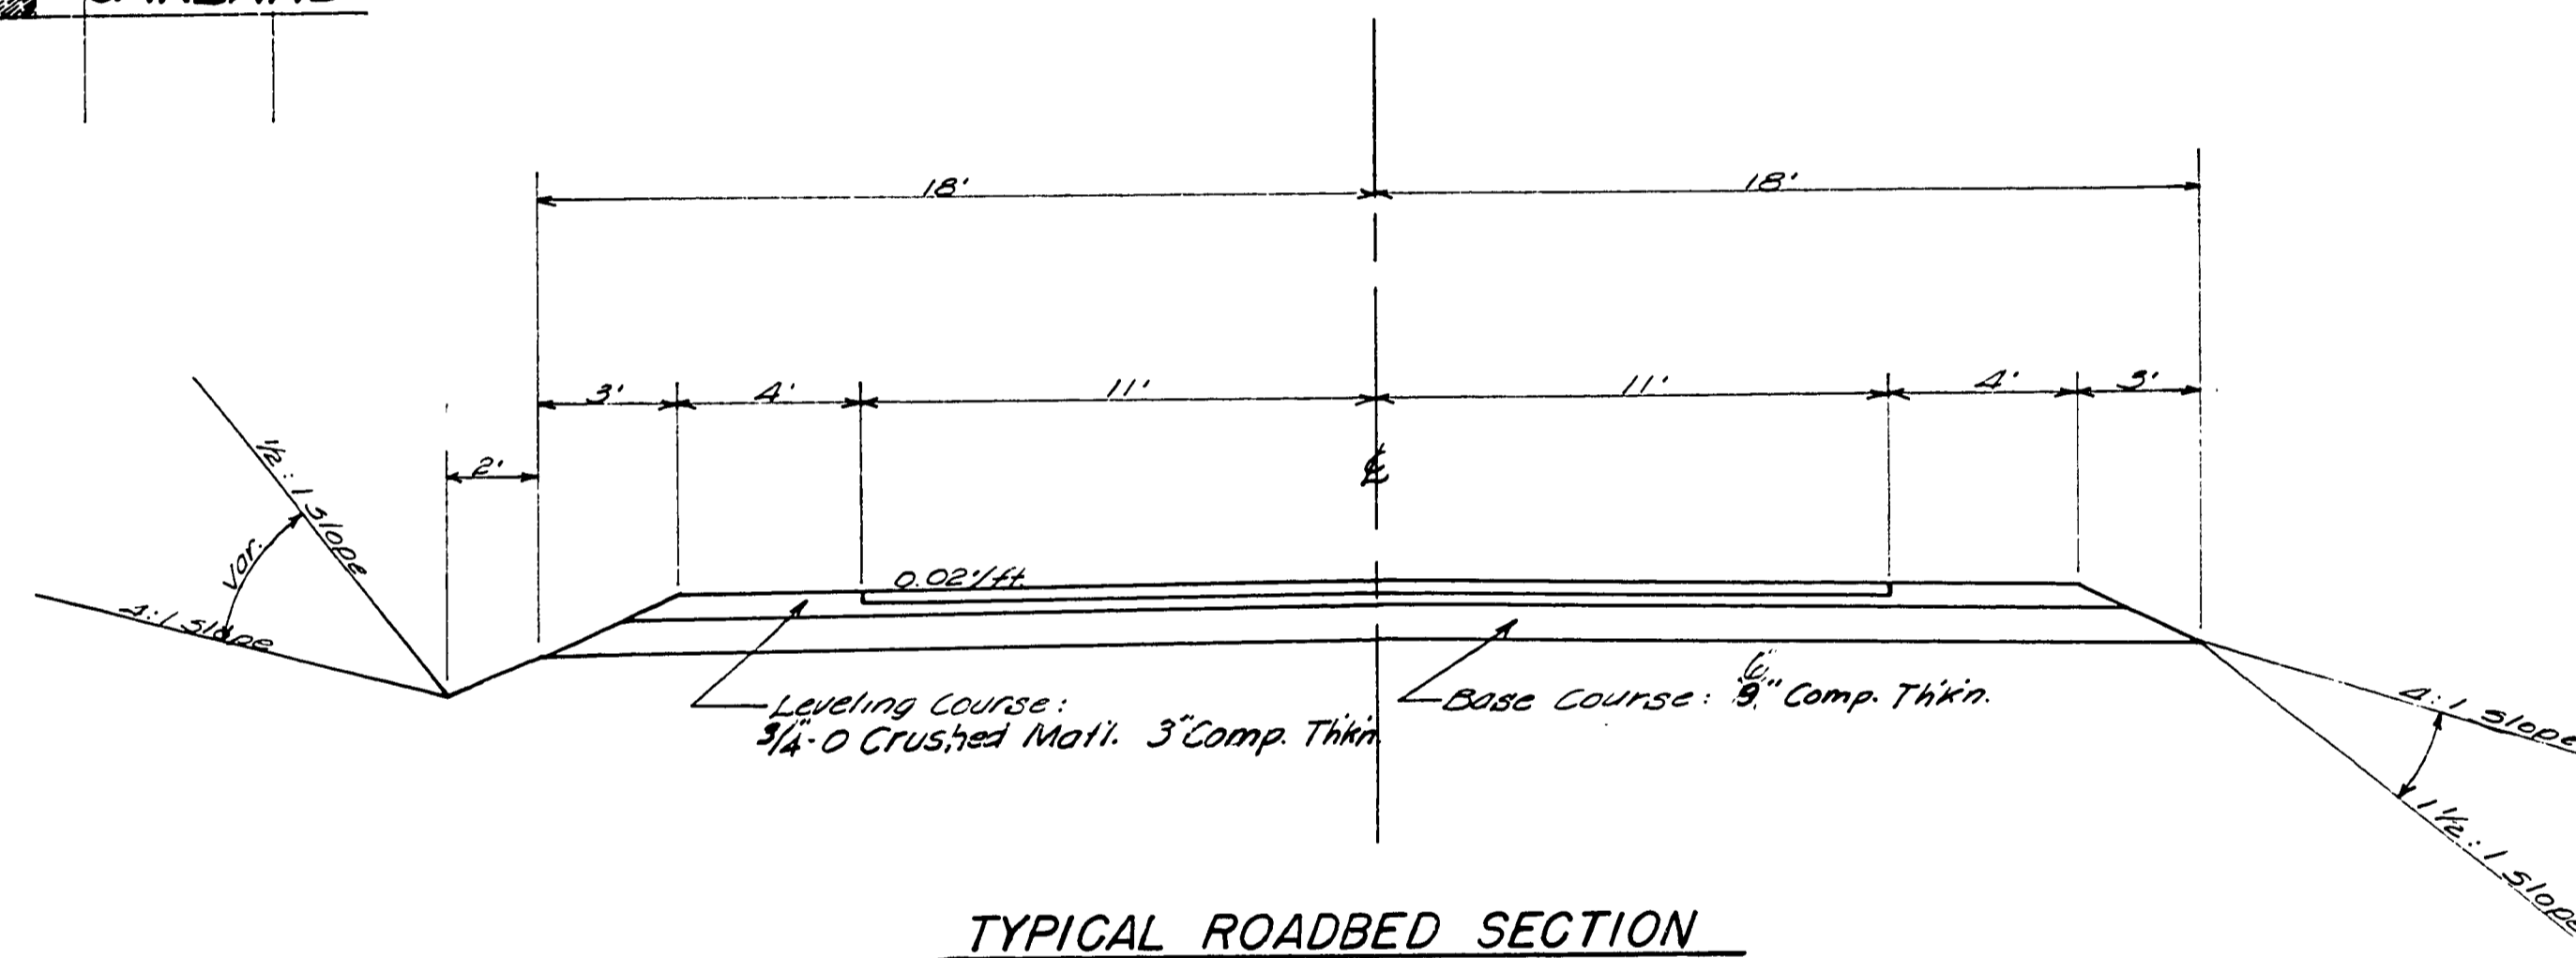

TYPICAL ROADBED SECTION



FILED  
AND  
RECEIVED  
JUN 26 1964  
COUNTY SURVEYOR  
DOUGLAS COUNTY, ORE.

MAR '63

0292001C