

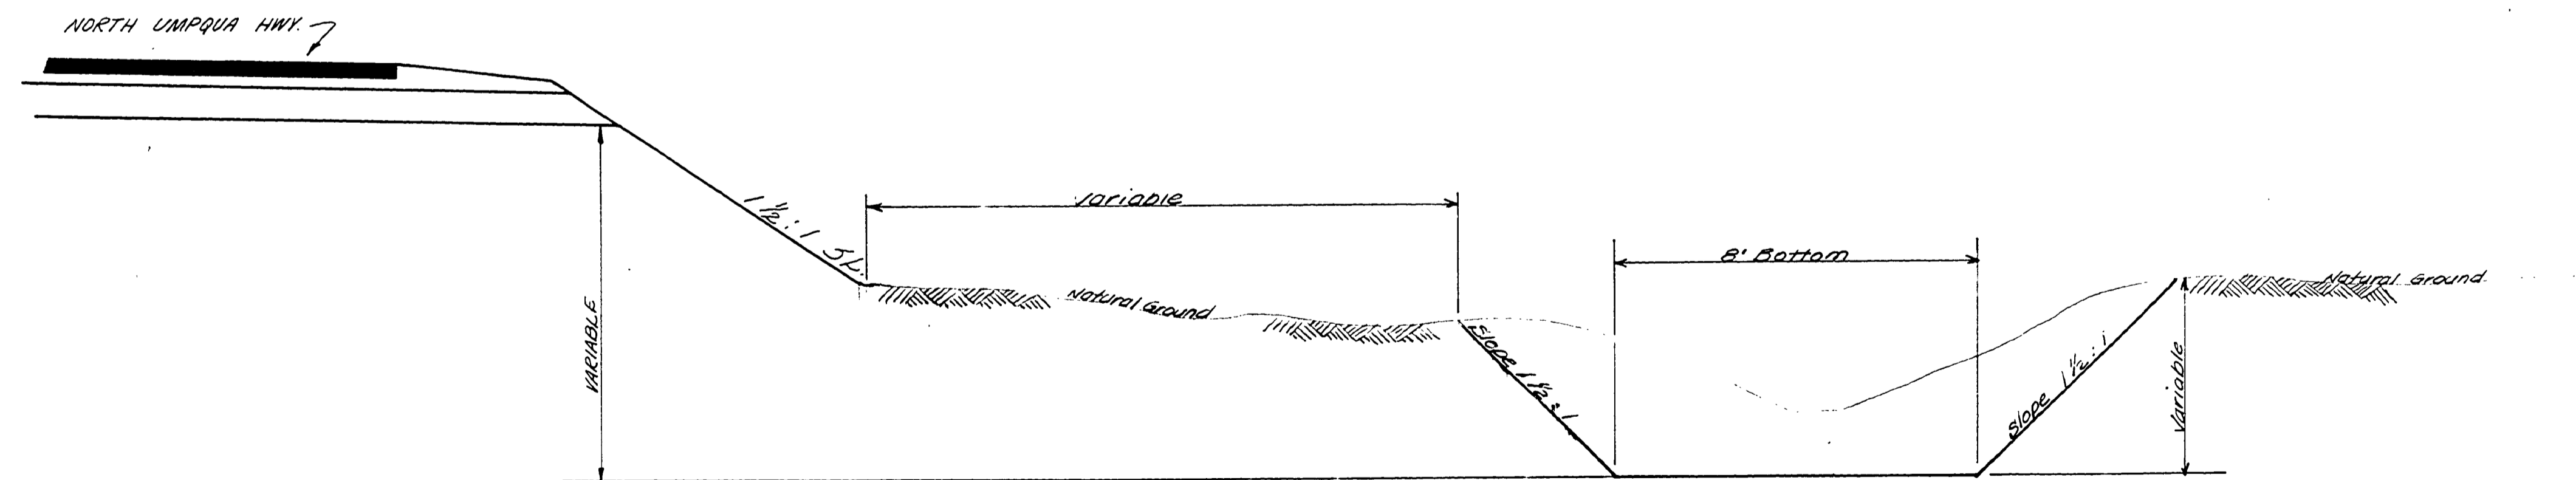


DOUGLAS COUNTY, OREGON
 PLANS FOR PROPOSED PROJECT
 AS CONSTRUCTED
SINGLETON ROAD
 COUNTY ROAD NO. 79

TYPICAL SECTIONS

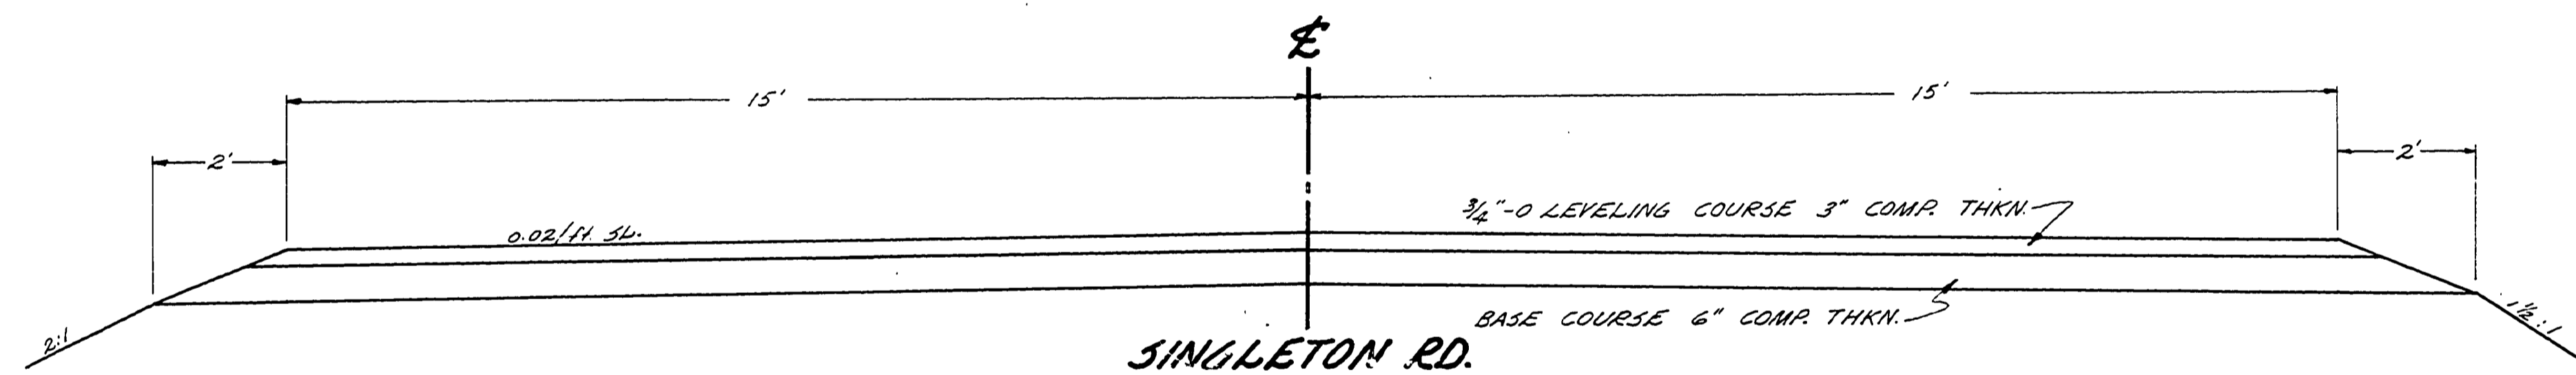

DITCH CHANGE ALONG HIGHWAY

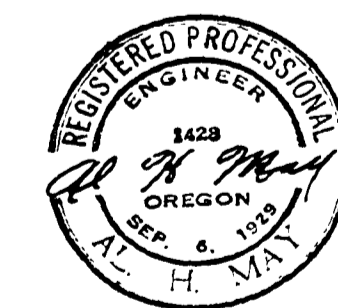

APPROVED *A. H. May* Date 7-31-1962
 COUNTY ENGINEER

Co. Rd. #79 JULY, '62
 sht. 1 of 3

0000007C