
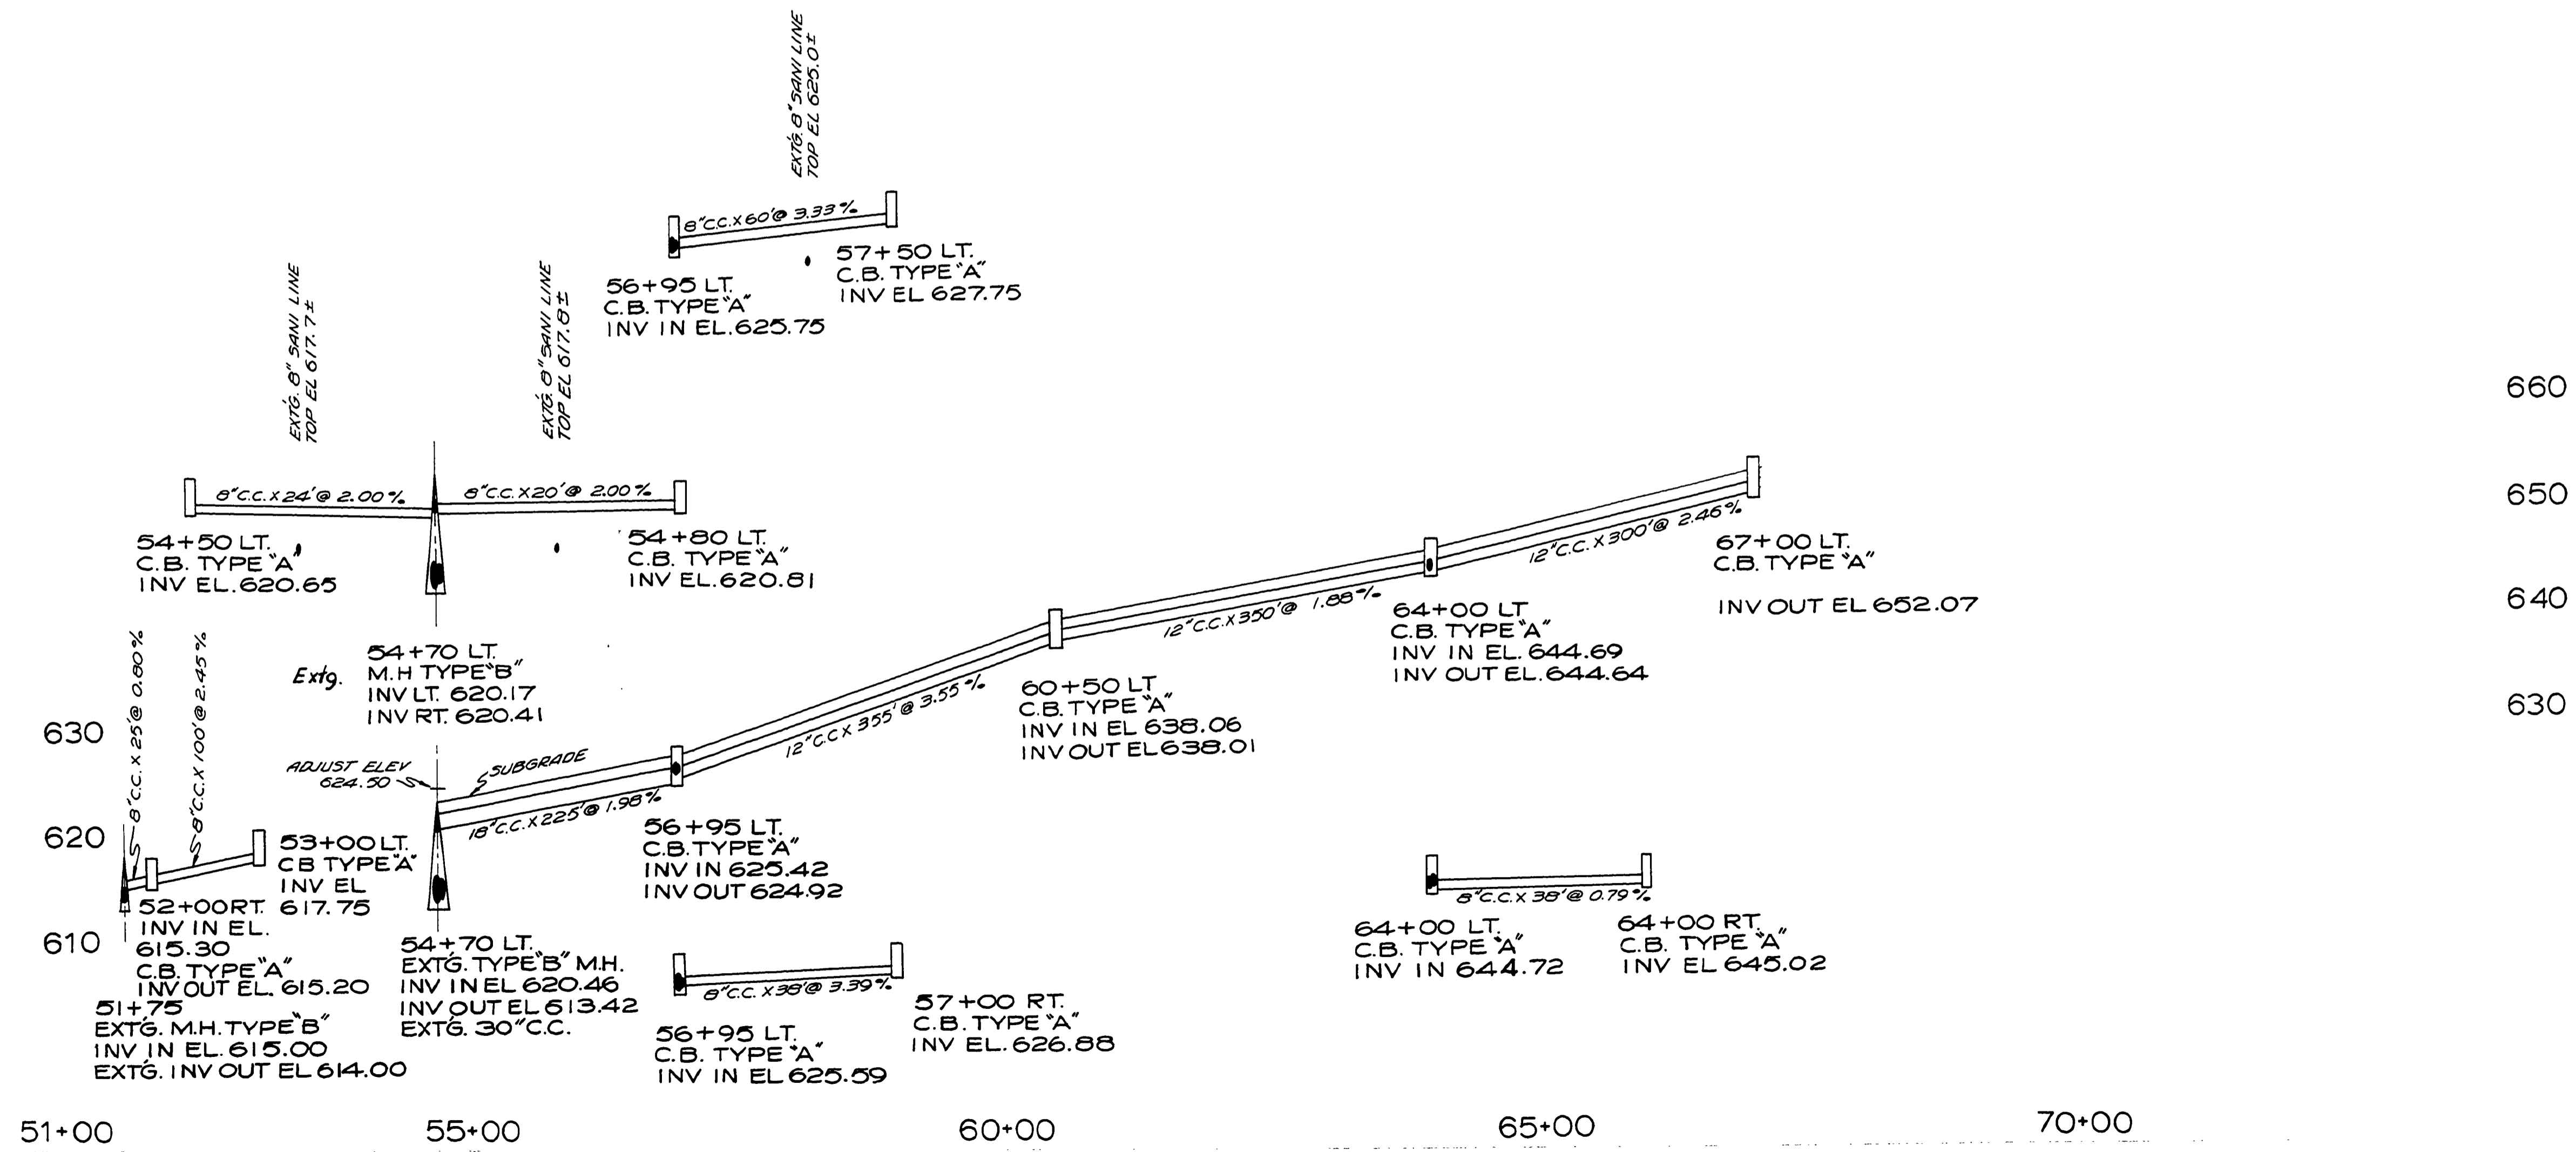


FILED  
RECORDED  
COUNTY CLERK  
DOUGLAS COUNTY, NE

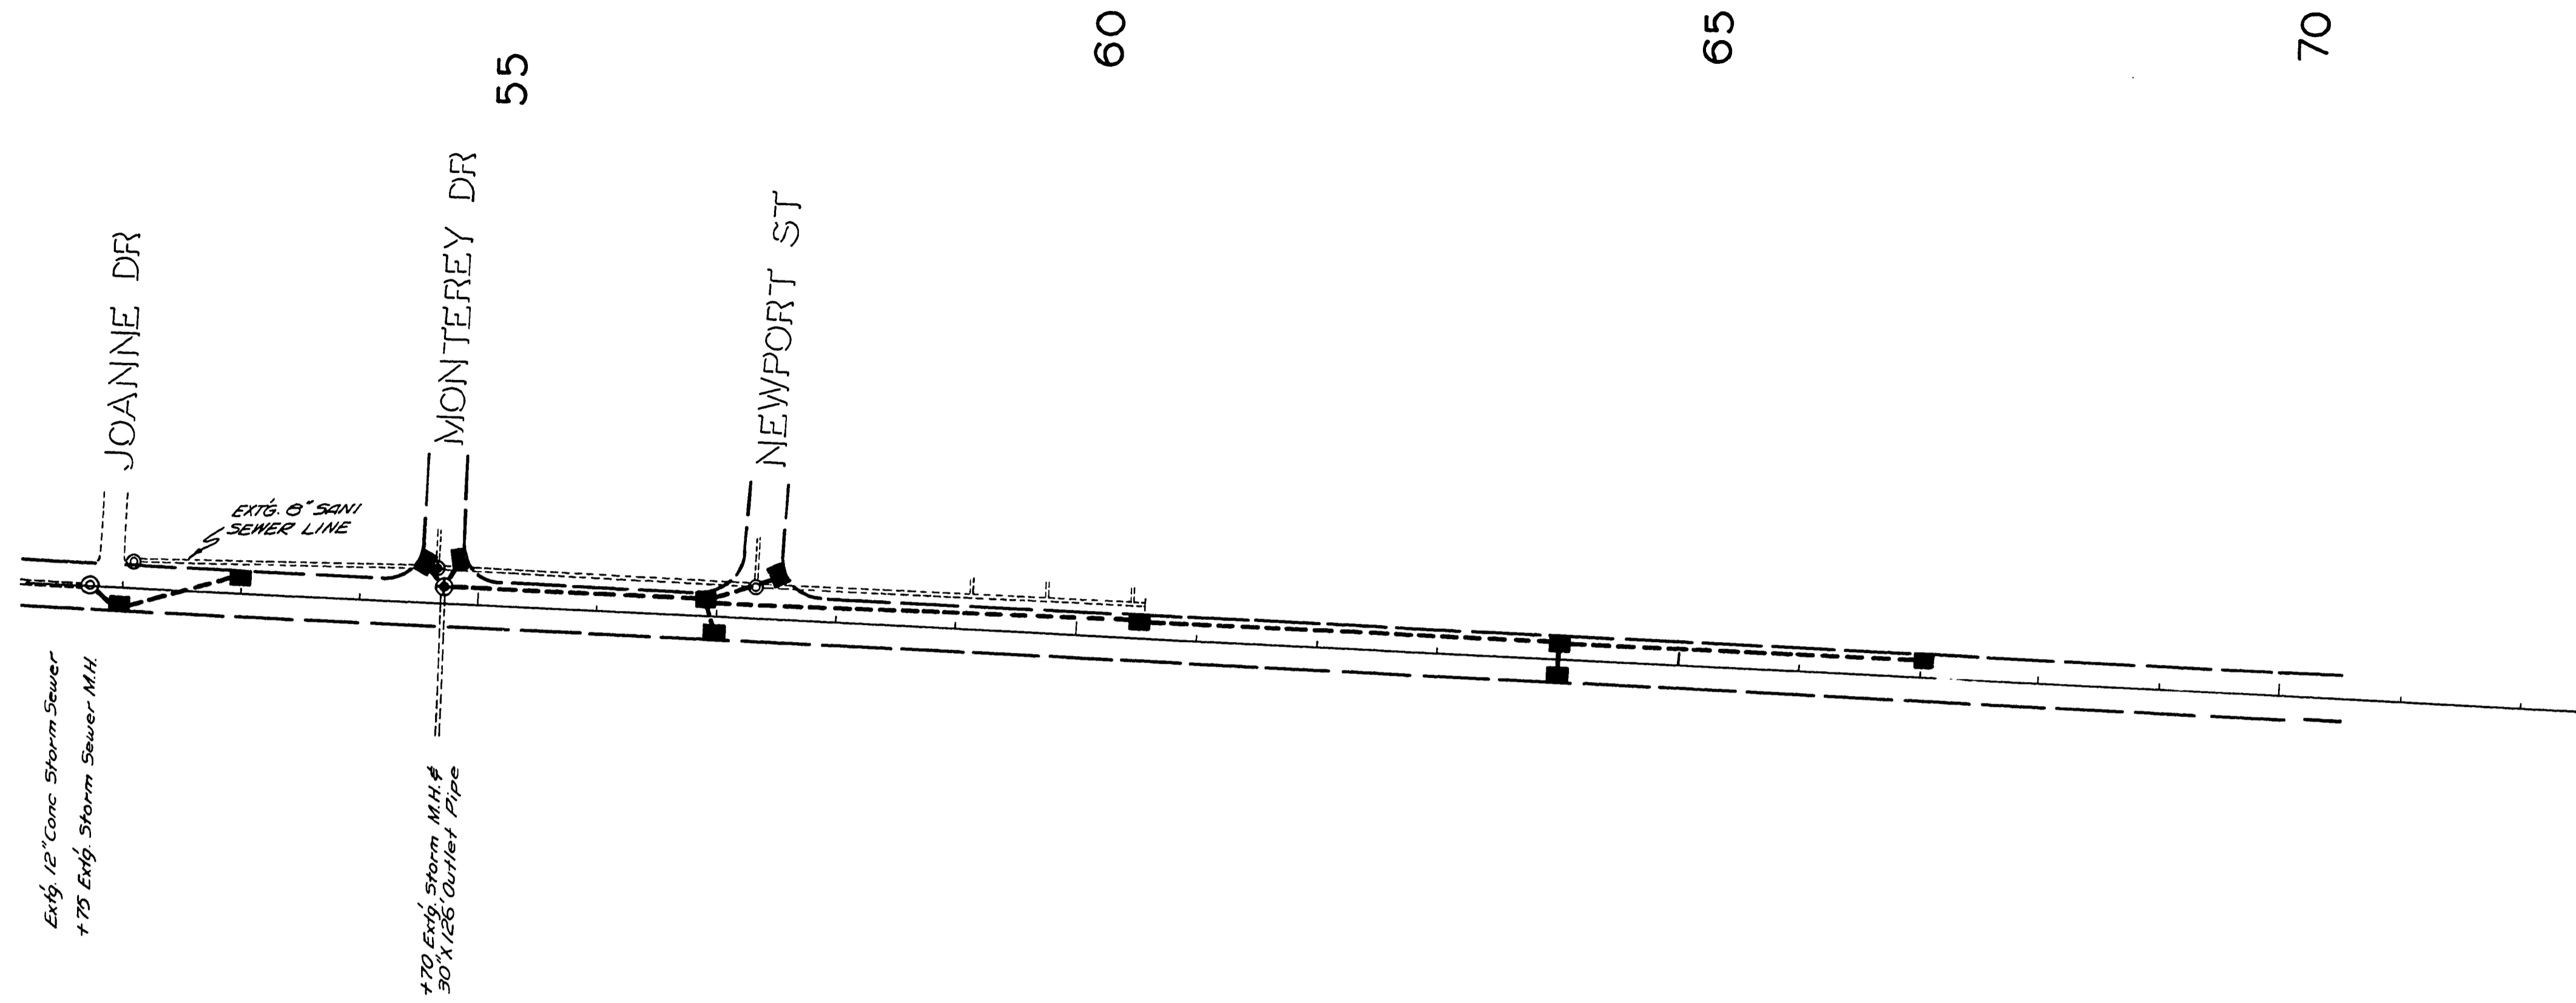

NOT REVISED  
AS CONSTRUCTED

DOUGLAS COUNTY ROAD DEPT.  
NEWTON CREEK ROAD #84  
1972 SH 5  
GEORGE E. GRUBB COUNTY ENGR.

66006800

M.P. 0.89 - 0.99

Co. Rd #84 1972  
Sht. 5 (52)